WATER LATERAL SCHEDULE:

BUILDING 1: 4" LATERAL FROM MAIN TO 2" METER VAULT. 4" FIRE & 3" DOMESTIC TO BUILDING
BUILDING 2: 4" LATERAL FROM MAIN TO 2" METER VAULT. 4" FIRE & 2" DOMESTIC TO BUILDING
BUILDING 3: 4" LATERAL FROM MAIN TO 2" METER VAULT. 4" FIRE & 2.5" DOMESTIC TO BUILDING
BUILDING 4: 4" LATERAL FROM MAIN TO 2" METER VAULT. 4" FIRE & 3" DOMESTIC TO BUILDING
BUILDING 5: 4" LATERAL FROM MAIN TO 2" METER VAULT. 4" FIRE & 3" DOMESTIC TO BUILDING
BUILDING 6: 4" LATERAL FROM MAIN TO 1" METER VAULT. 4" FIRE & 1" DOMESTIC TO BUILDING
BUILDING 7: 4" LATERAL FROM MAIN TO 1" METER VAULT. 4" FIRE & 1" DOMESTIC TO BUILDING
CLUBHOUSE: 1.5" DOMESTIC & 1" METER
MAINTENANCE BUILDING: 3/4" WATERLINE FROM BUILDING 2

*ALL METER VAULTS LOCATED WITHIN PAVEMENT SHALL BE TRAFFIC RATED, WITH TRAFFIC RATED MANHOLE ACCESS.

NOTE:
ALL ROOF DRAINS (RD) SHALL BE 8" HDPE AND MAINTAIN 2 FT MIN. COVER & 1% MIN. SLOPE UNLESS NOTED OTHERWISE.

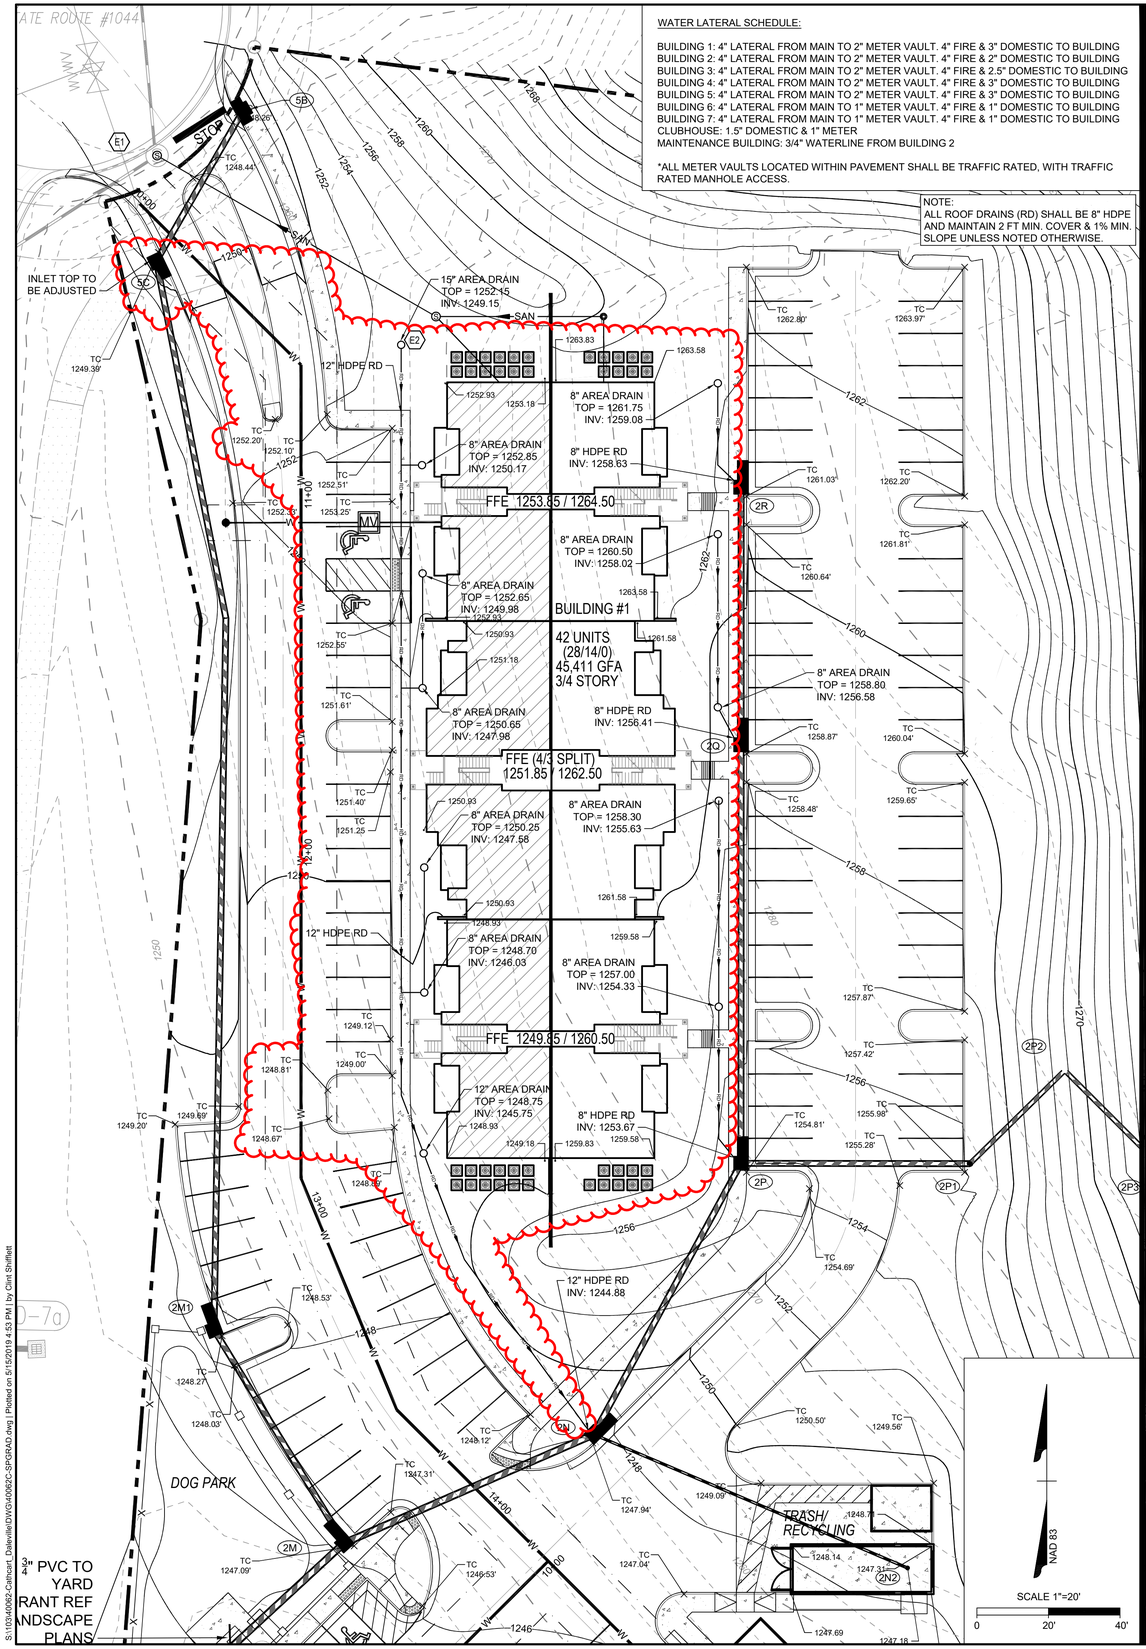

NOTE:
ALL ROOF DRAINS (RD) SHALL BE 8" HDPE UNLESS NOTED OTHERWISE. MAINTAIN 2 FT MIN. COVER & 1.0% MIN. SLOPE.

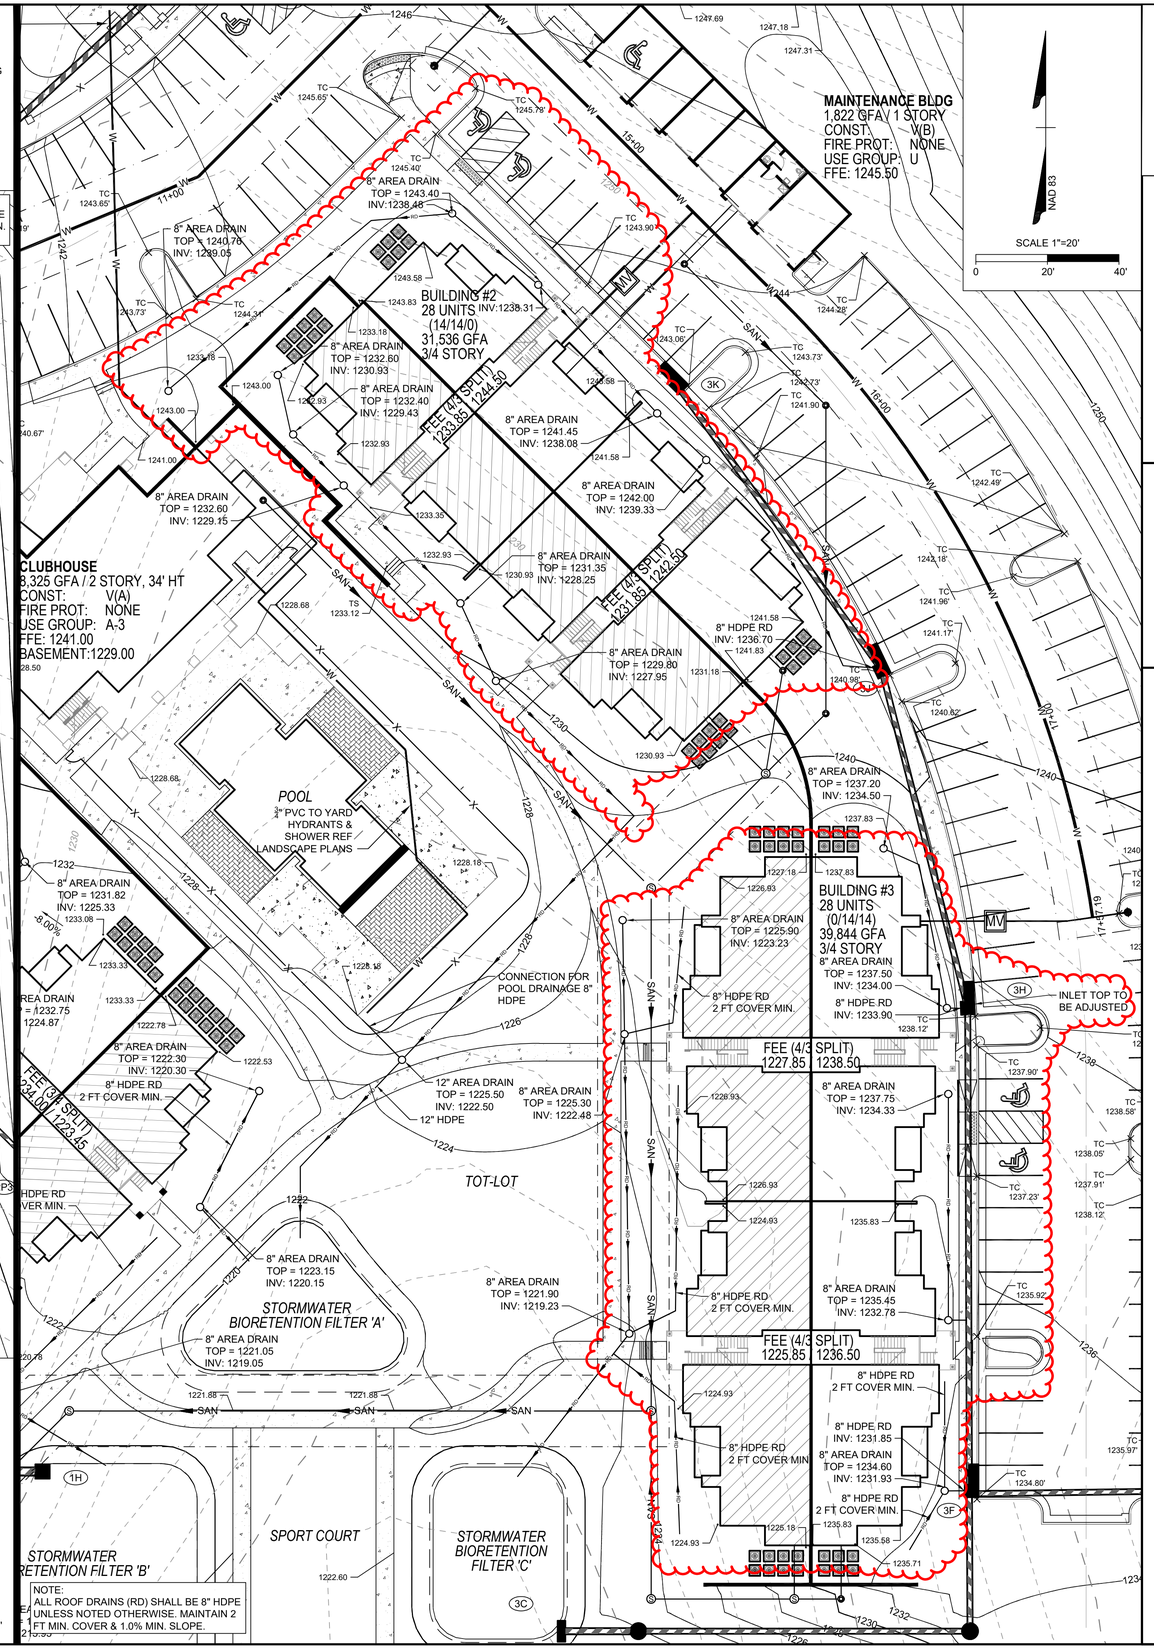

THIS DRAWING PREPARED AT THE
CHARLOTTESVILLE OFFICE
608 Preston Avenue, Suite 200 | Charlottesville, VA 22903
TEL 434.295.5624 FAX 434.295.8317 www.timmons.com

YOUR VISION ACHIEVED THROUGH OURS.

DATE	REVISION DESCRIPTION
2018-09-07	REVISED PER COMMENTS
2018-11-13	REVISED PER COUNTY COMMENTS
2018-11-27	BID SET

DATE	2018-05-23
DRAWN BY	J WILSON
DESIGNED BY	J WILSON
CHECKED BY	C SHIFFLETT
SCALE	AS SHOWN

TIMMONS GROUP

THE RESERVE AT DALEVILLE

BOTEROURT COUNTY, VA

FIELD CHANGE #3 - BUILDINGS 1-7 GRADING, WATERLINE & ROOF DRAIN

JOB NO.	SHEET NO.
40062	FC3.1

These plans and associated documents are the exclusive property of TIMMONS GROUP and may not be reproduced in whole or in part and shall not be used for any purpose whatsoever, inclusive, but not limited to construction, bidding, and/or construction staking without the express written consent of TIMMONS GROUP.

S:\110\40062\Cathcart_Daleville\DWG\40062C-SPGRAD.dwg | Plotted on 5/15/2019 4:53 PM | by Clint Shifflett