


1. PIPE LENGTHS ARE MEASURED FROM CENTER OF STRUCTURE TO CENTER OF STRUCTURE. PIPE LENGTHS ARE BASED ON THIS HORIZONTAL DISTANCE AND INVERTS ARE MEASURED AT THE FACE OF THE STRUCTURE.
2. PROVIDE CONSTRUCTION ENTRANCES PER DETAIL ON DWG. DET-2 AT ALL PROJECT ACCESS POINTS TO PREVENT THE TRANSPORT OF SEDIMENT OFF OF THE PROJECT SITE.
3. ALL PROJECT LAYDOWN AREAS SHALL BE GRAVEL AND COMPLY WITH THE LATEST EDITION OF THE VIRGINIA EROSION AND SEDIMENT CONTROL HANDBOOK.

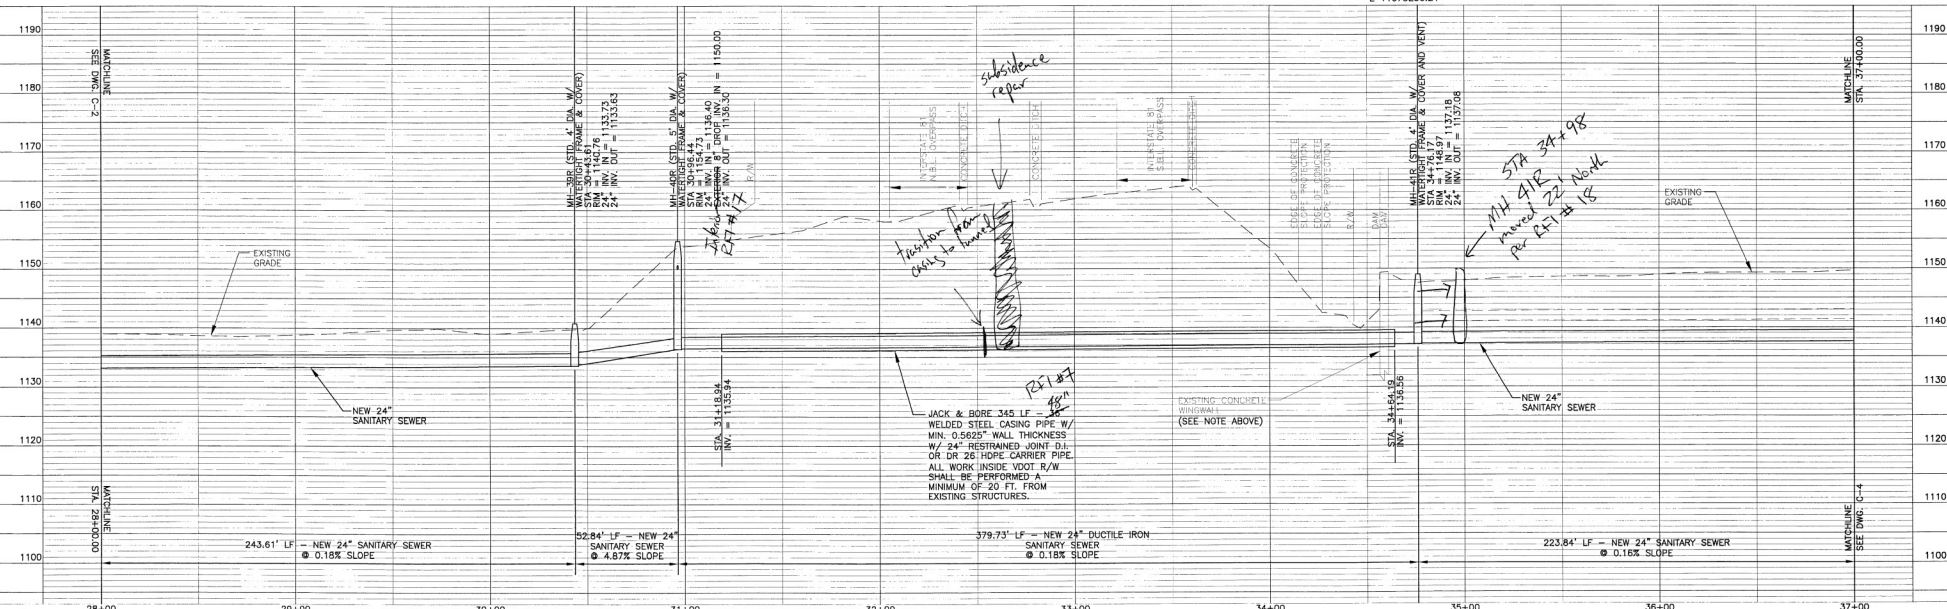

\\211036.02 Botetourt County Tinker Creek Interceptor\dwg\1036C-3.dwg