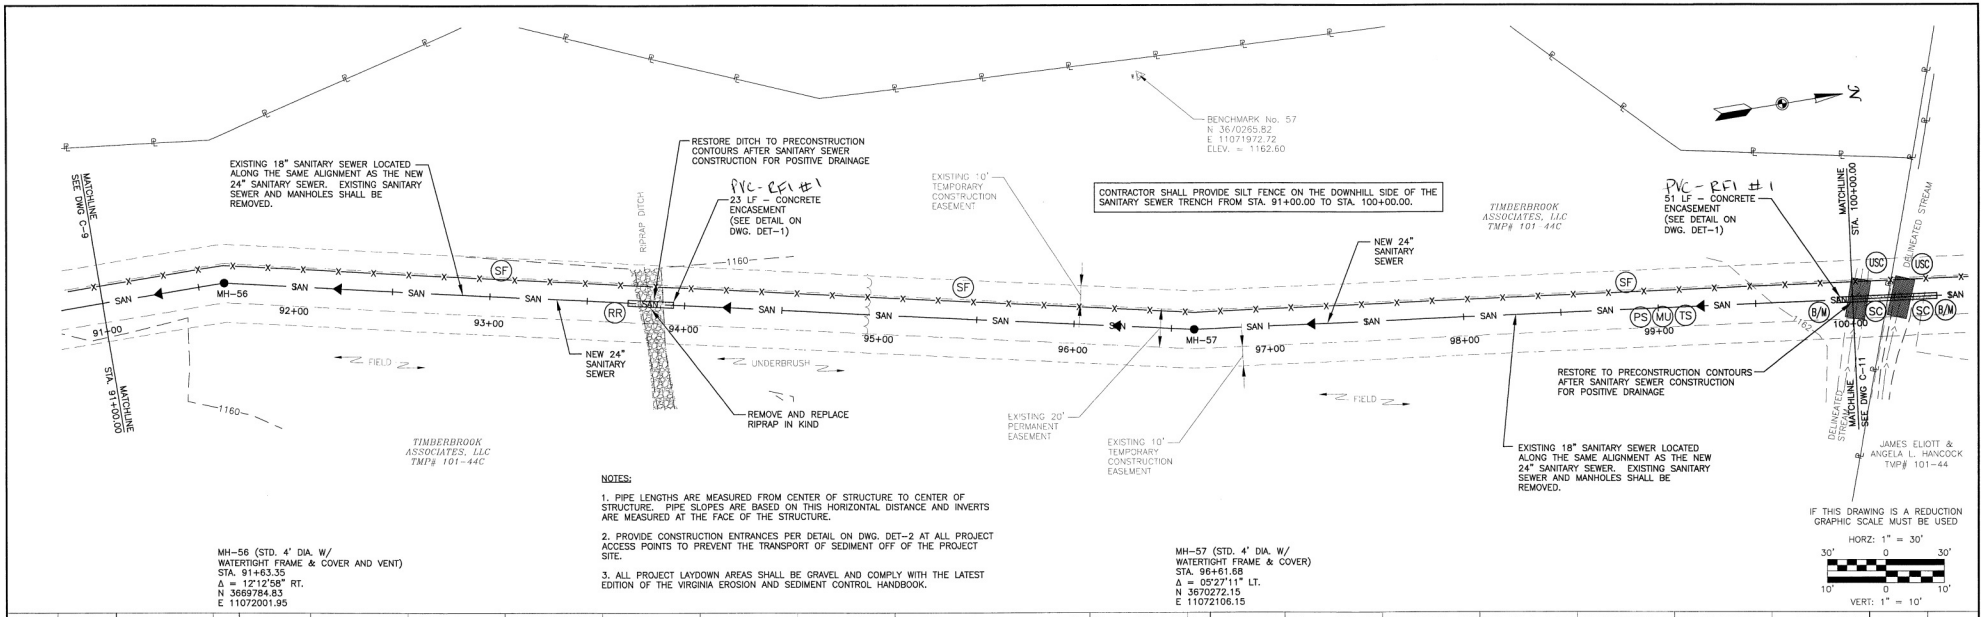

NOTES:

1. PIPE LENGTHS ARE MEASURED FROM CENTER OF STRUCTURE TO CENTER OF STRUCTURE. PIPE SLOPES ARE BASED ON THIS HORIZONTAL DISTANCE AND INVERTS ARE MEASURED AT THE FACE OF THE STRUCTURE.

2. PROVIDE CONSTRUCTION ENTRANCES PER DETAIL ON DWG. DET-2 AT ALL PROJECT ACCESS POINTS TO PREVENT THE TRANSPORT OF SEDIMENT OFF OF THE PROJECT SITE.

3. ALL PROJECT LAYDOWN AREAS SHALL BE GRAVEL AND COMPLY WITH THE LATEST EDITION OF THE VIRGINIA EROSION AND SEDIMENT CONTROL HANDBOOK.

MH-56 (STD. 4' DIA. W/ WATERTIGHT FRAME & COVER AND VENT)
STA. 91+63.35
Δ = 12°12'58" RT.
N 3669784.83
E 11072001.95

MH-57 (STD. 4' DIA. W/ WATERTIGHT FRAME & COVER)
STA. 96+61.68
Δ = 05°27'11" LT.
N 3670272.15
E 11072106.15

IF THIS DRAWING IS A REDUCTION GRAPHIC SCALE MUST BE USED

HORZ: 1" = 30'

30' 0 30'

VERT: 1" = 10'

10' 0 10'

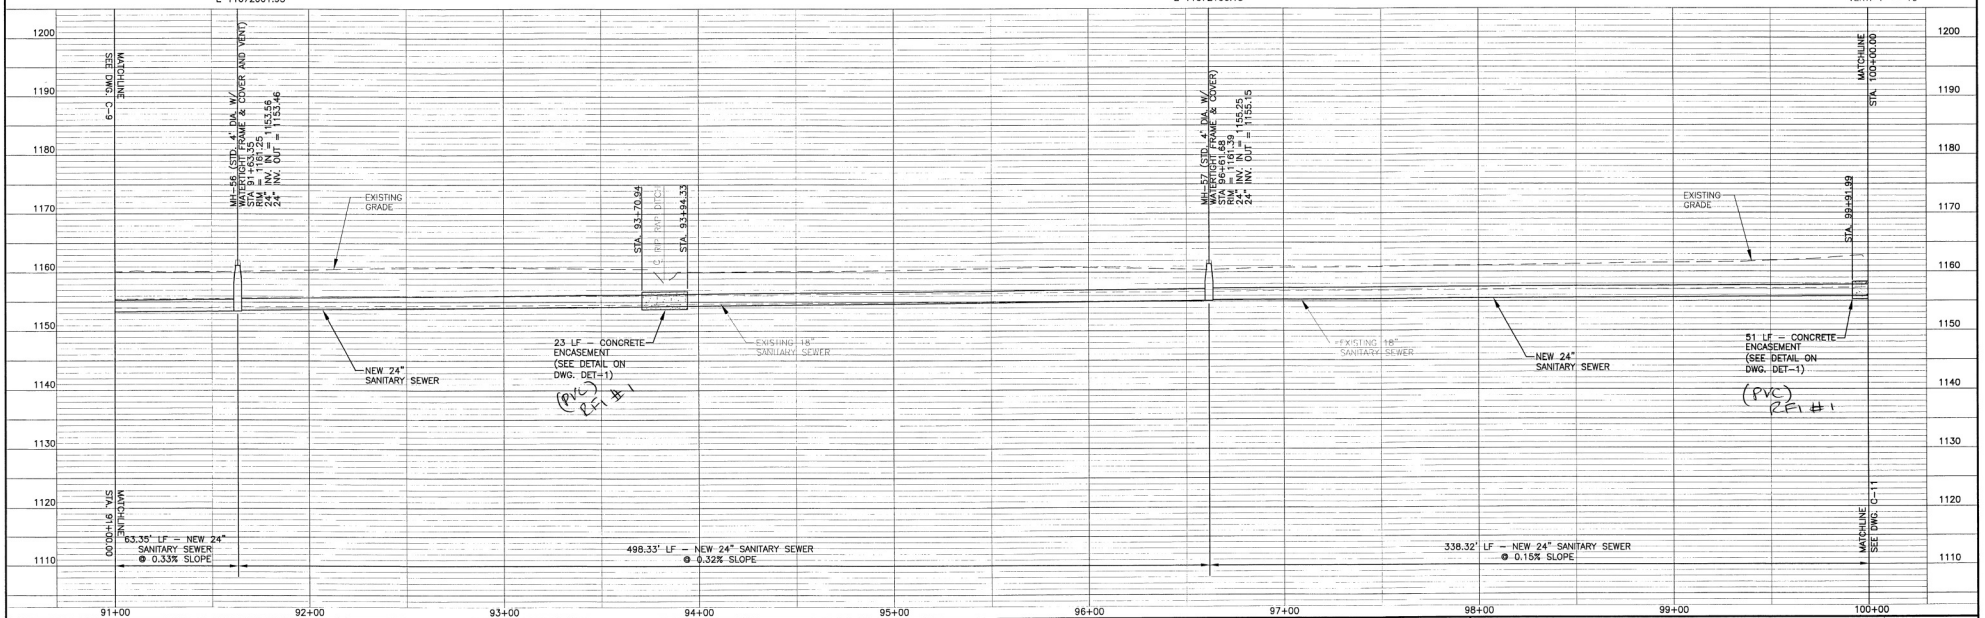

NO.	REVISION	BY	DATE
1	ADDED NOTE TO PROVIDE SILT FENCE PER ADDENDUM	WSW	1/27/12

COMMONWEALTH OF VIRGINIA
JASON A. CLARK
Lic. No. 33605
1/27/2012
PROFESSIONAL ENGINEER

ISSUED FOR CONSTRUCTION
JANUARY 27, 2012

WW ASSOCIATES
ENGINEERS SURVEYORS PLANNERS
P.O. Box 4119, Lynchburg, VA 24502, Phone: 434.316.6080
3040 Avenues Square Pl., Charlottesville, VA 22911, Phone: 434.984.2500
www.wwassociates.com

DESIGNED BY:	JMF/JAC
DRAWN BY:	WSW/CLP
CHK BY:	EJTP
WWA NUMBER:	211036.02
FILE NAME:	1036C-10.dwg
DISCIPLINE:	CIVIL
SCALE: H: AS NOTED V:
DATE:	7-15-11

PROJECT:
BOTETOURT COUNTY, VIRGINIA
PHASE I TINKER CREEK
SANITARY SEWER INTERCEPTOR IMPROVEMENTS

TITLE:
NEW SANITARY SEWER – PLAN AND PROFILE
STA. 91+00.00 TO STA. 100+00.00

REVISION SET: 2
DRAWING NUMBER: C-10
SHEET NUMBER: 12 OF 23

M:\211036.02 Botetourt County Tinker Creek Interceptor\dwg\1036C-10.dwg