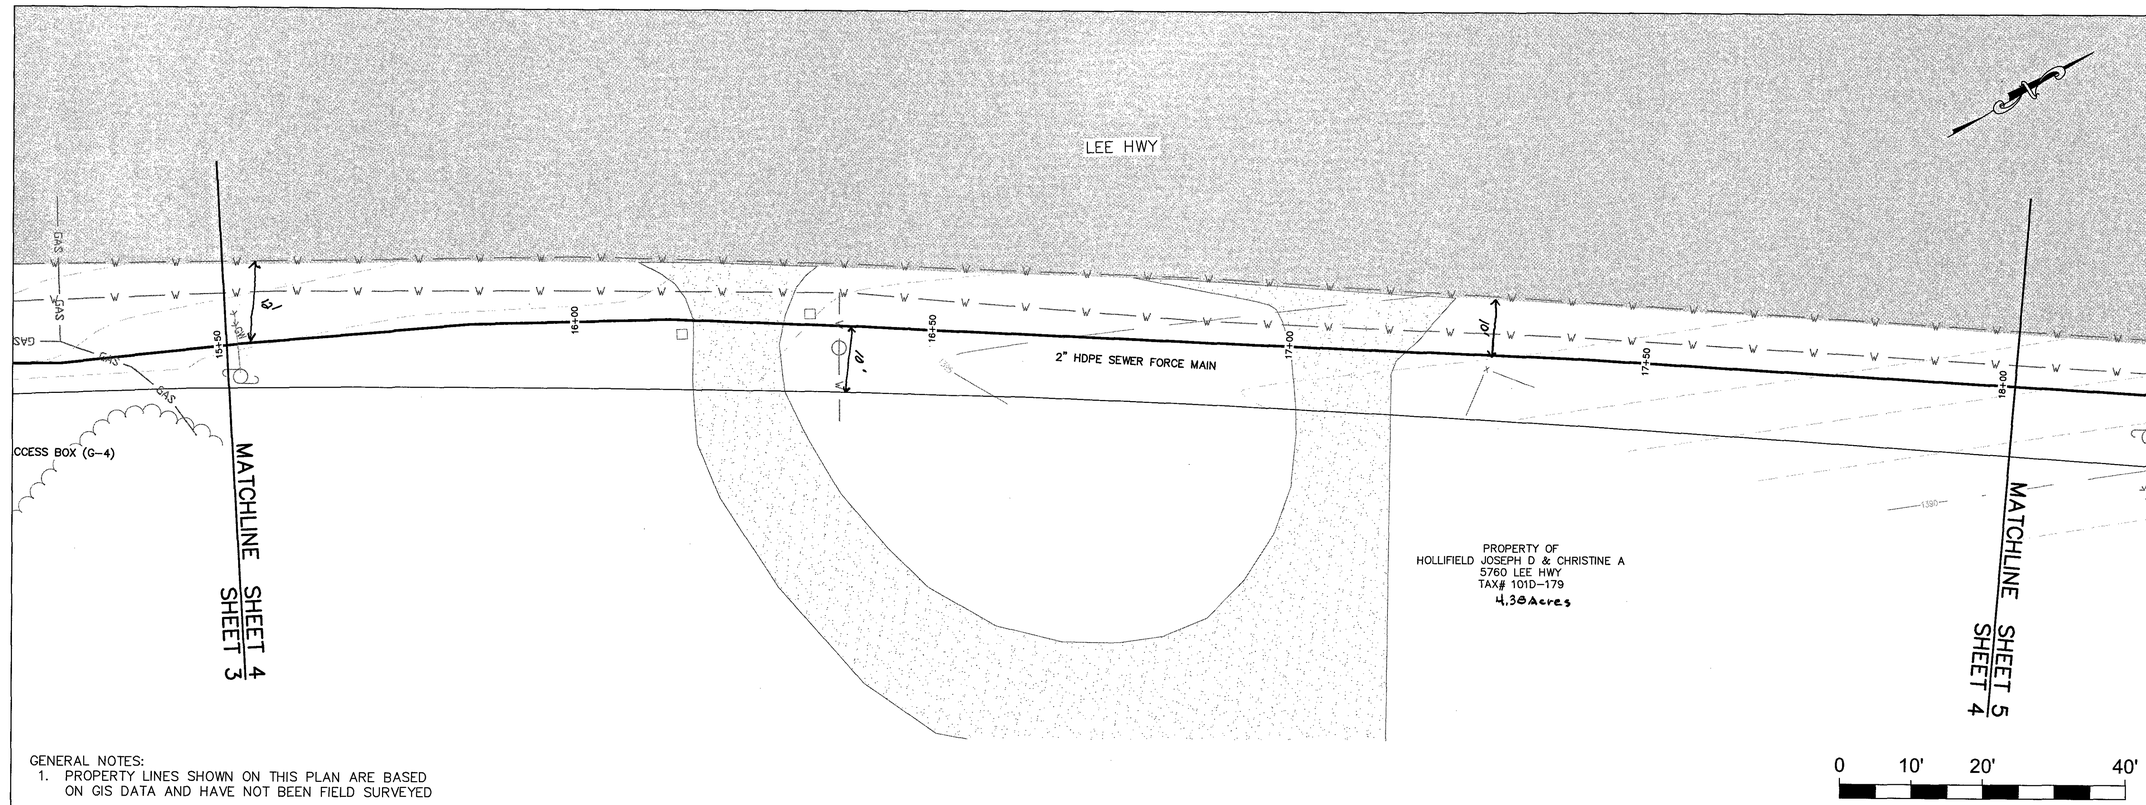

GENERAL NOTES:
1. PROPERTY LINES SHOWN ON THIS PLAN ARE BASED ON GIS DATA AND HAVE NOT BEEN FIELD SURVEYED

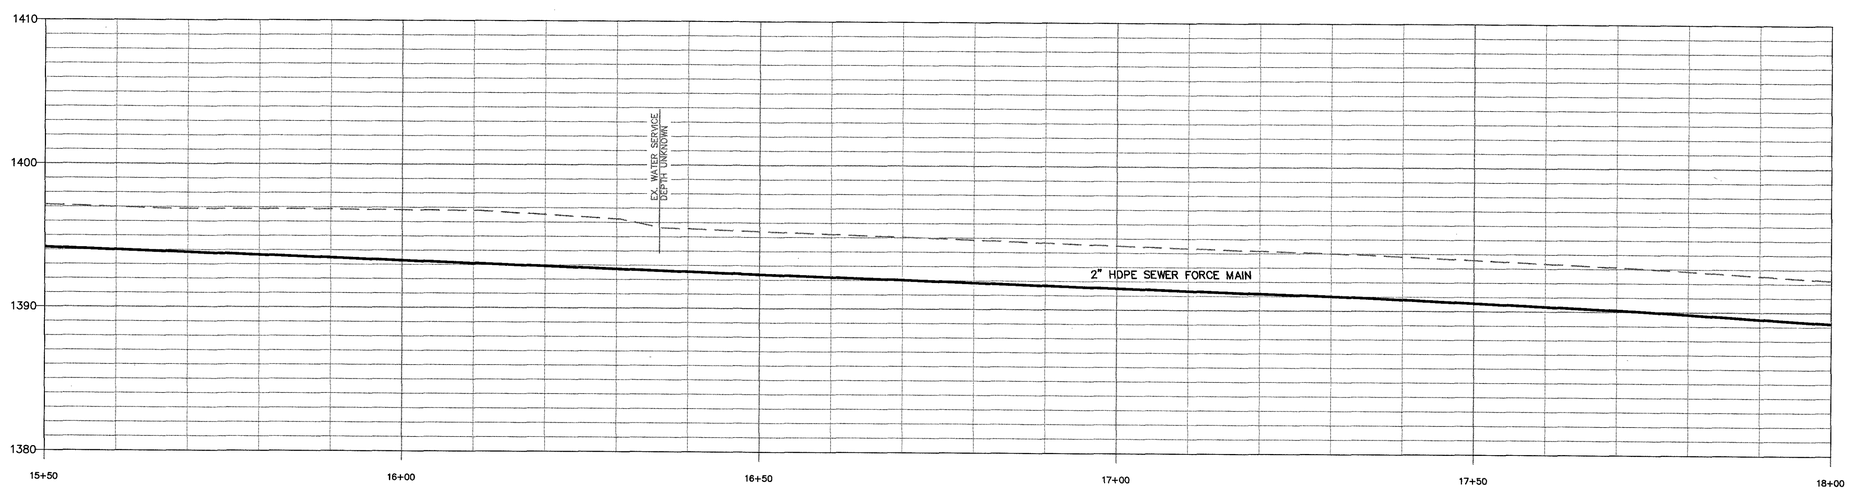

SEWER FORCEMAIN "A"

SCALE
VERTICAL: 1"= 5'
HORIZONTAL: 1" = 10'

WESTERN VIRGINIA WATER AUTHORITY
ENGINEERING SERVICES
601 S JEFFERSON ST, SUITE 300
ROANOKE, VA 24011
540-853-5700

5832 LEE HIGHWAY SEWER FORCEMAIN

TOWN OF TROUTVILLE, VA
PLAN & PROFILE

Rev	Description	Date	By

Designed: DRJ
Drawn: DRJ
Checked: FOPS
Approved: TEC
Date: AUG 2018
Project: CUST. EXT.

4

Sheet 4 of 5