


PROJECT MANAGER: Brian Becker, PE (540) 378-5049 (Solem)
SURVEYED BY: Richard Zlams, L.S. (703) 631-5325 (Burgess & Niple)
DESIGN SUPERVISED BY: J. Scott Hodge, PE (540) 857-3322 (AECOM)
DESIGNED BY: Craig Riddle, PE (540) 857-3369 (AECOM)

HORIZONTAL SCALE: 1" = 25'
VERTICAL SCALE: 1" = 10'

REVISED	STATE	ROUTE	PROJECT	SHEET NO.
	VA.	11	0081-011-120, PE-102 RW-202, C-502	18(3A)

DESIGN FEATURES RELATING TO CONSTRUCTION
OR TO REGULATION AND CONTROL OF TRAFFIC
MAY BE SUBJECT TO CHANGE AS DEEMED
NECESSARY BY THE DEPARTMENT

AECOM TECH. SERV., INC.
ROANOKE, VIRGINIA
UTILITIES ENGINEER

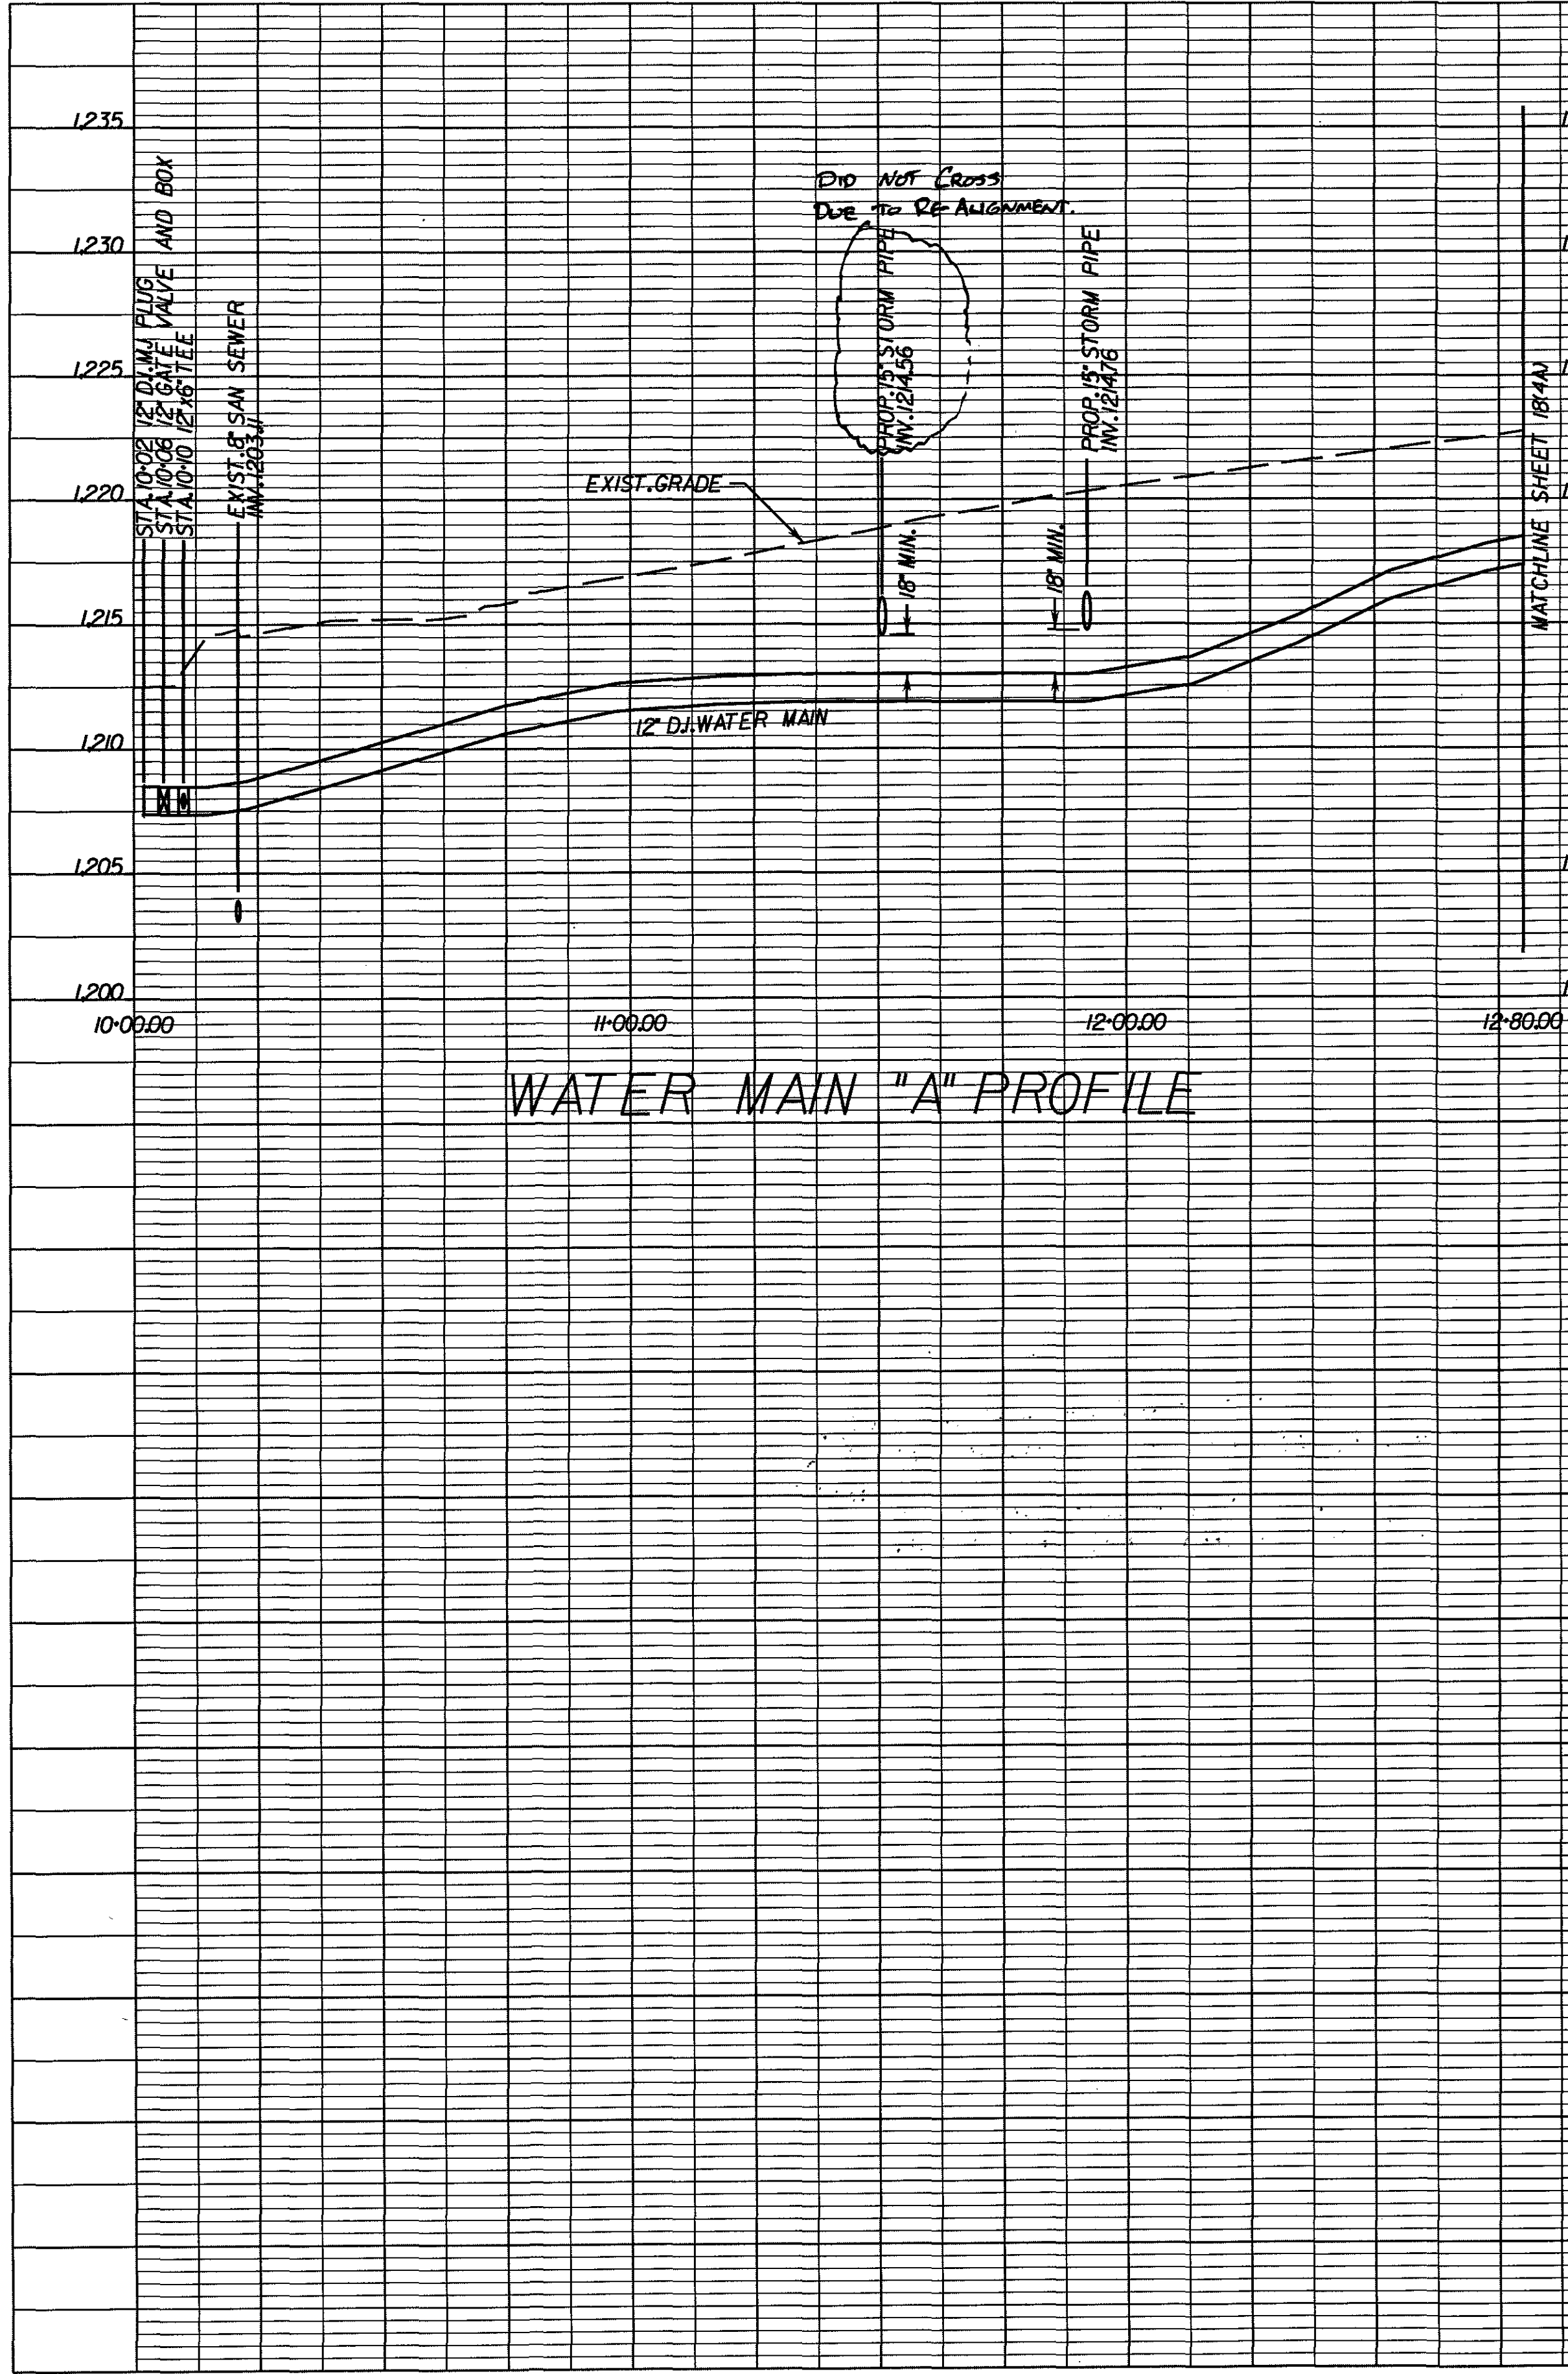

Not Installed as shown
See Sheet 18(3A)

VOID

PROJECT
0081-011-120

SHEET NO.
18(3A)