


PROJECT MANAGER: Mohammad Zaid, PE (540) 387-5374 (Salem)
SURVEYED BY: Richard Zlams, L.S. (203) 631-5325 (Burgess & Niple)
DESIGN SUPERVISED BY: J. Scott Hodge, PE (540) 857-3322 (AECOM)
DESIGNED BY: Craig S. Riddle, PE (540) 857-3369 (AECOM)


Plotted By: gearhart
By Resolution of Commonwealth Transportation Board dated July 18, 2012

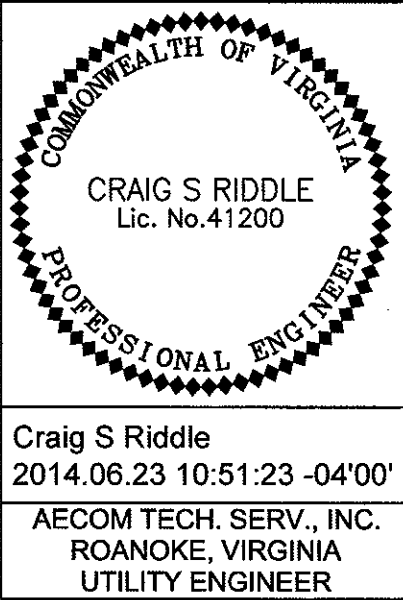

REVISED	STATE	ROUTE	PROJECT	SHEET NO.
	VA.	11	0081-011-120, PE-102 RW-202, C-502	18(4D)

DESIGN FEATURES RELATING TO CONSTRUCTION OR TO REGULATION AND CONTROL OF TRAFFIC MAY BE SUBJECT TO CHANGE AS DEEMED NECESSARY BY THE DEPARTMENT

Craig S. Riddle
2014.06.23 10:51:23 -04'00'
AECOM TECH. SERV., INC.
ROANOKE, VIRGINIA
UTILITY ENGINEER

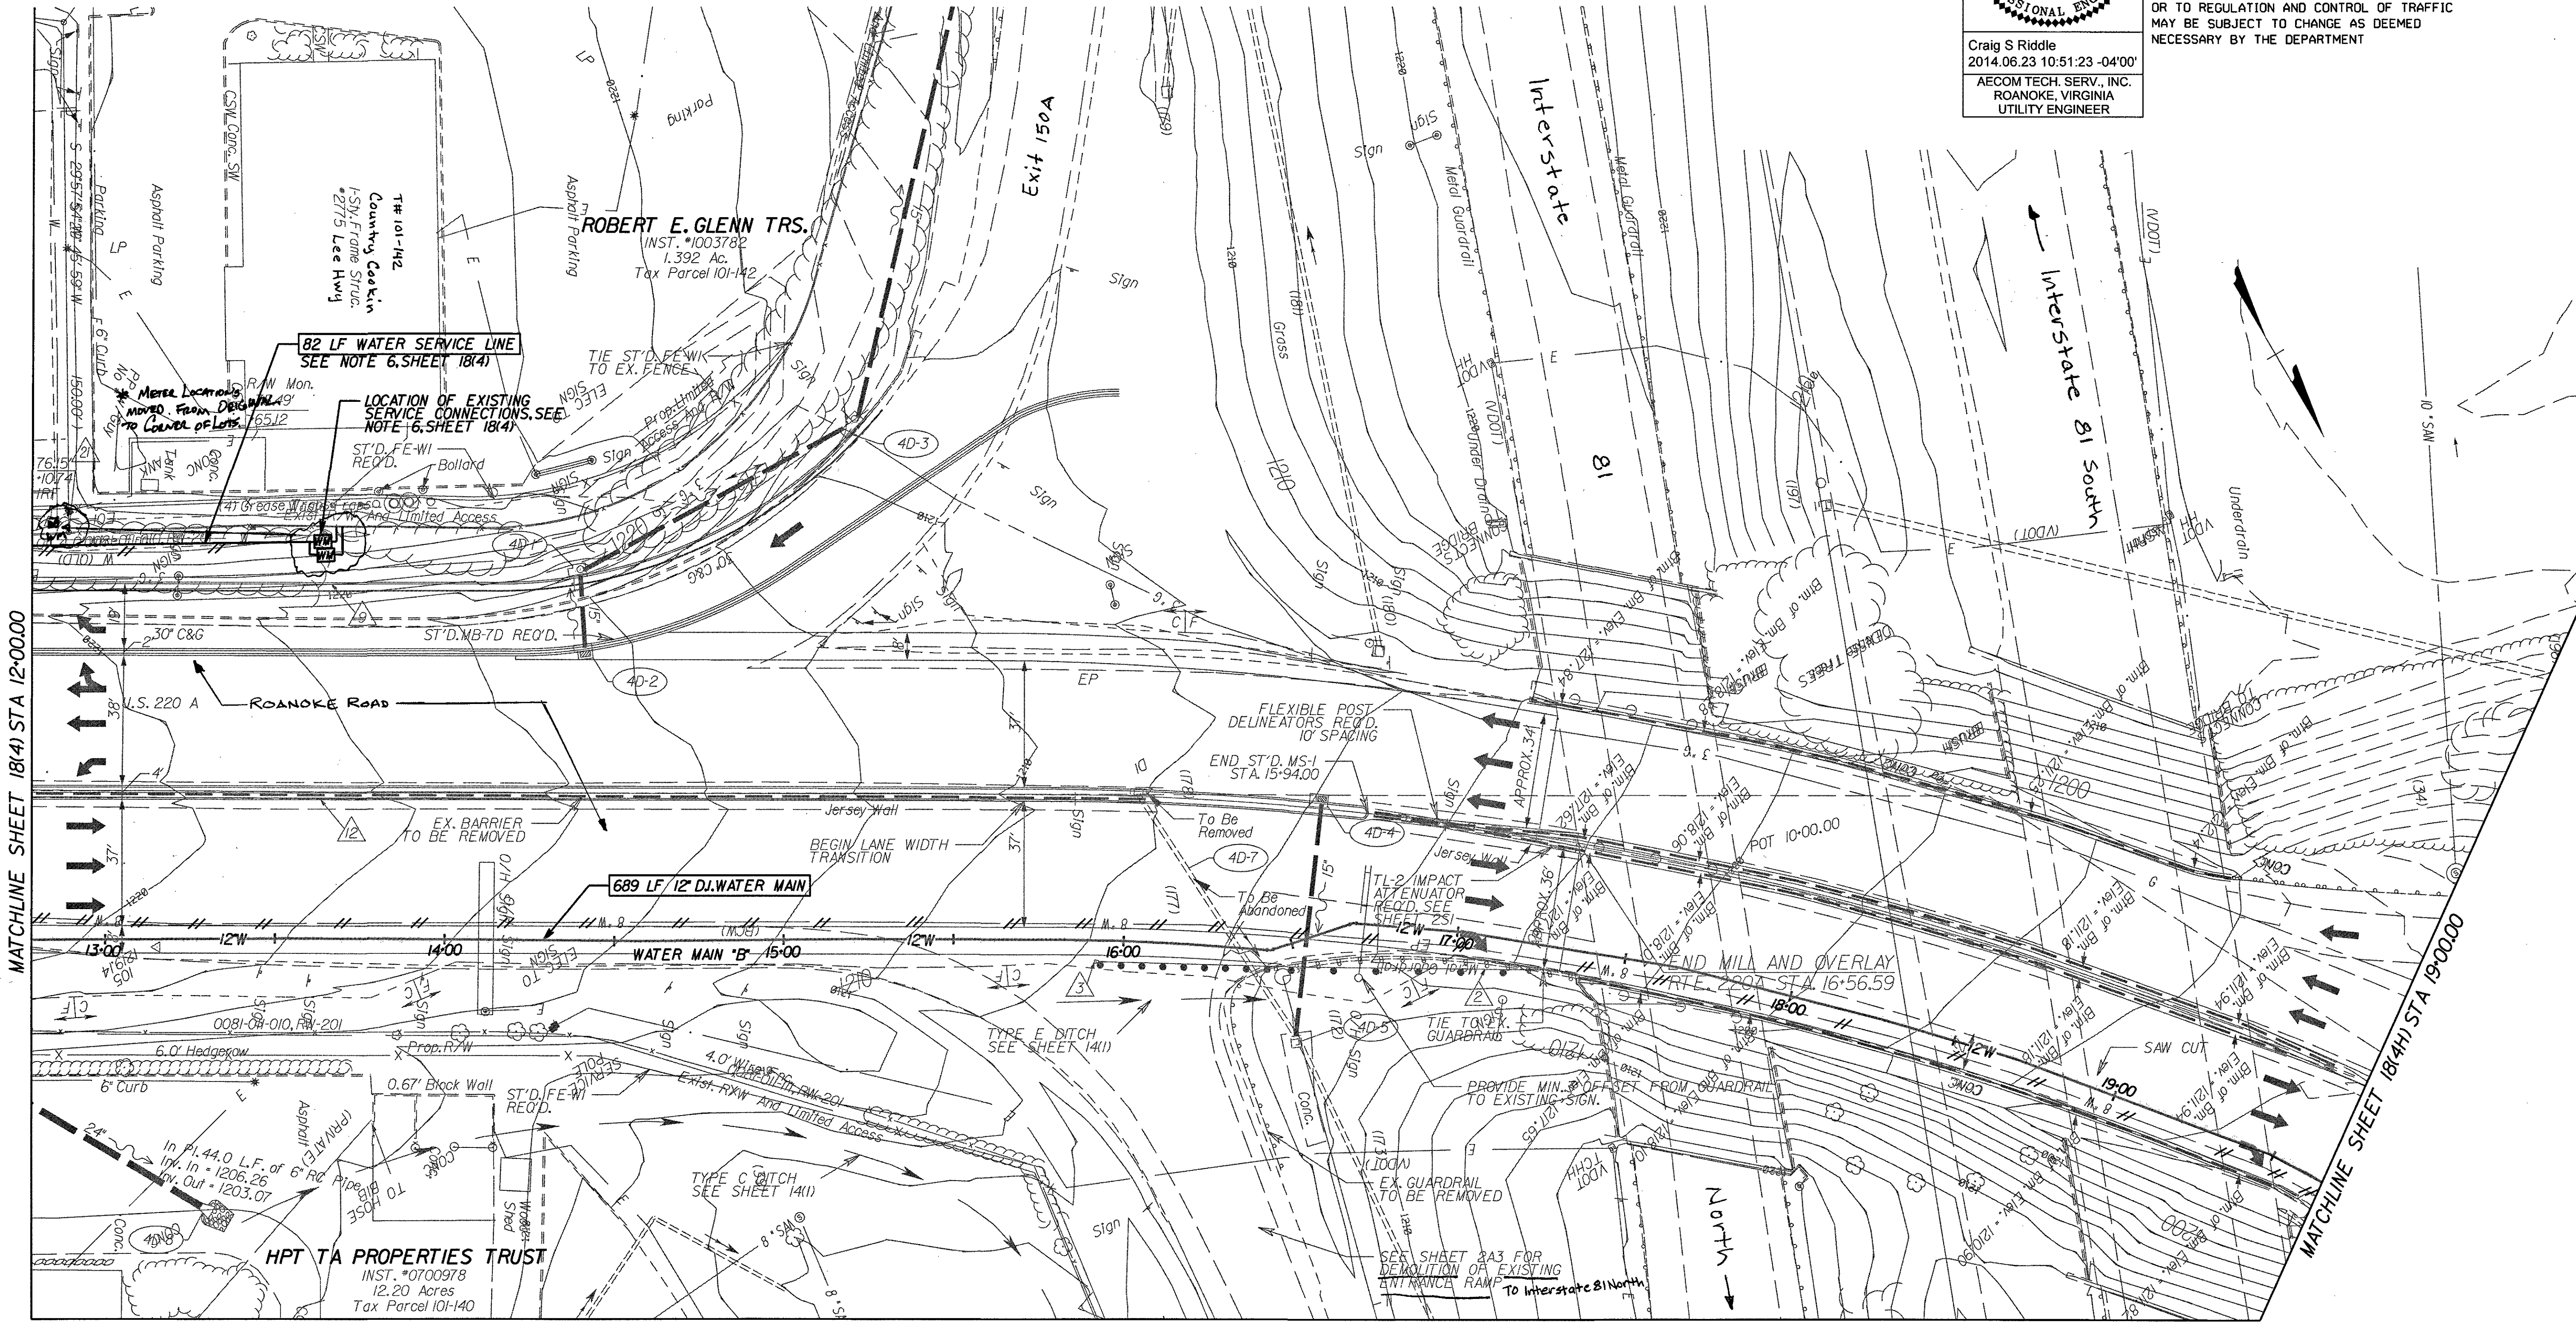


REFERENCES
(PROFILES, DETAIL & DRAINAGE
DESCRIPTION SHEETS, ETC.)

WATER MAIN
PROFILE 18(4DA)

LEGEND:
BOTETOURT COUNTY WATER METER AND PRV
// UTILITY TO BE ABANDONED

MATERIAL WATERLINE
- AMERICAN CLASS 350 DIP 12"
- ENDOT 2" HDPE

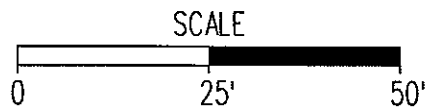

PROJECT
0081-011-120

SHEET NO.
18(4D)