

CRAIG S RIDDLE
Lic. No. 41200

COMMONWEALTH OF VIRGINIA
PROFESSIONAL ENGINEER


Craig S Riddle
2015.10.07
16:05:10 -04'00'

AECOM TECH. SERV., INC.
ROANOKE, VIRGINIA
UTILITY ENGINEER

REVISED	STATE	STATE		SHEET NO.
10-9-2015		ROUTE	PROJECT	
	VA.	11	0081-011-120, PE-102 RW-202, C-502	18(6)

3153 Lee Hwy
T# 101-1398
Cracker Barrel Old Country
Store (#28)

1. REPLACE EXISTING SAN. SEWER MH WITH PROPOSED SAN. SEWER MH PER DETAIL.
2. PROVIDE RESTRAINED JOINT PIPE WITH VDOT UB-1 CONCRETE ENCASEMENT FOR SANITARY SEWER PIPE BETWEEN SANITARY SEWER MH 186G-2 AND 186G-3.
3. ENSURE EXISTING 2-INCH WATER LINE IS NOT PROVIDING SERVICE POST CONSTRUCTION, IF VERIFIED, THEN ABANDON 2-INCH WATER LINE AS INDICATED, AND REMOVE RESTRAINED PLUG AND REACTION BLOCKING AT INDICATED LOCATION.
4. REMOVE SANITARY SEWER TO BE ABANDONED AS REQUIRED TO INSTALL STORM SEWER HEAD WALLS AS INDICATED BY SEQUENCE OF CONSTRUCTION NOTES.
5. RENEW WATER SERVICE TO LAWRENCE INVESTMENTS/ TRUCK, INC. PROPERTY.

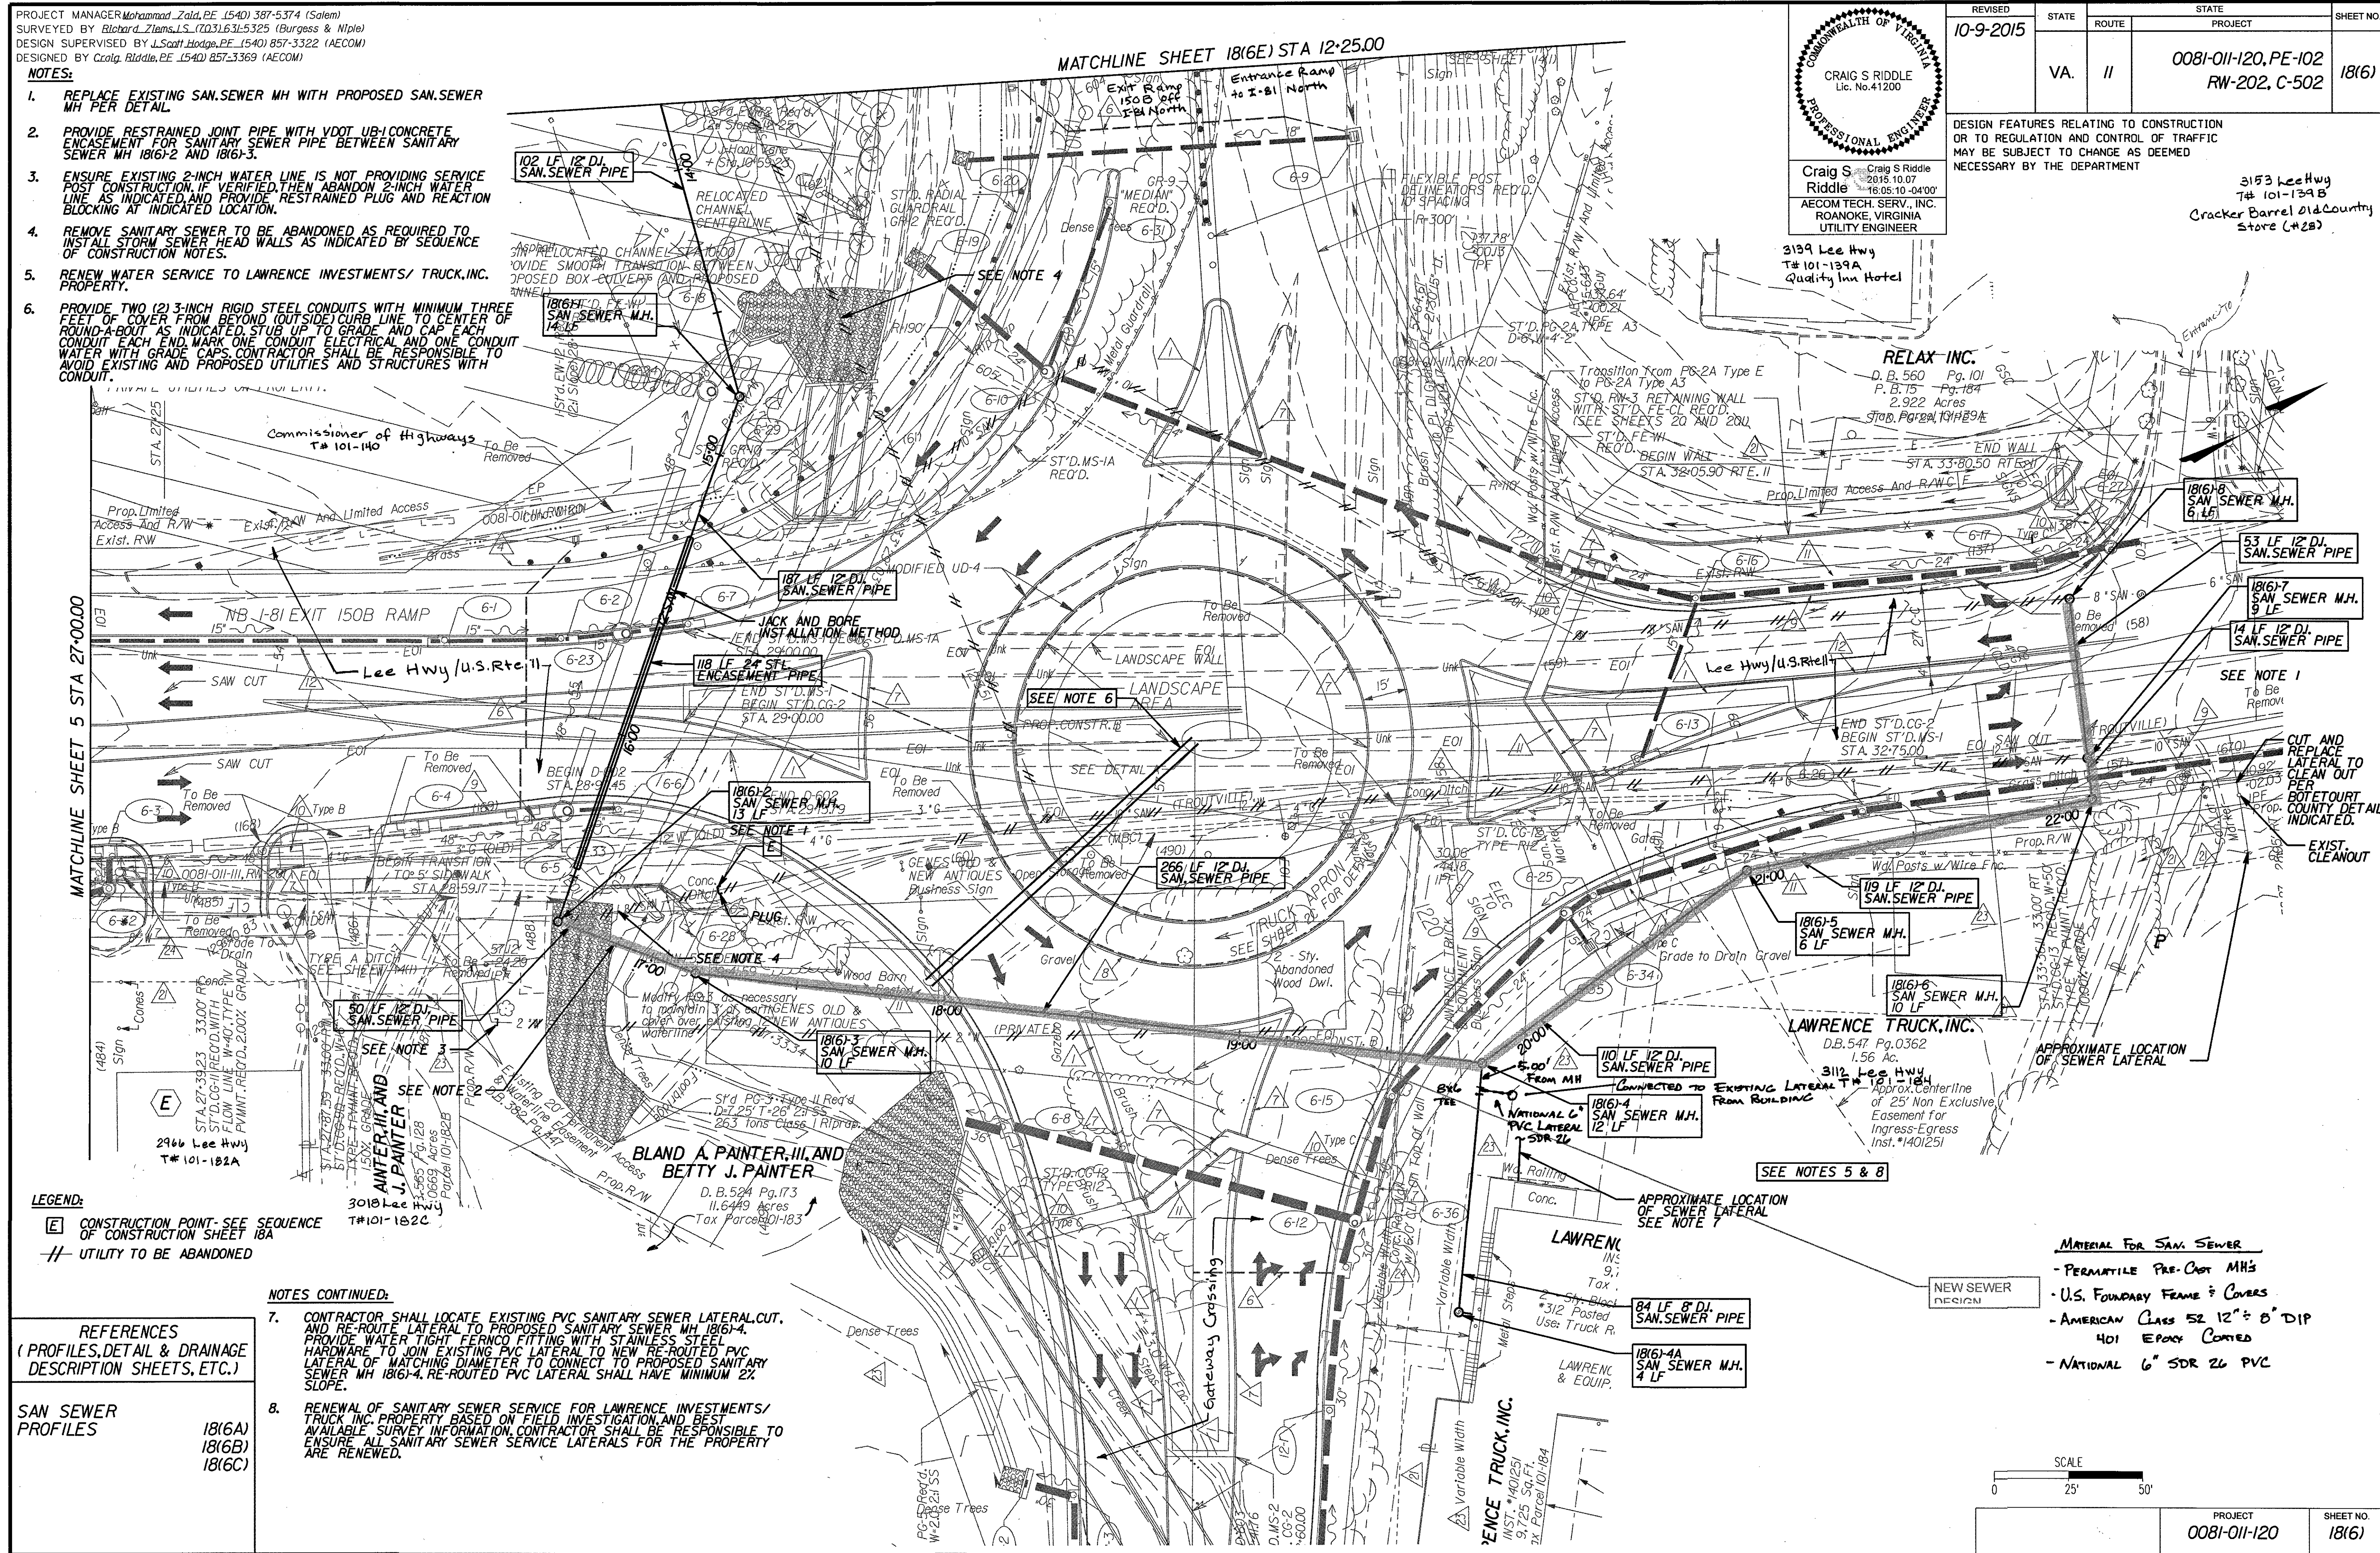

LEGEND:

[E] CONSTRUCTION POINT-SEE SEQUENCE
OF CONSTRUCTION SHEET 18A

// UTILITY TO BE ABANDONED

NOTES CONTINUED:

8. RENEWAL OF SANITARY SEWER SERVICE FOR LAWRENCE INVESTMENTS/ TRUCK INC. PROPERTY BASED ON FIELD INVESTIGATION, AND BEST AVAILABLE SURVEY INFORMATION. CONTRACTOR SHALL BE RESPONSIBLE TO EXPOSE ALL SANITARY SEWER SERVICE LATERALS FOR THE PROPERTY ARE RENEWED.

REFERENCES
(PROFILES, DETAIL & DRAINAGE
DESCRIPTION SHEETS, ETC.)

SAN SEWER
PROFILES

MATERIAL FOR SAN. SEWER

- PERMITABLE PRE-CAST MH'S
- U.S. FOUNDARY FRAME & COVERS
- AMERICAN CLASS 52 12" $\div$ 8" DIP
401 EPOXY COATED

SCALE



0 25' 50'

PROJECT 0081-011-120	SHEET NO. 18(6)
-------------------------	--------------------