

PROJECT MANAGER: Mohammad Zaid, PE (540) 387-5374 (Salem)
SURVEYED BY: Richard Zlams, LS (203) 631-5325 (Burgess & Niple)
DESIGN SUPERVISED BY: J. Scott Hodge, PE (540) 857-3322 (AECOM)
DESIGNED BY: Craig Riddle, PE (540) 857-3369 (AECOM)


REVISED	STATE	ROUTE	PROJECT	SHEET NO.
	VA.	11	0081-011-120, PE-102 RW-202, C-502	18(6E)

DESIGN FEATURES RELATING TO CONSTRUCTION
OR TO REGULATION AND CONTROL OF TRAFFIC
MAY BE SUBJECT TO CHANGE AS DEEMED
NECESSARY BY THE DEPARTMENT

AECOM TECH. SERV., INC.
ROANOKE, VIRGINIA
ROADWAY ENGINEER

AECOM TECH. SERV., INC.
ROANOKE, VIRGINIA
UTILITY ENGINEER

THESE PLANS ARE UNFINISHED
AND UNAPPROVED AND ARE NOT
TO BE USED FOR ANY TYPE
OF CONSTRUCTION.

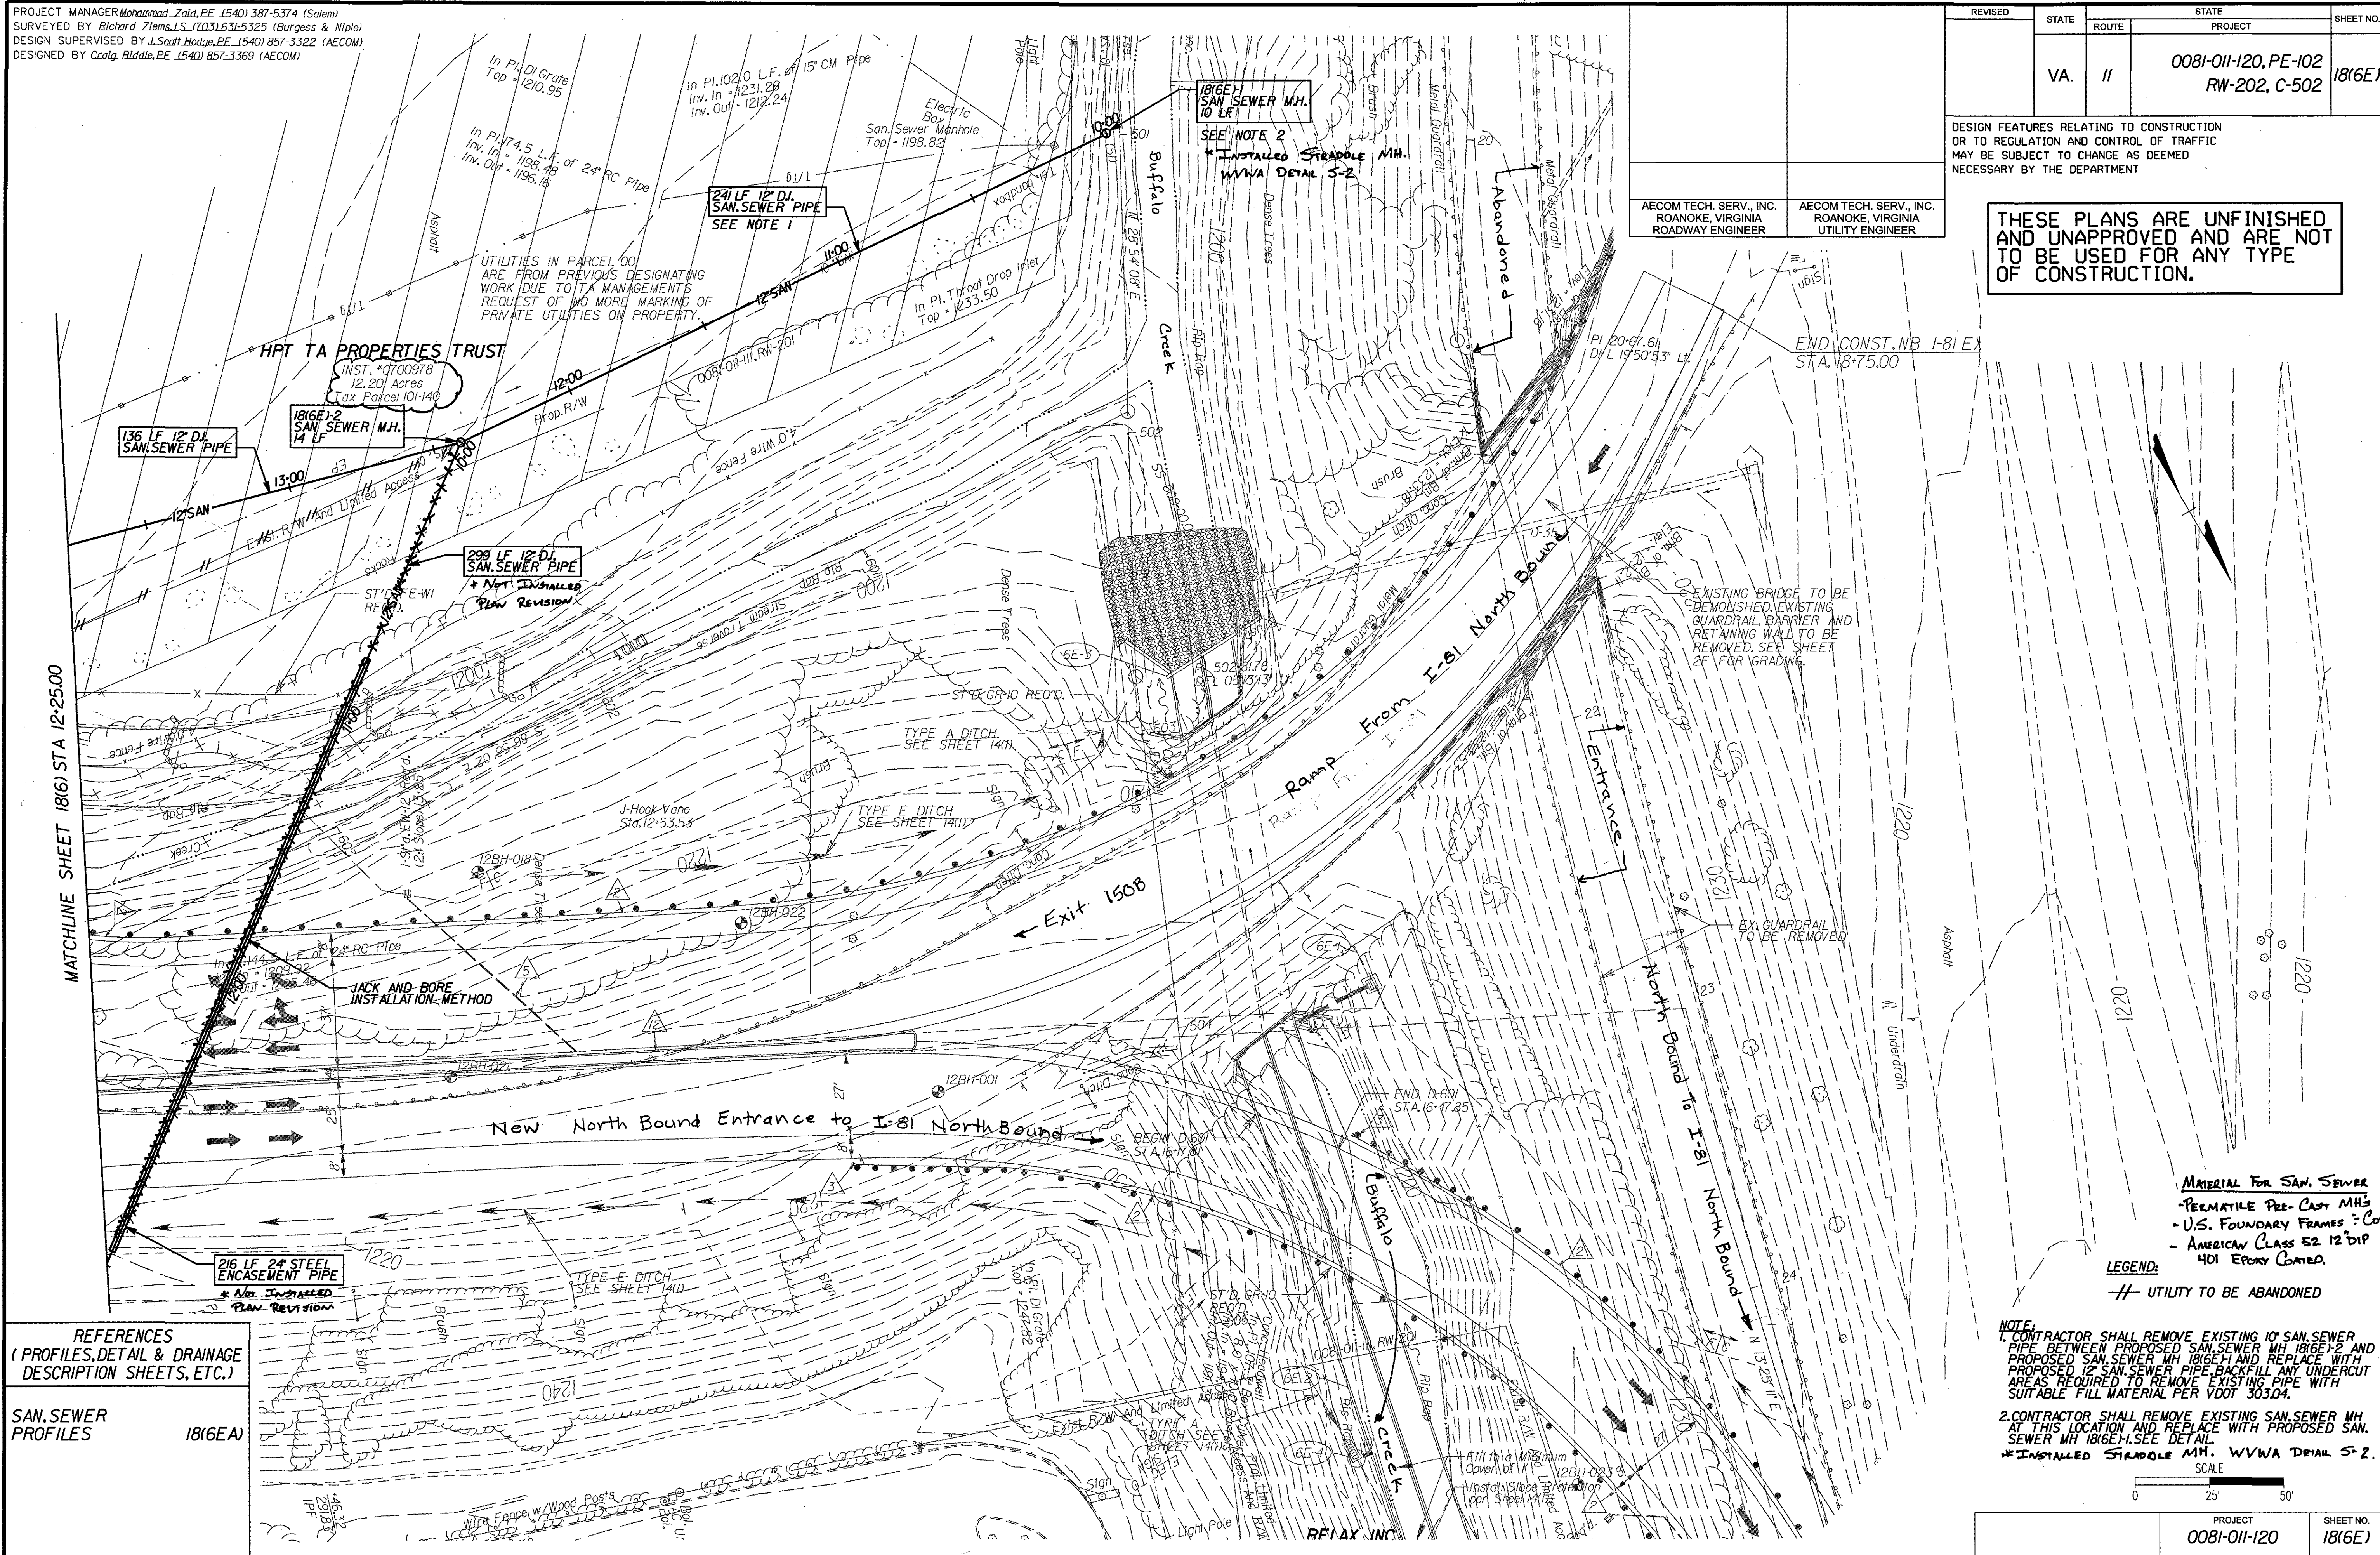

REFERENCES
(PROFILES, DETAIL & DRAINAGE
DESCRIPTION SHEETS, ETC.)

SAN SEWER
PROFILES

18(6E)

MATERIAL FOR SAN SEWER
- PERMATEL PRE-CAST MHS
- U.S. FOUNDARY FRAMES - COVERS
- AMERICAN CLASS 52 12\"/>

LEGEND:
-- UTILITY TO BE ABANDONED

NOTE:
1. CONTRACTOR SHALL REMOVE EXISTING 10\"/>

2. CONTRACTOR SHALL REMOVE EXISTING SAN SEWER M.H.
AT THIS LOCATION AND REPLACE WITH PROPOSED SAN
SEWER M.H. 18(6E)-1. SEE DETAIL.
* INSTALLED STRADDLE M.H. WVA DETAIL S-2.

SCALE
0 25' 50'

PROJECT
0081-011-120

SHEET NO.
18(6E)