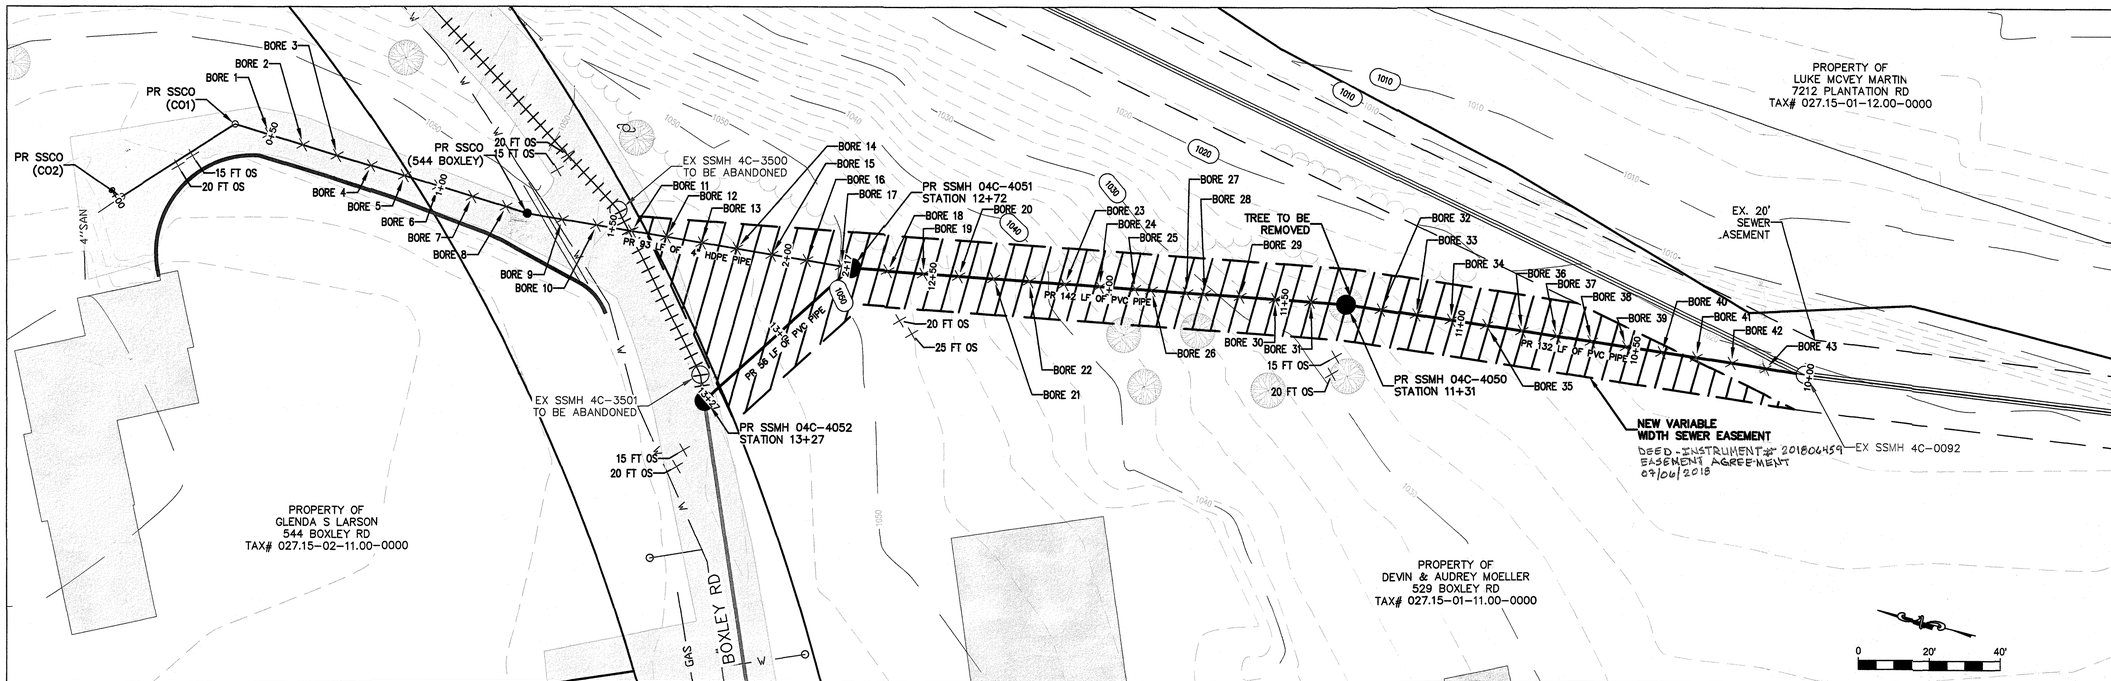

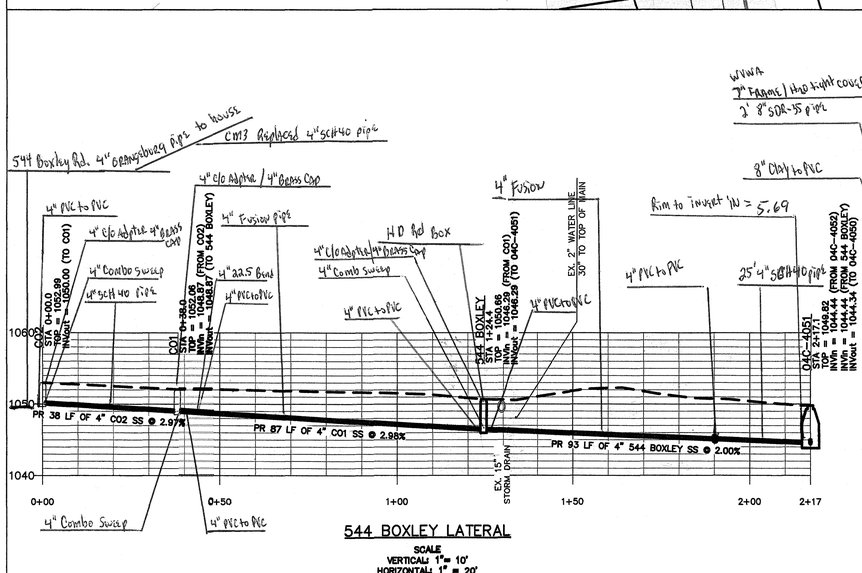

544 BOXLEY LATERAL

SCALE
VERTICAL: 1" = 10'
HORIZONTAL: 1" = 20'

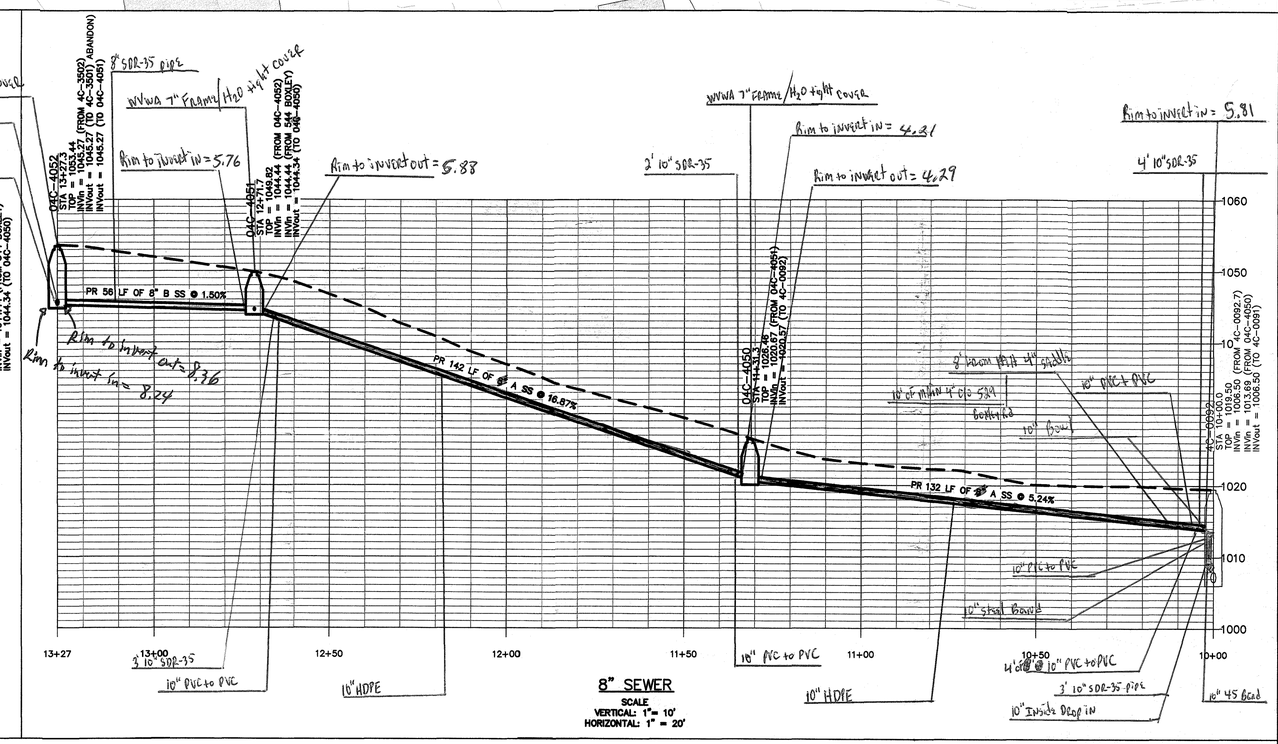

8" SEWER

SCALE
VERTICAL: 1" = 10'
HORIZONTAL: 1" = 20'

WESTERN VIRGINIA WATER AUTHORITY
ENGINEERING SERVICES
601 S JEFFERSON ST, SUITE 300
ROANOKE, VA 24011
540-853-5700

As-Built

BOXLEY & PLANTATION SEWER (CIP-211)

BORE PLAN & PROFILE

Rev	Description	Date	By
1	2' WL POTHOLE INFO/ADJUSTED PR SS	7/12/18	DRJ
2	ADDED BORE/CUT SURVEY INFORMATION	7/17/18	DRJ
3	UPDATED SURFACE INFORMATION	7/17/18	DRJ
4	ADJUSTED PR PIPE COVER ON DS SECTION	7/17/18	DRJ

Designed: AAS
Drawn: AAS
Checked: TEC
Approved:
Date: 7/9/18
Project:

2
Sheet 2 of 2