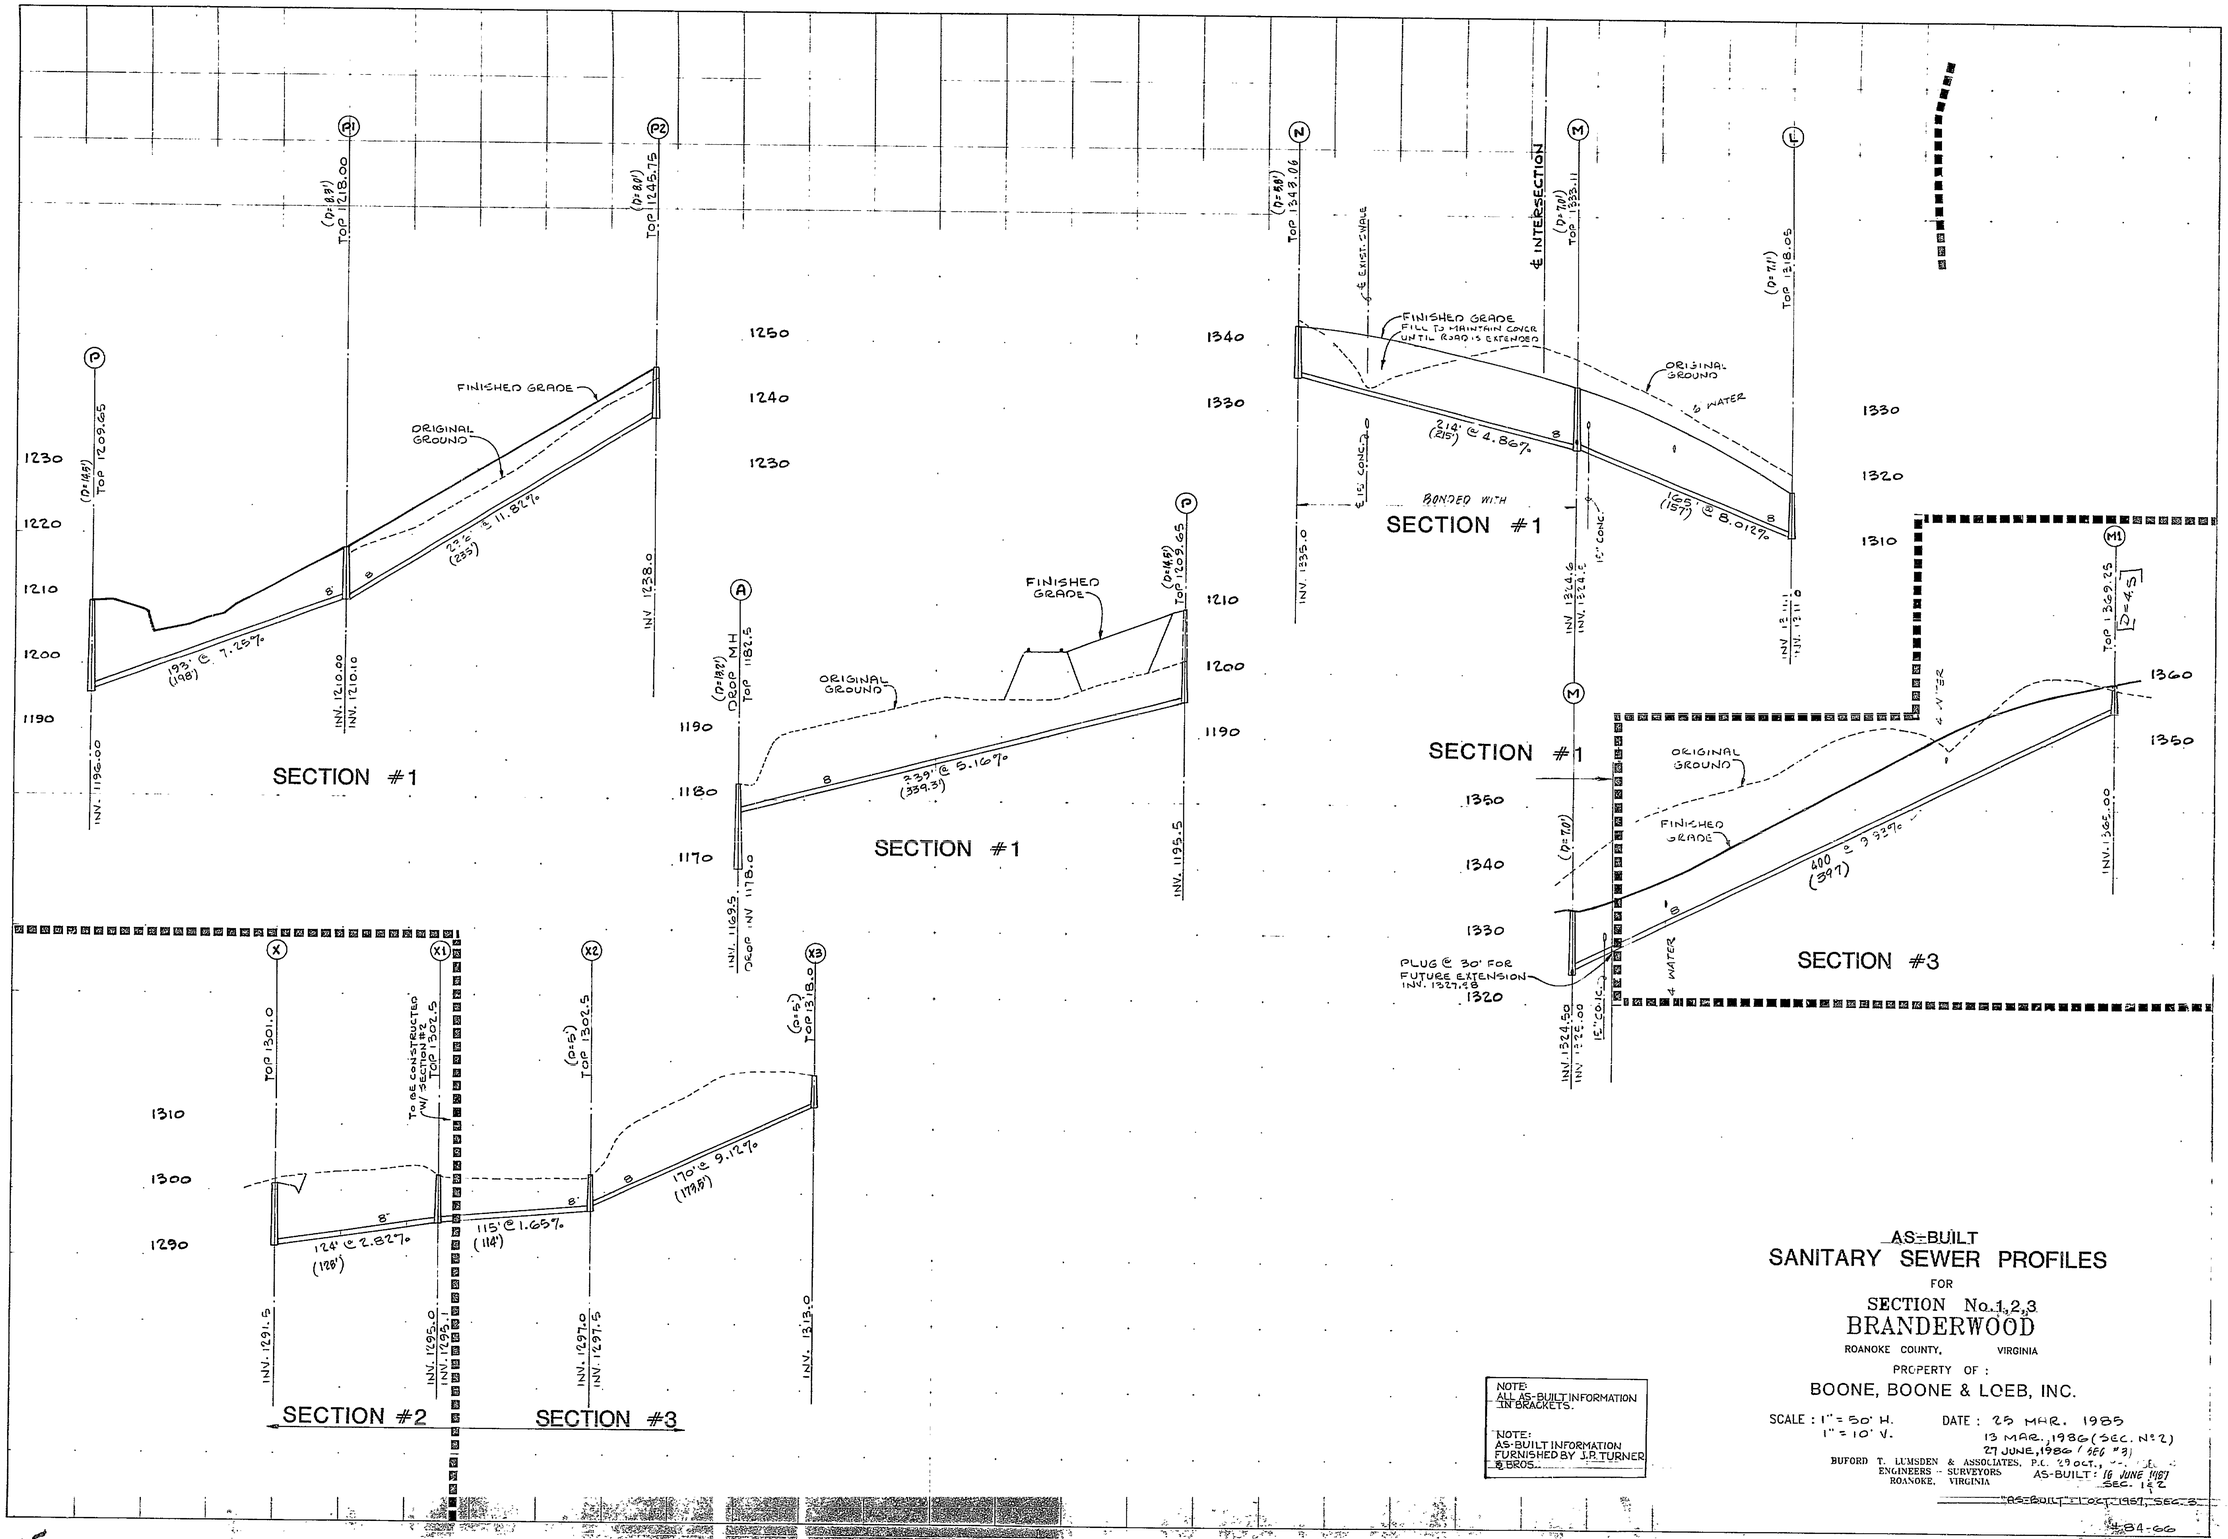

NOTE:
ALL AS-BUILT INFORMATION IN BRACKETS.

NOTE:
AS-BUILT INFORMATION FURNISHED BY J.P. TURNER & BROS.

AS-BUILT

SANITARY SEWER PROFILES

FOR

SECTION No. 1, 2, 3

BRANDERWOOD

ROANOKE COUNTY, VIRGINIA

PROPERTY OF :

BOONE, BOONE & LOEB, INC.

SCALE : 1" = 50' H.
1" = 10' V.

DATE : 25 MAR. 1985
13 MAR., 1986 (SEC. No 2)
27 JUNE, 1986 (SEC No 3)

BUFORD T. LUMSDEN & ASSOCIATES, P.C.
ENGINEERS - SURVEYORS
ROANOKE, VIRGINIA

29 OCT.,
AS-BUILT: 16 JUNE 1987
SEC. 1 & 2

AS-BUILT 1 OCT. 1987, SEC. 3

484-66

SHEET 10 OF 16