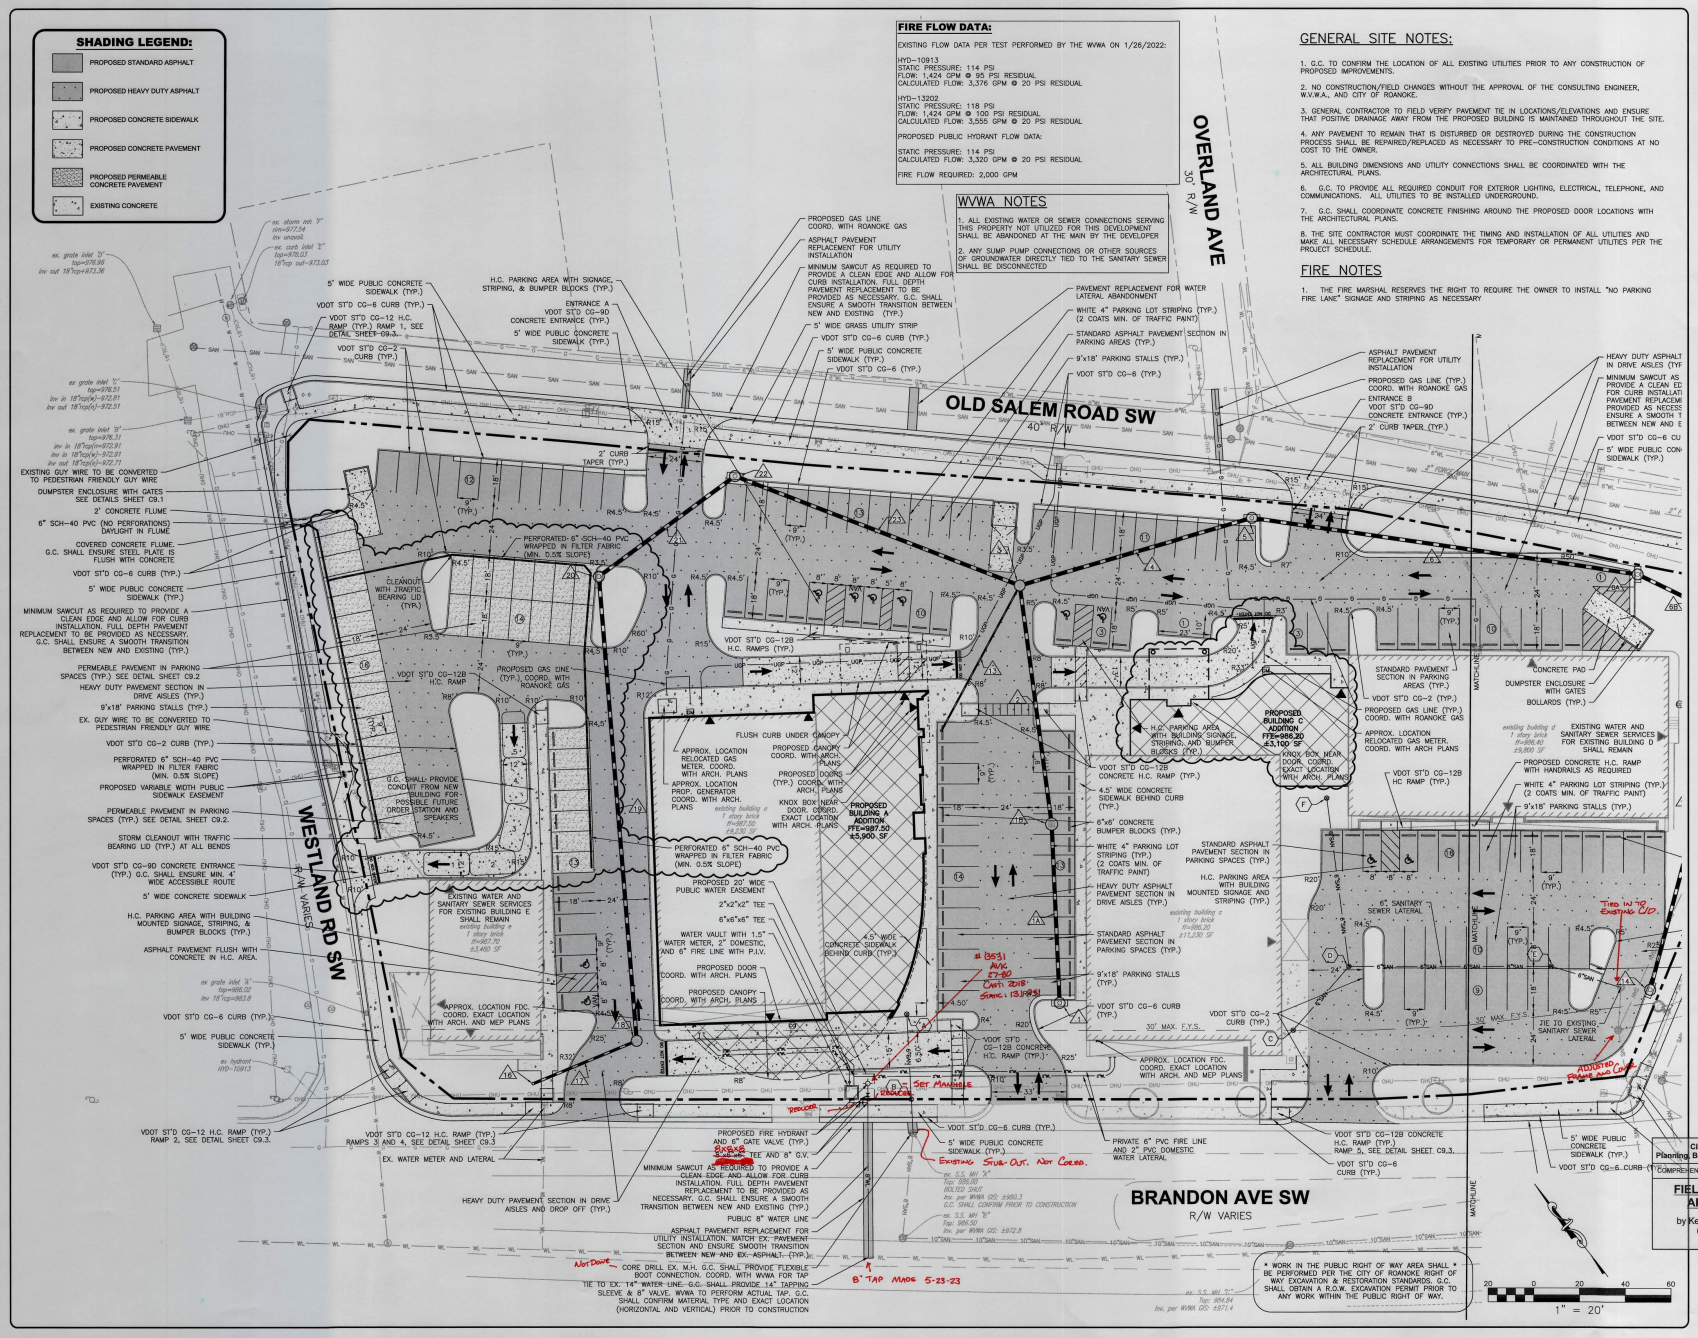


BALZER & ASSOCIATES
PLANNERS / ARCHITECTS
ENGINEERS / SURVEYORS
Roanoke / Richmond
Shenandoah Valley
New River Valley / Lynchburg
www.balzer.cc
1206 Corporate Circle
Roanoke, VA 24018
540.772.9560

COMMONWEALTH OF VIRGINIA
CHRISTOPHER P. BUZZO
Lic. No. 47038
4/21/2023
PROFESSIONAL ENGINEER

# BRANDON AVENUE COMMERCIAL CENTER

## LAYOUT AND UTILITY PLAN 1

3233 BRANDON AVE SW
CITY OF ROANOKE, VIRGINIA

| | |
|---|---|
| DRAWN BY | KAM |
| DESIGNED BY | KAM |
| CHECKED BY | CPB |
| DATE | 11/8/2022 |
| SCALE | 1" = 20' |
| REVISIONS | |
| 3/24/2023 | FR#1 |
| 4/21/2023 | FR#2 |

City of Roanoke
Planning, Building, & Development
COMPREHENSIVE DEVELOPMENT PLAN

FIELD REVISION APPROVED
by Ken Richardson
04/26/2023

C4.1

PROJECT NO. 04210048.00