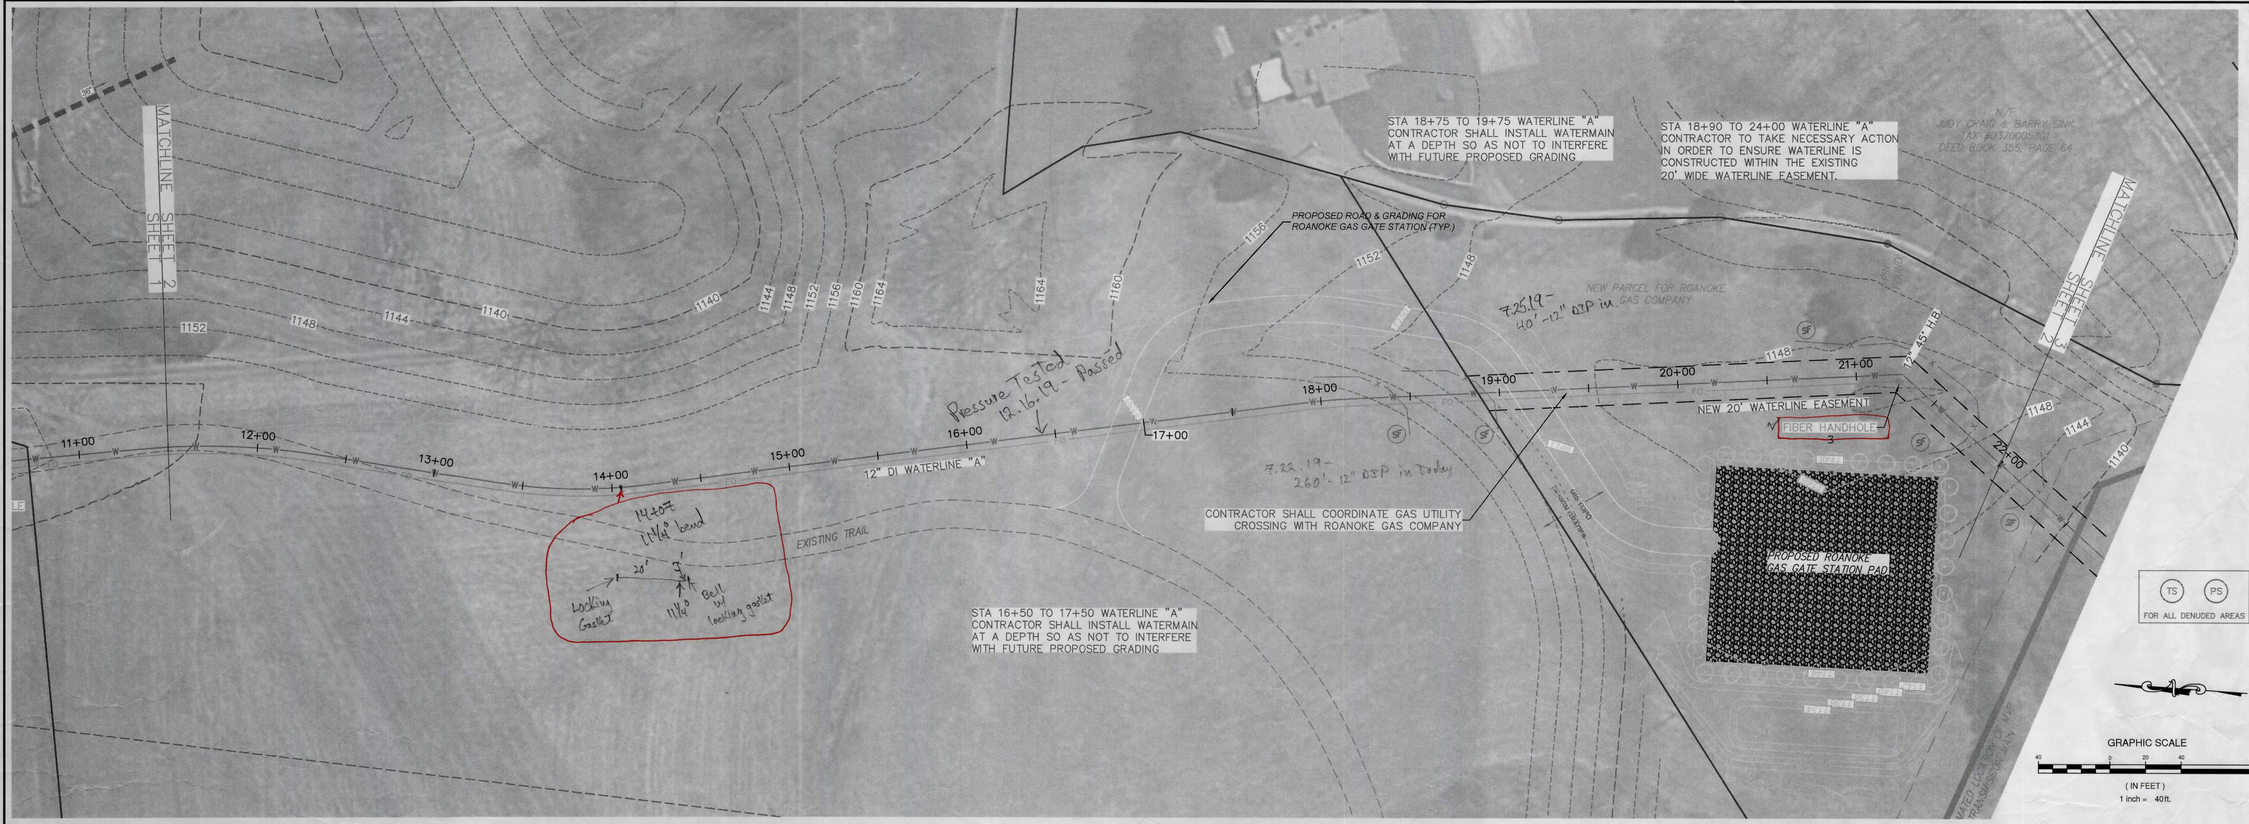

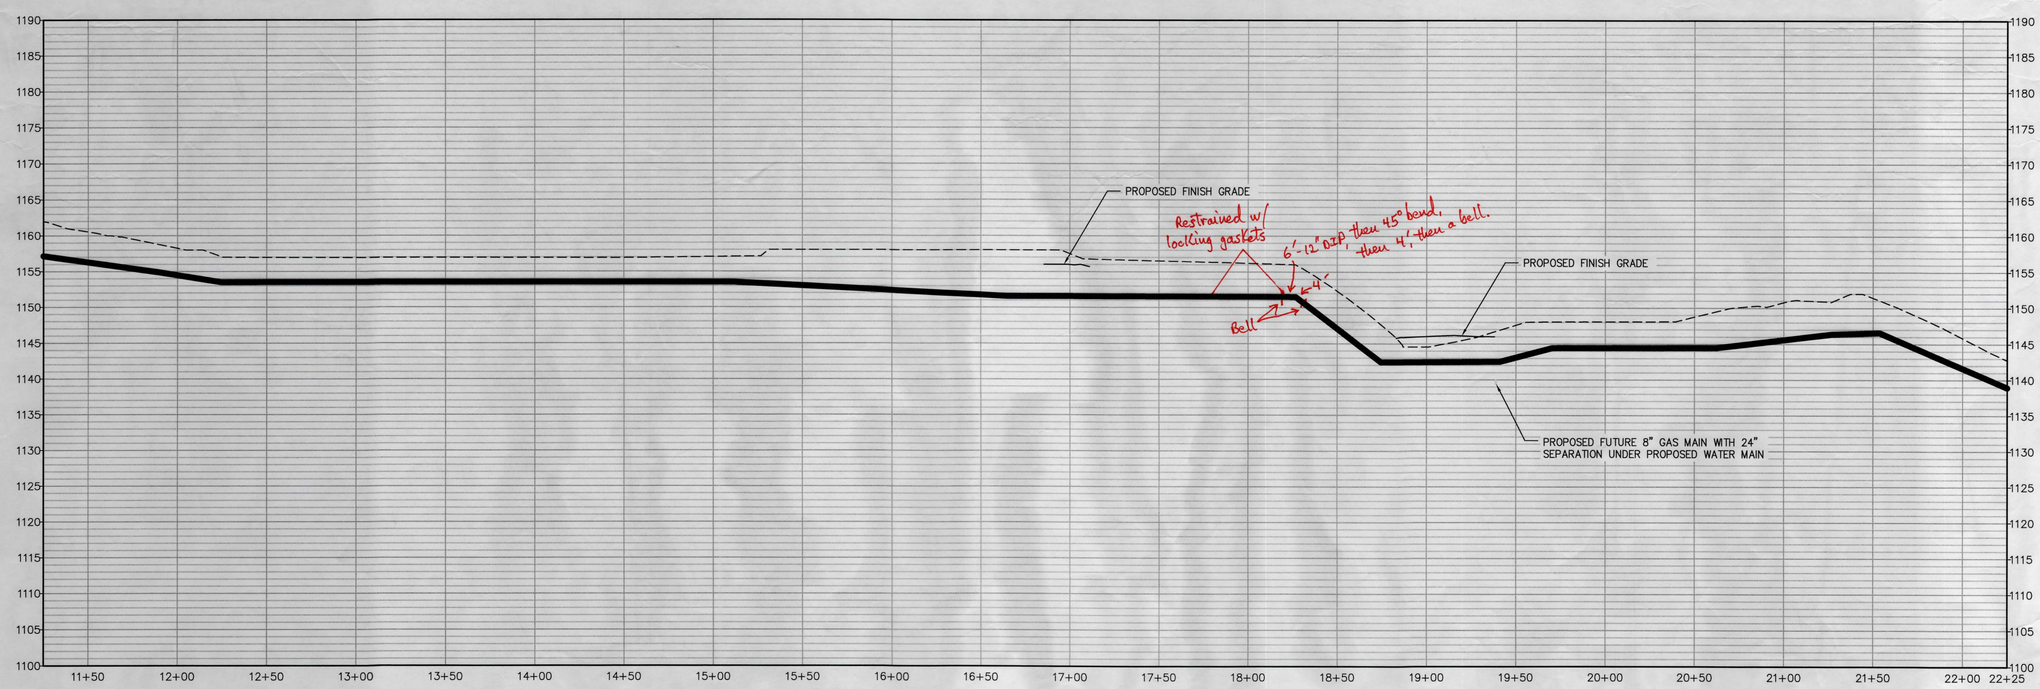

PROFILE: STA 11+25 TO STA 22+25 - Scale: H: 1"=40', V: 1"=10'

COMMONWEALTH OF VIRGINIA
GARY L. ROBERTSON
LIC. NO. 044508
PROFESSIONAL ENGINEER

WESTERN VIRGINIA WATER AUTHORITY

BRICK CHURCH ROAD WATERLINE EXTENSION

FRANKLIN COUNTY, VIRGINIA

REVISIONS

DESIGNED BY:	GLR
DRAWN BY:	PDG, DRJ
CHECKED BY:	WNR
SCALE:	1" = 40'
DATE:	APRIL 2019
PROJECT NUMBER:	WCIP-340
SHEET TITLE:	PLAN & PROFILE

2

2 OF 11