

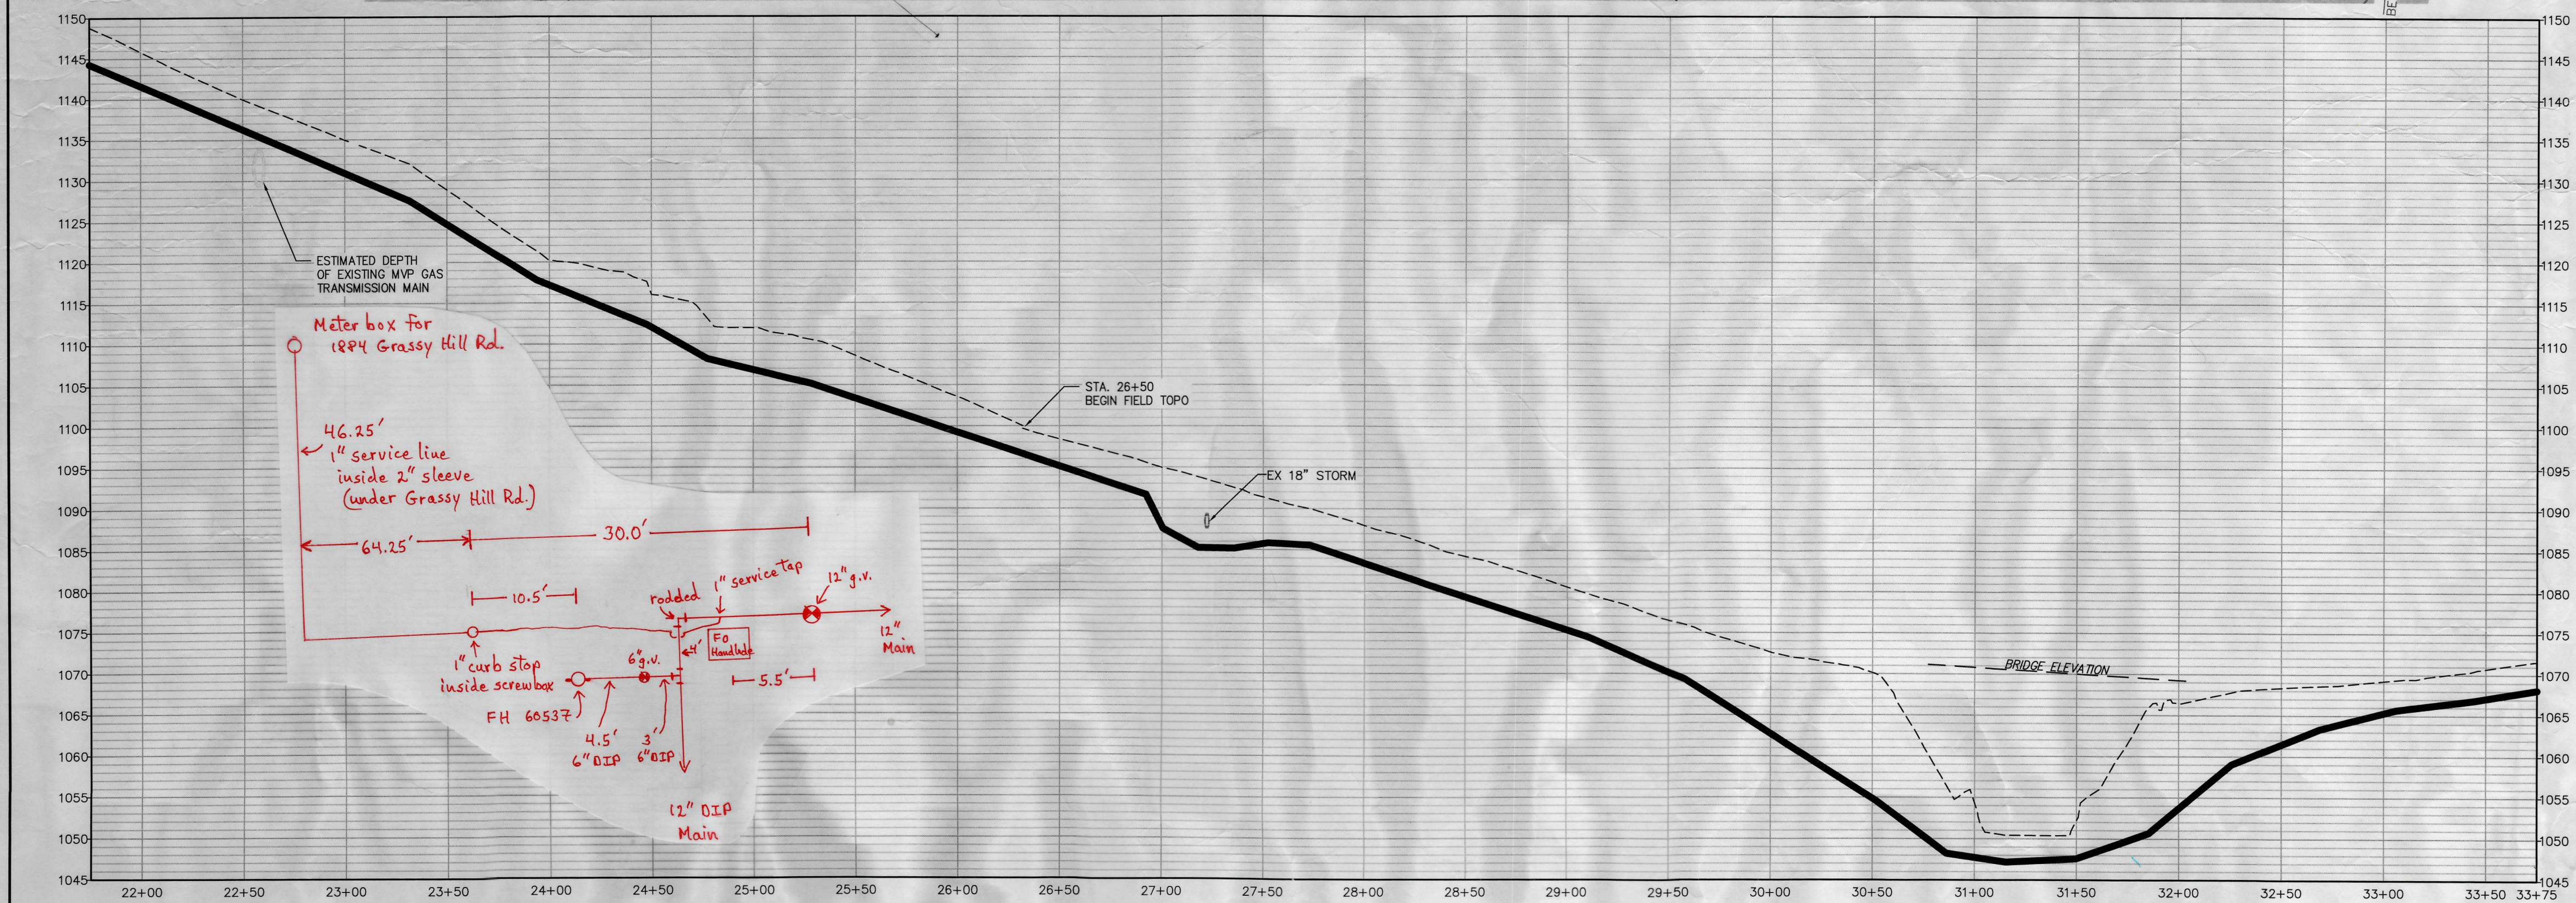
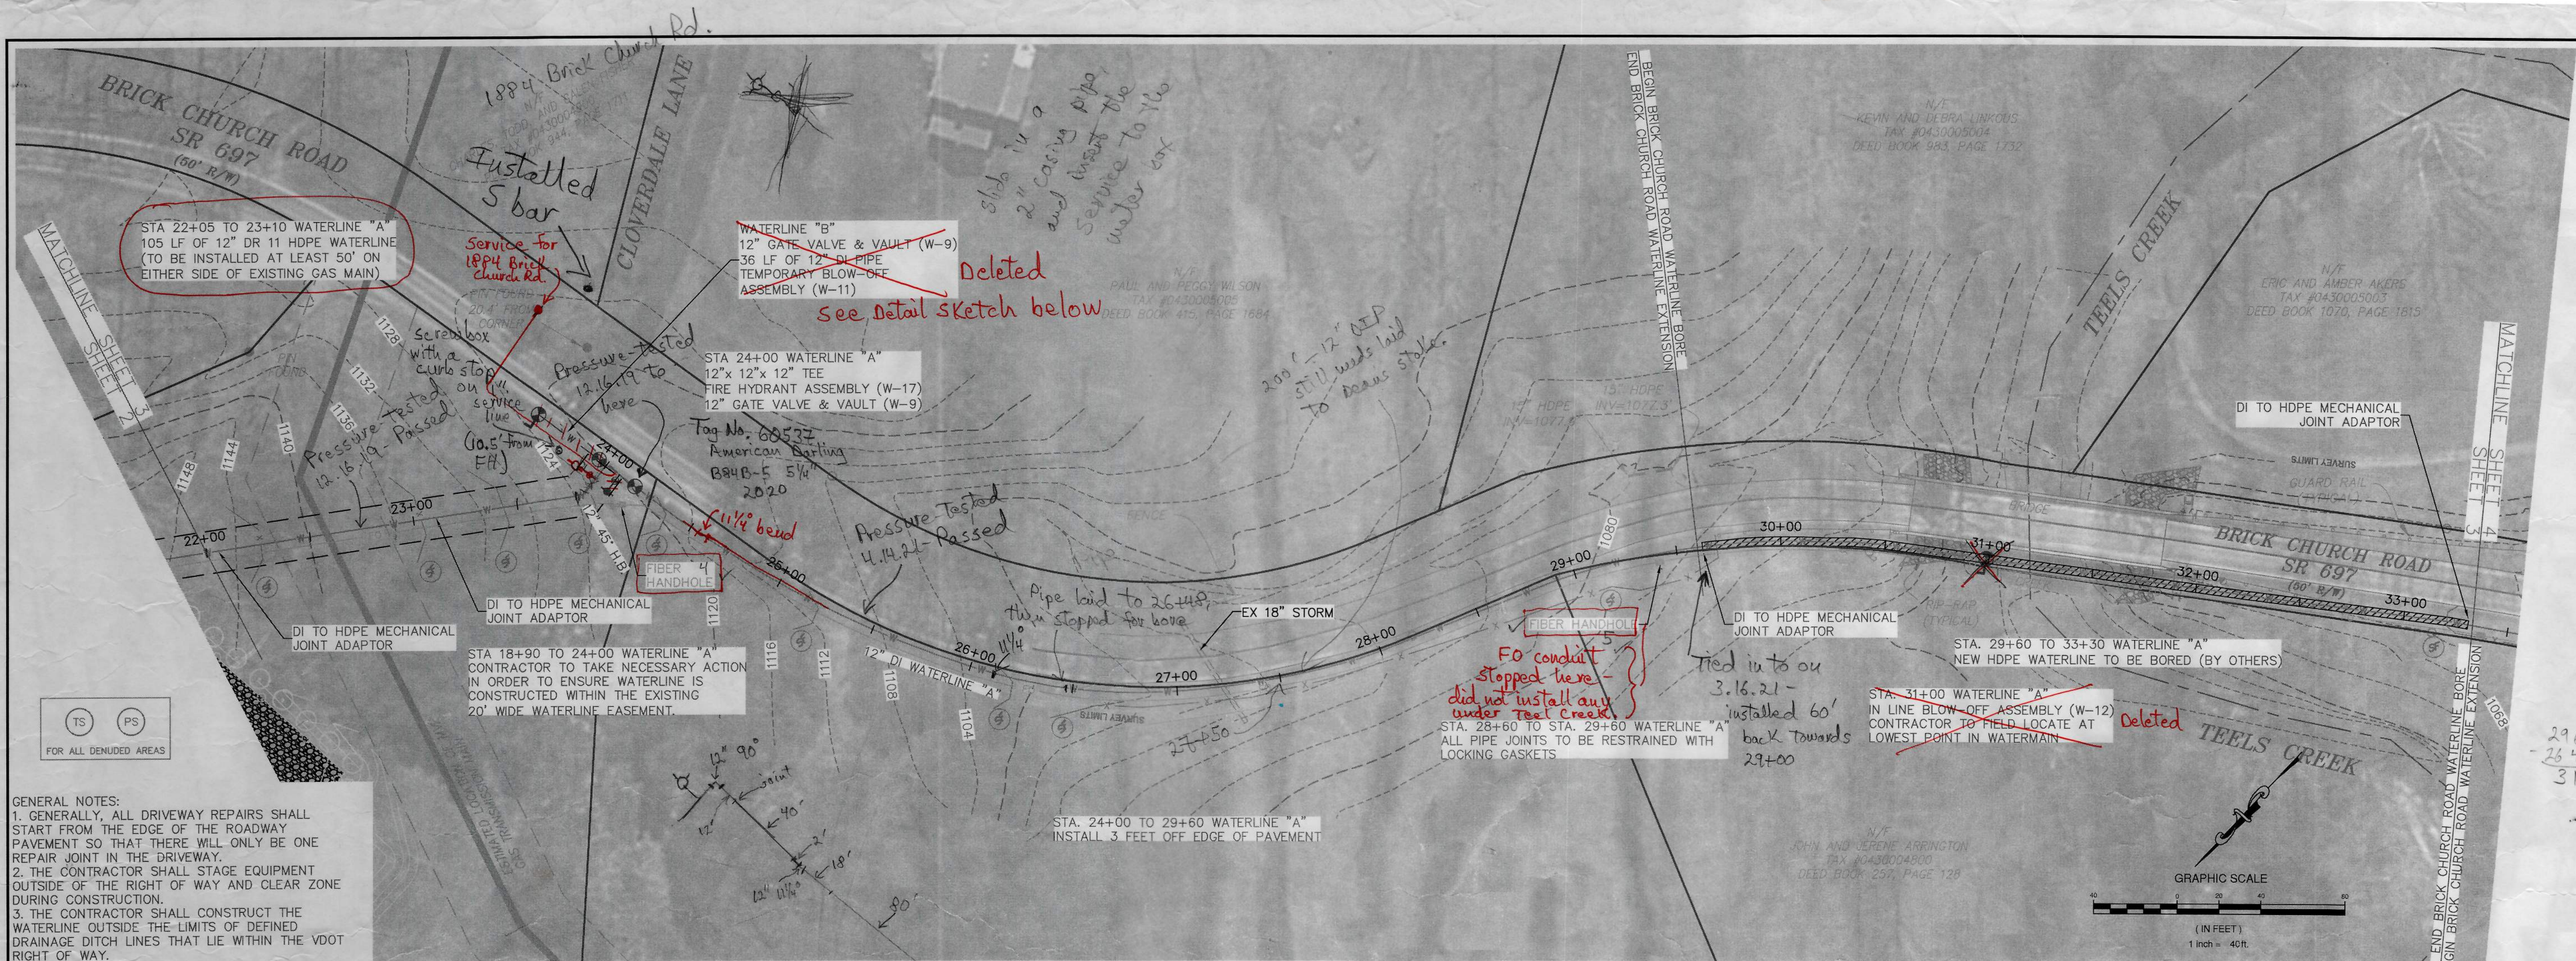


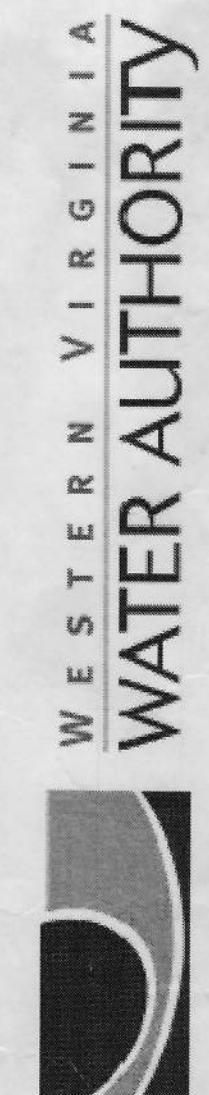

PROFILE: STA 21+75 TO STA 33+75 - Scale: H: 1"=40', V: 1"=10'

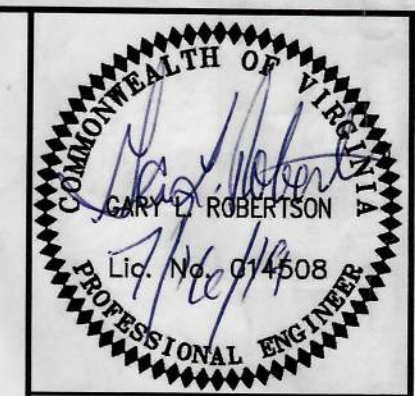

BRICK CHURCH ROAD WATERLINE EXTENSION

FRANKLIN COUNTY, VIRGINIA

DESIGNED BY:	GLR
DRAWN BY:	PDG, DRJ
CHECKED BY:	WNR
SCALE:	1" = 40'
DATE:	APRIL 2019
PROJECT NUMBER:	WCIP-340
SHEET TITLE:	PLAN & PROFILE
	3
	3 OF 11