


GRASSY HILL ROAD
WATERLINE EXTENSION

FRANKLIN COUNTY, VIRGINIA


REVISIONS
1. ADDRESS VDOT REVIEW COMMENTS - 5/11/20 - DRJ

DESIGNED BY:	IAS
DRAWN BY:	PDG, DRJ
CHECKED BY:	WCB
SCALE:	1" = 40'
DATE:	FEB 6 2020
PROJECT NUMBER:	WCIP
SHEET TITLE:	

PLAN AND PROFILE

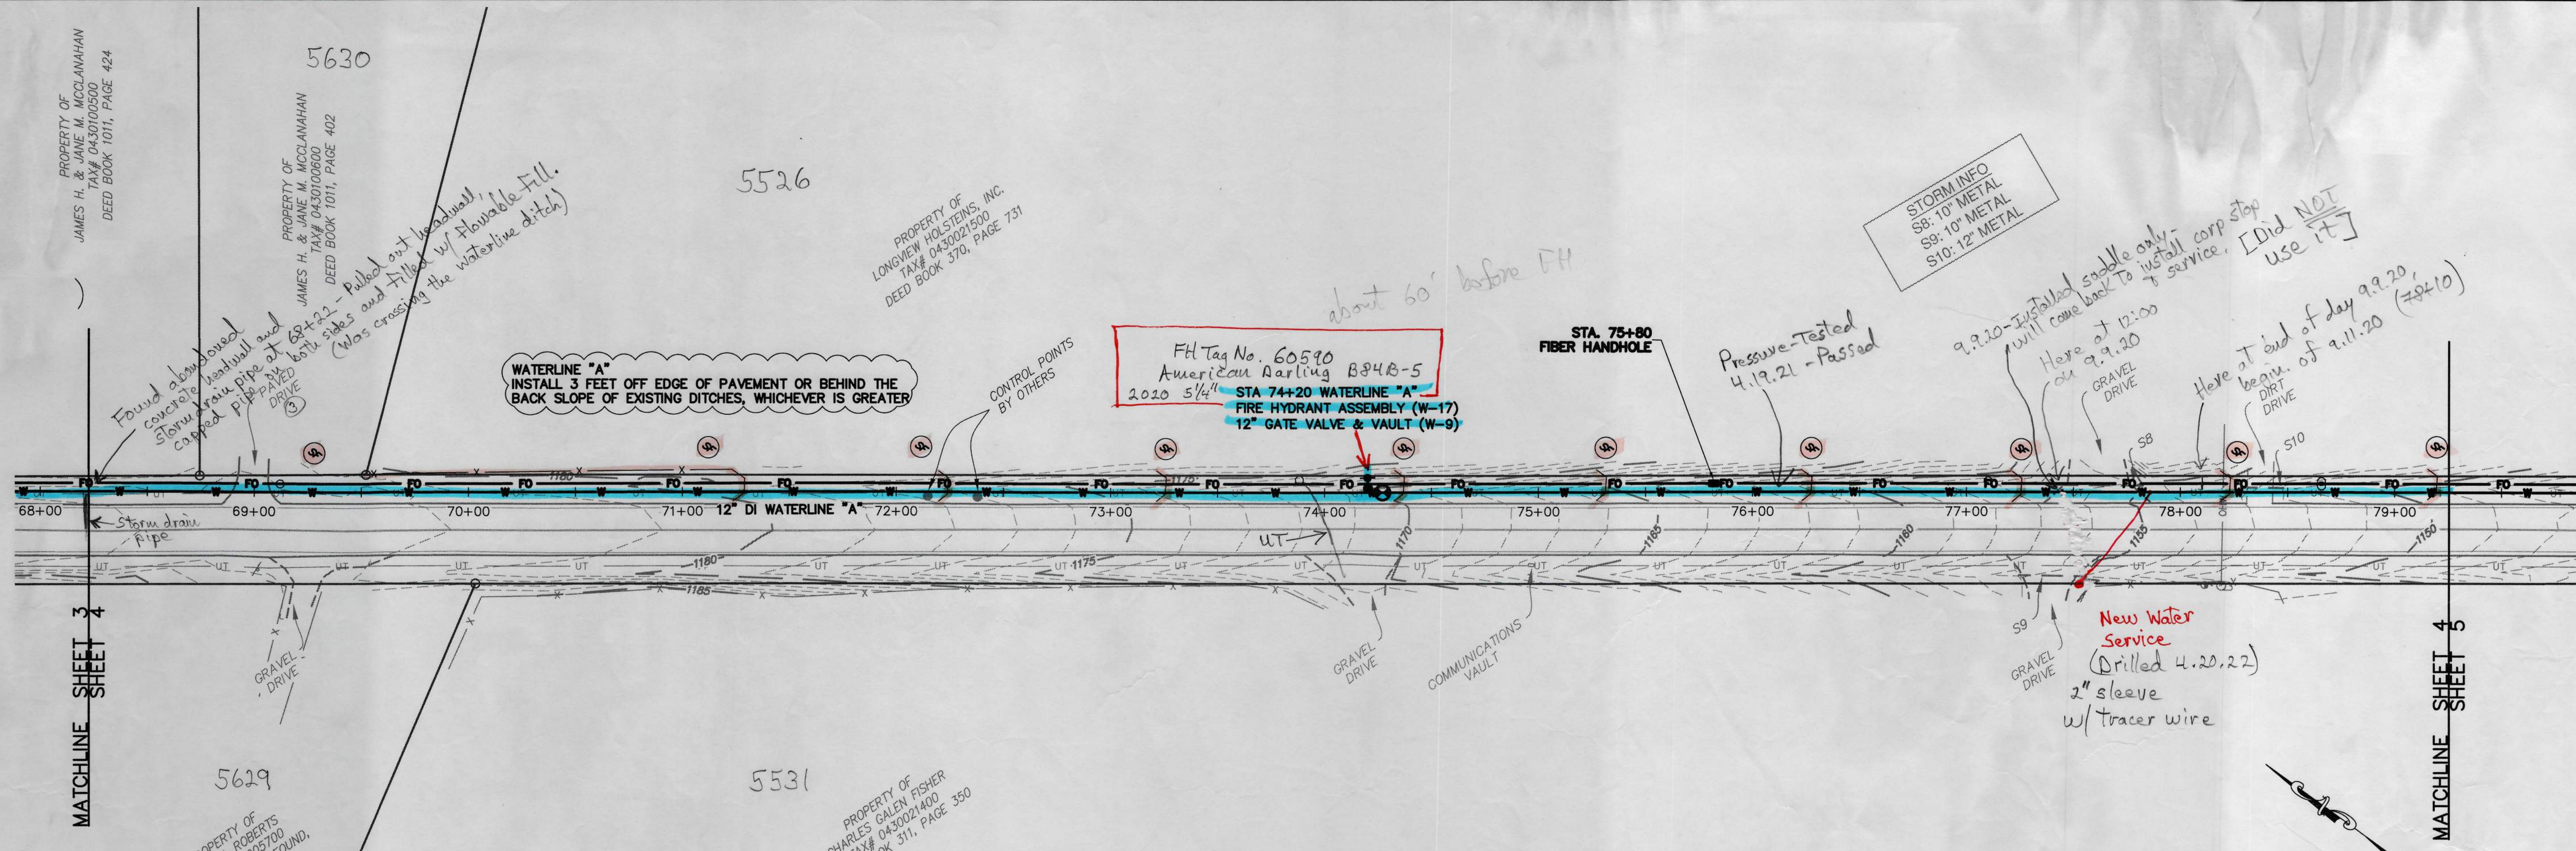

- GENERAL NOTES:
1. GENERALLY, ALL DRIVEWAY REPAIRS SHALL START FROM THE EDGE OF THE ROADWAY PAVEMENT SO THAT THERE WILL ONLY BE ONE REPAIR JOINT IN THE DRIVEWAY.
 2. THE CONTRACTOR SHALL STAGE EQUIPMENT OUTSIDE OF THE RIGHT-OF-WAY AND CLEAR ZONE DURING CONSTRUCTION.
 3. THE CONTRACTOR SHALL CONSTRUCT THE WATERLINE, FIBER LINE & ALL RELATED APPURTENANCES OUTSIDE THE LIMITS OF DEFINED DRAINAGE DITCH LINES THAT LIE WITHIN THE VDOT RIGHT OF WAY.
 4. HORIZONTAL SEPARATION BETWEEN NEW FIBER CONDUIT AND NEW WATER MAIN IS EXAGGERATED ON THIS PLAN FOR CLARITY. FOR ACTUAL HORIZONTAL SEPARATION, REFER TO THE "COMMON WATERLINE AND FIBER CONDUIT TRENCH" DETAIL ON PAGE 17.

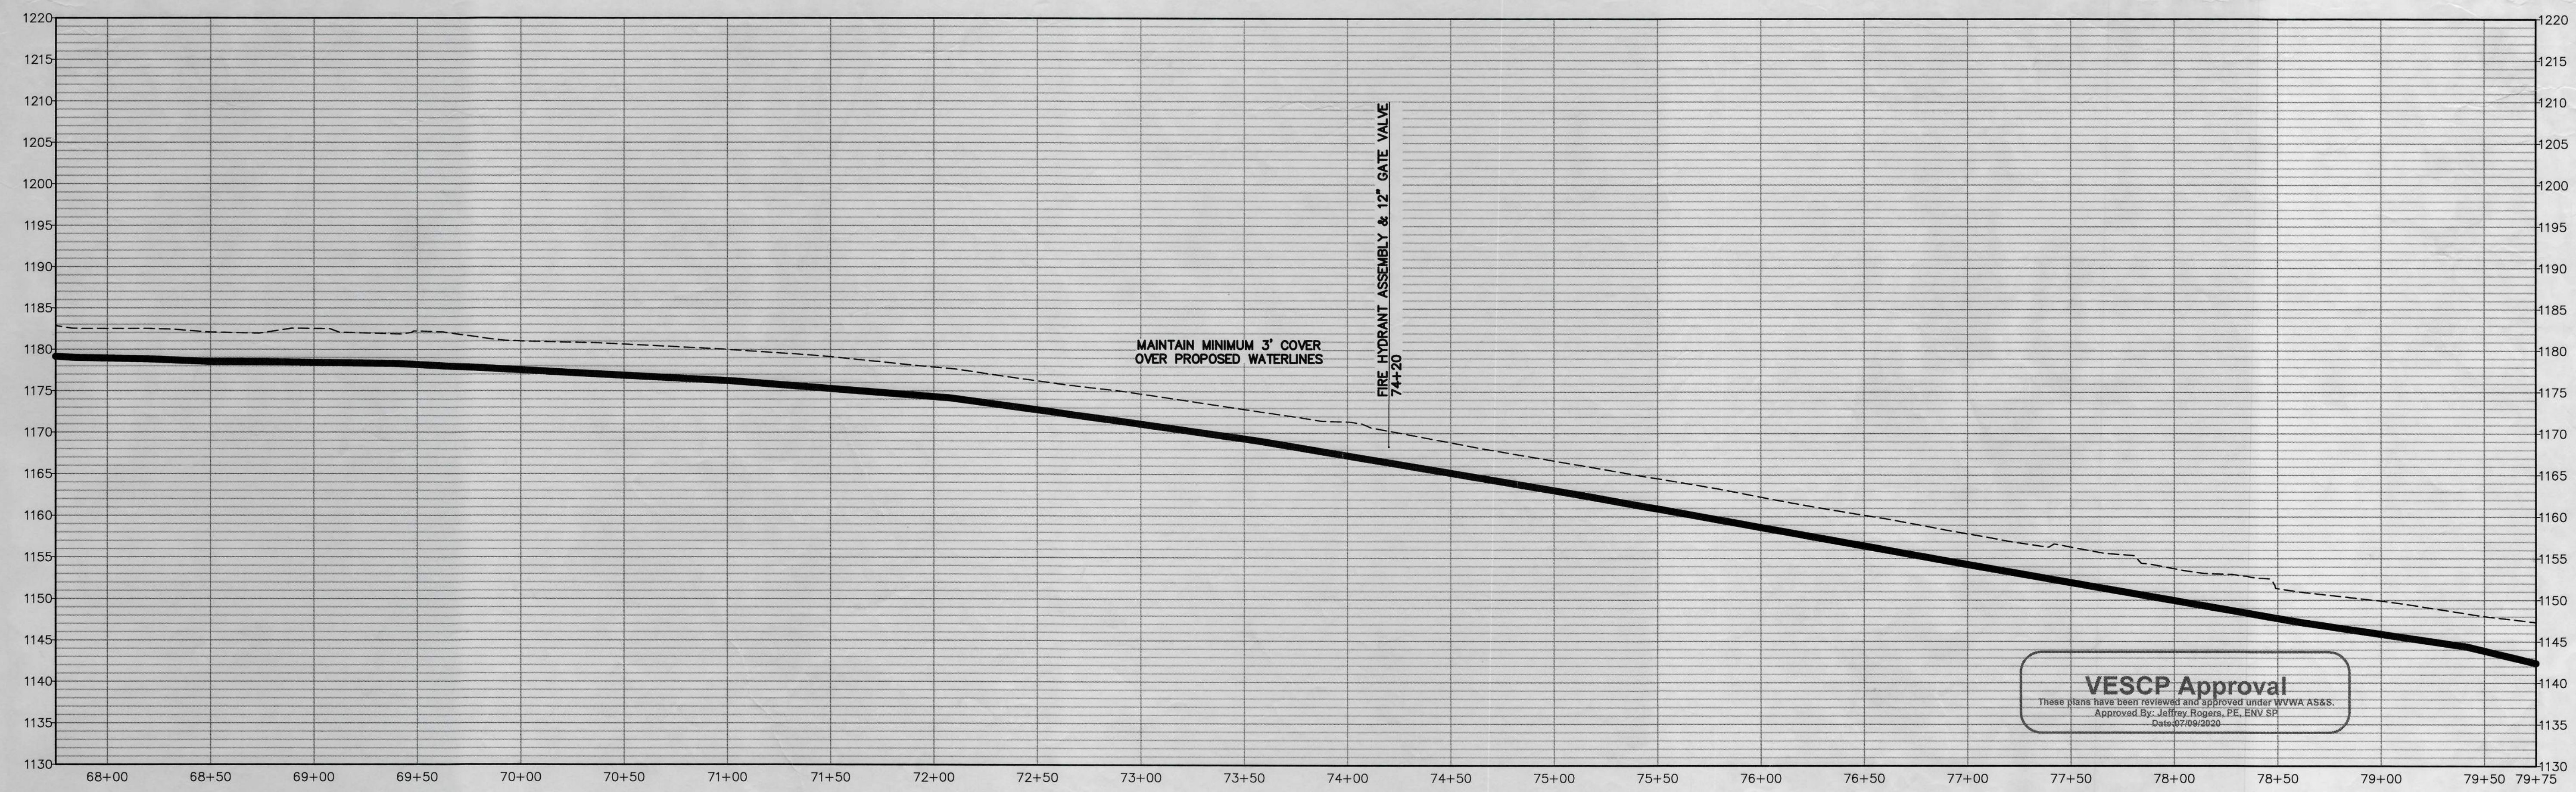

PROFILE: STA 67+75 TO STA 79+75 - Scale: H: 1"=40', V: 1"=10'

VESCP Approval
These plans have been reviewed and approved under WVWA AS&S.
Approved By: Jeffrey Rogers, PE, ENV SP
Date: 07/09/2020