
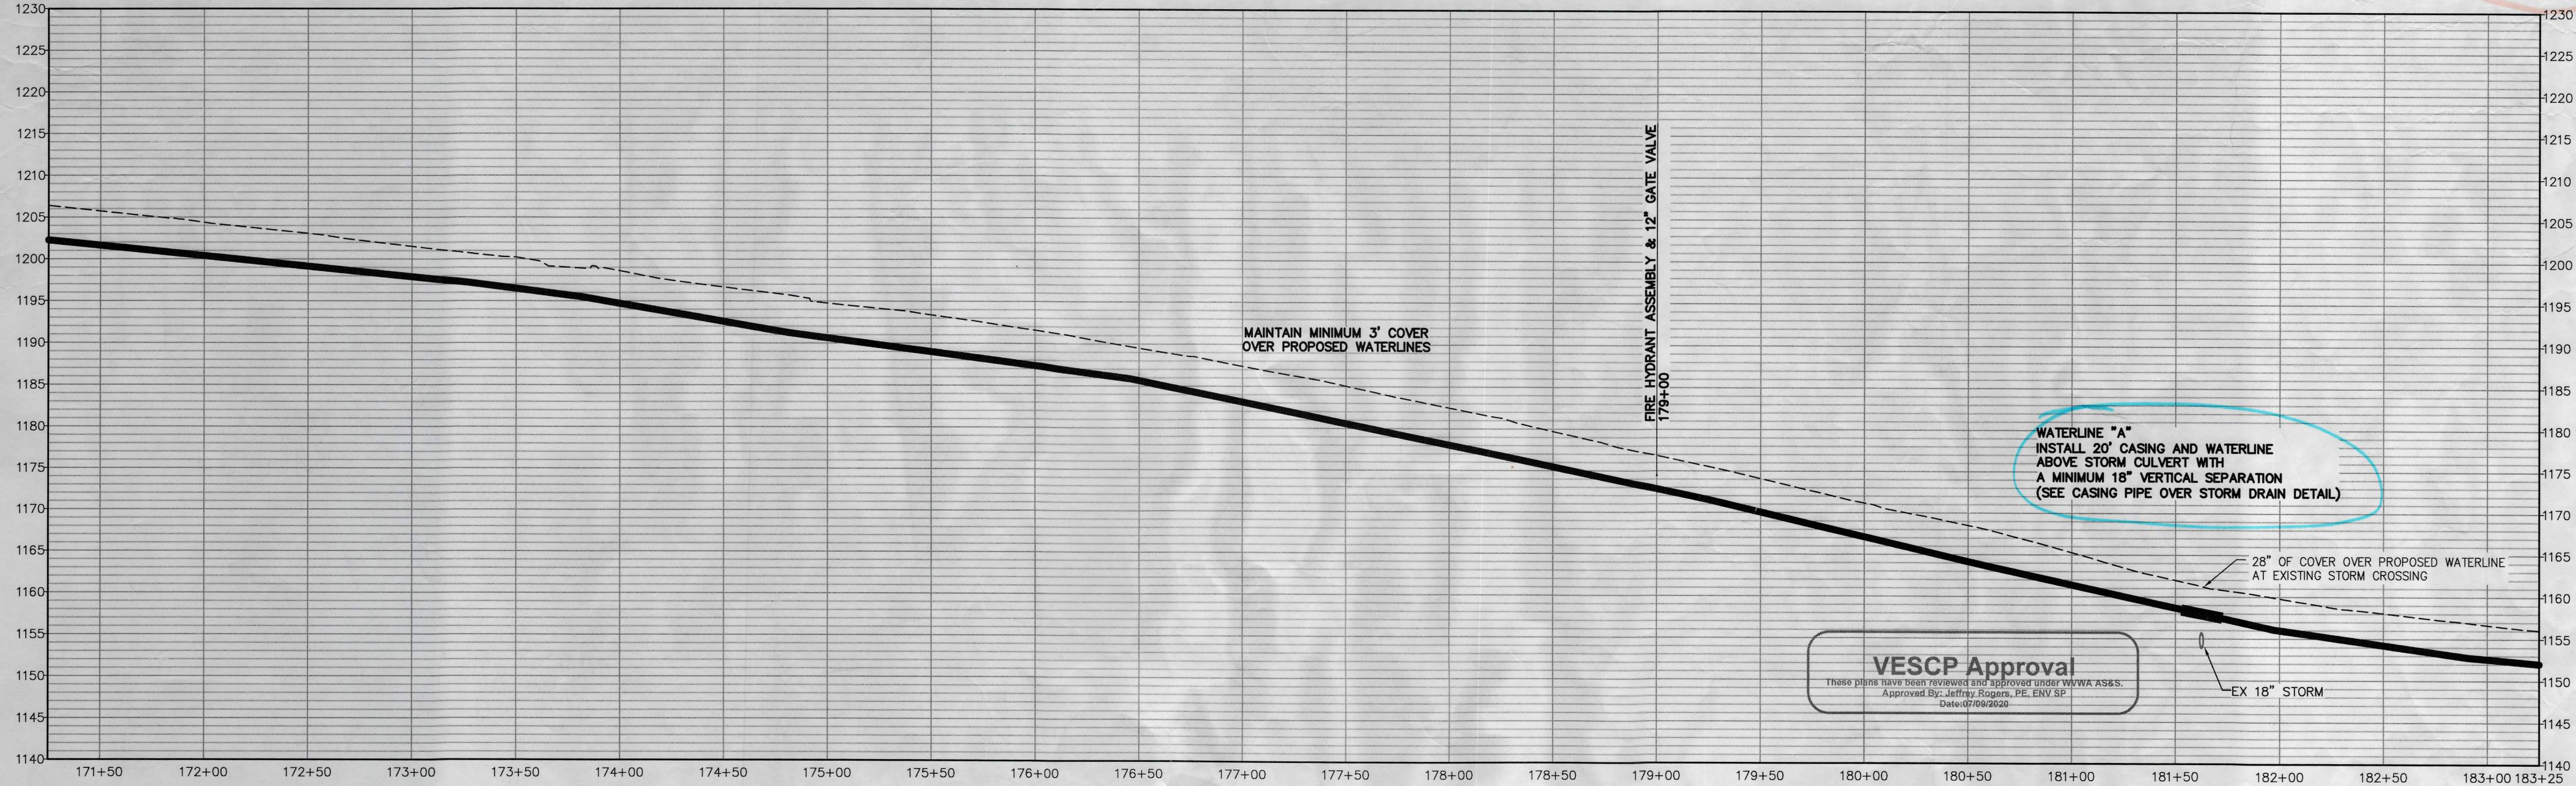


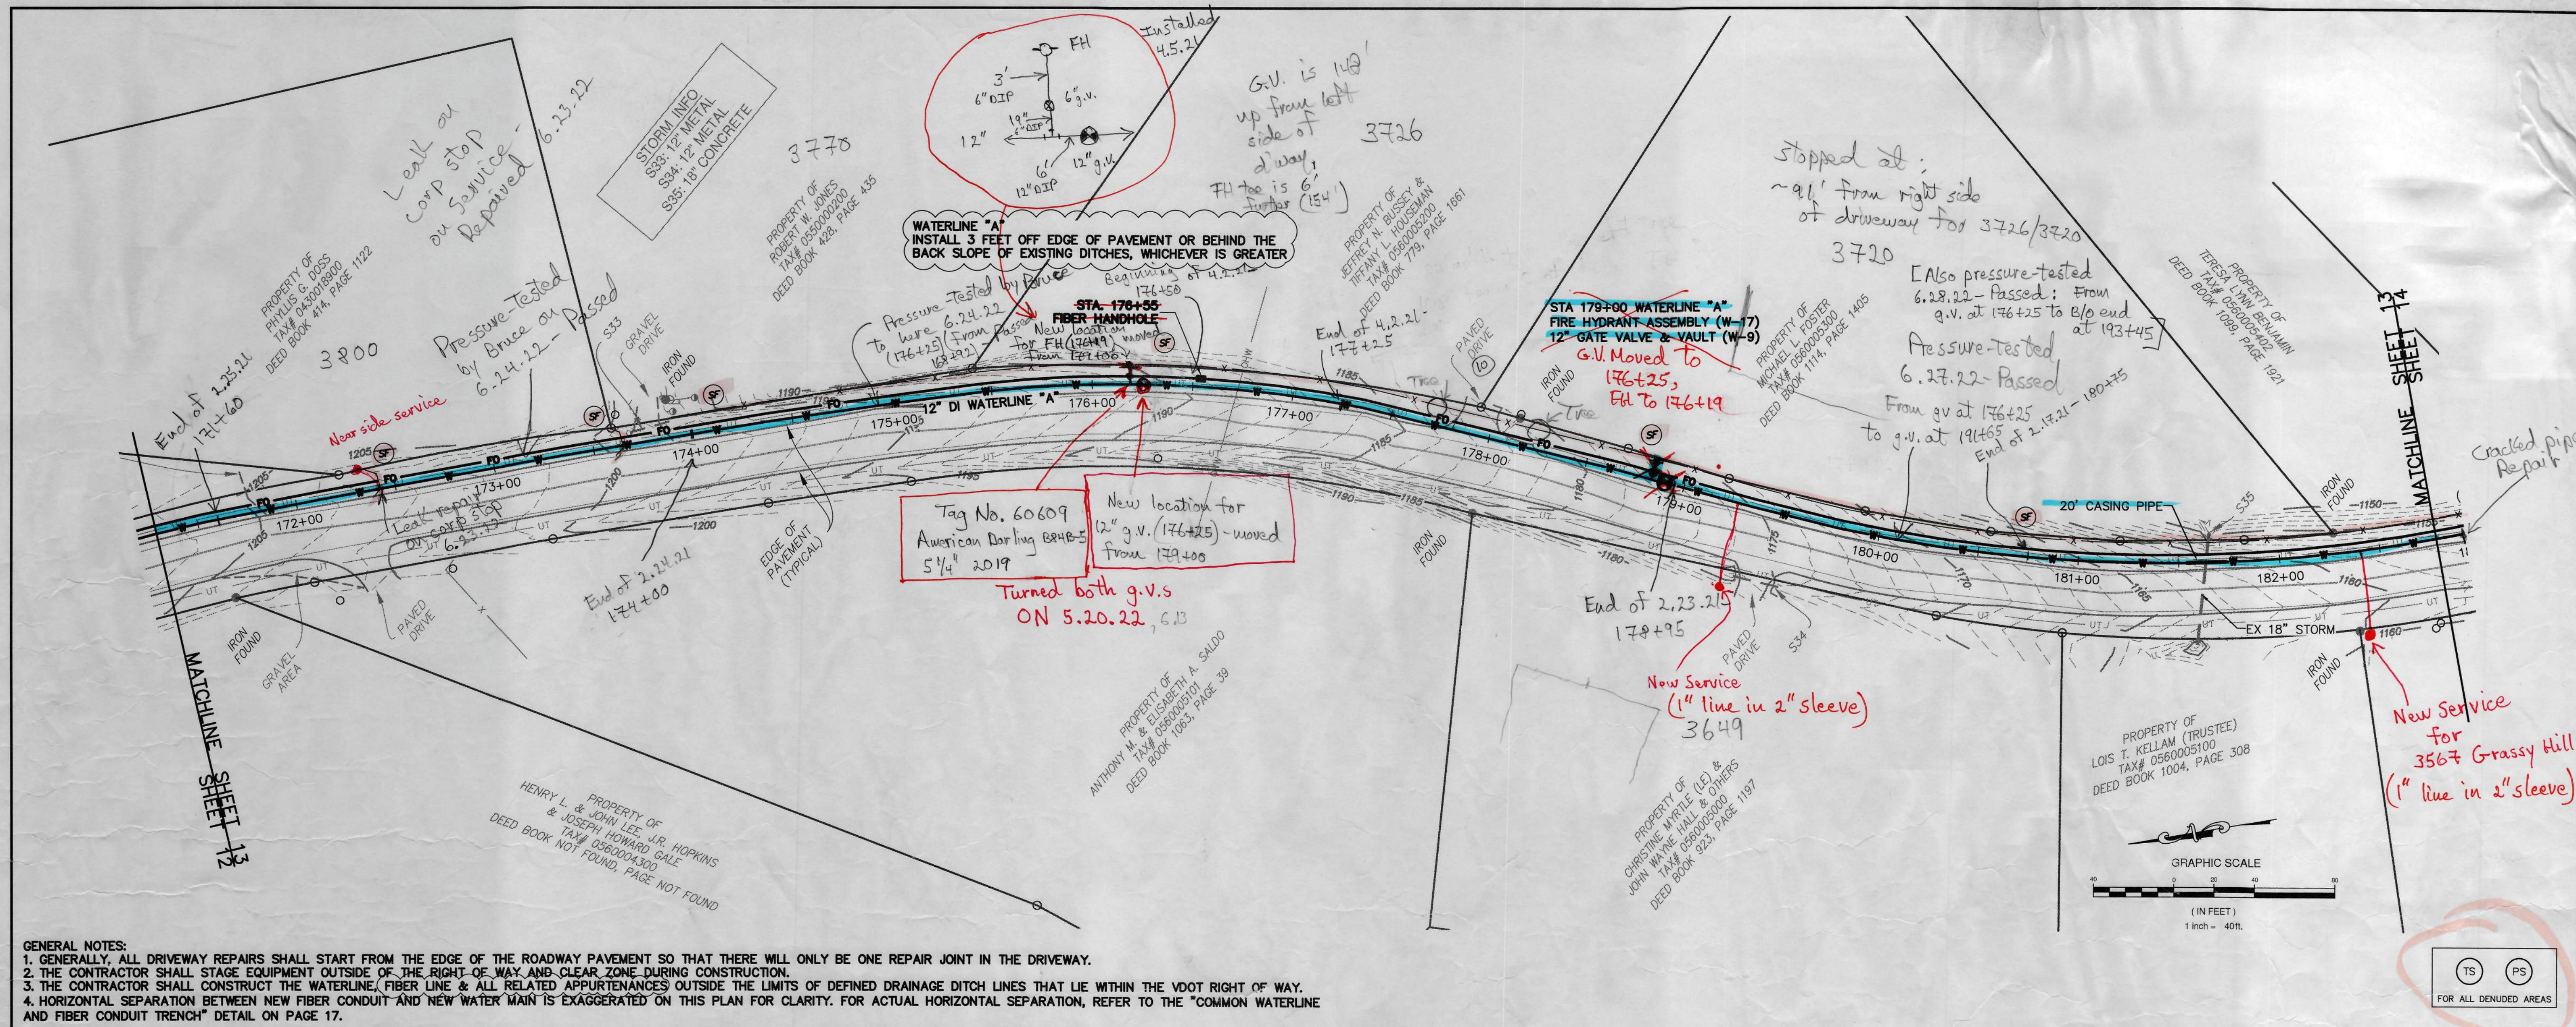

WESTERN VIRGINIA
WATER AUTHORITY

**GRASSY HILL ROAD
WATERLINE EXTENSION**

FRANKLIN COUNTY, VIRGINIA

REVISIONS	
1. ADDRESS VDOT REVIEW COMMENTS -	5/11/20 - DRJ
2. PLAN CHANGES PER WCB & IAS -	6/08/20 - DRJ

DESIGNED BY:	IAS
DRAWN BY:	PDG, DRJ
CHECKED BY:	WCB
SCALE:	1" = 40'
DATE:	FEB 6 2020
PROJECT NUMBER:	WCIP
SHEET TITLE:	PLAN AND PROFILE

13

13 OF 19