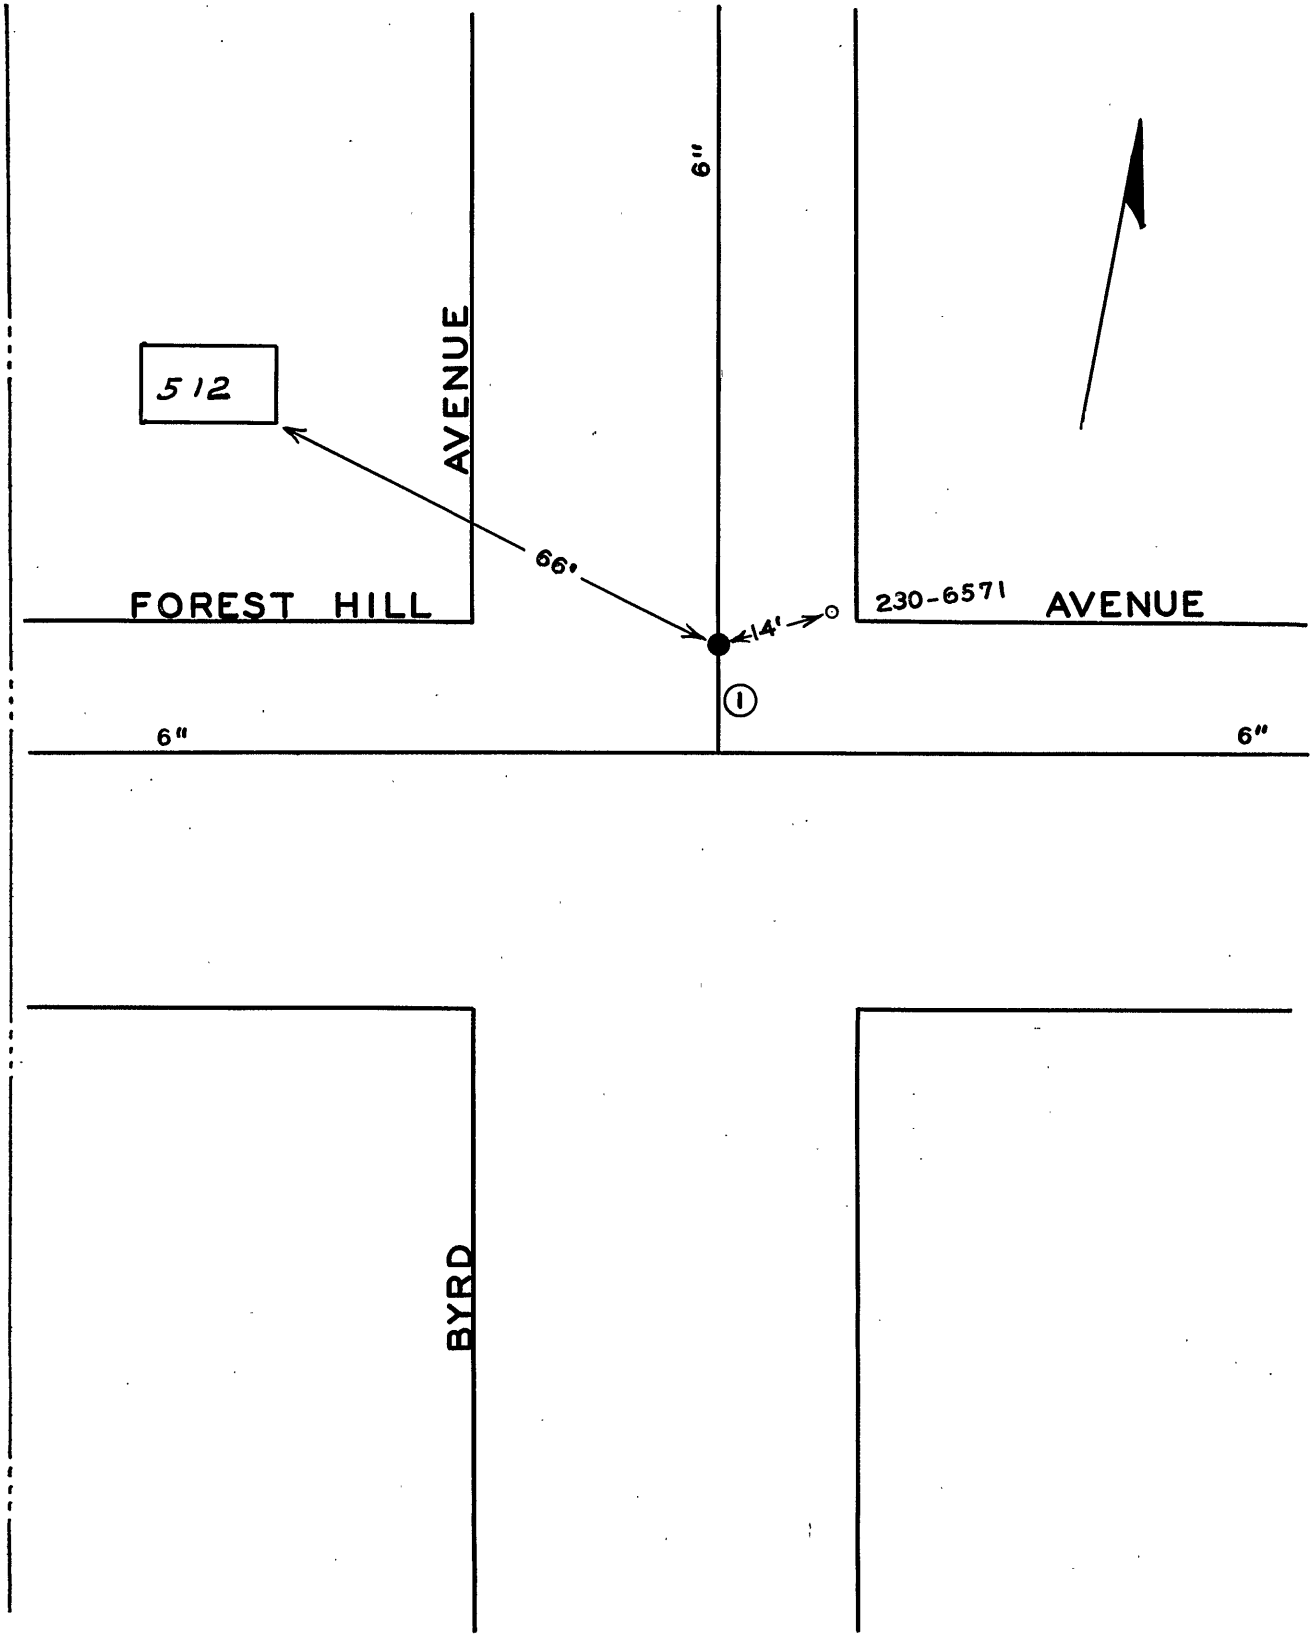

DATE	NO.	SIZE	MAKE	OPEN	TURNS
12-63	1	6"	DARLING	R	
	1	3' S.	N.P.L.		

CITY OF ROANOKE—WATER DEPT.

VALVE DIAGRAM

BYRD AVENUE &

FOREST HILL AVENUE N.E.

SEC. MAP 312

DATE **PAGE NO.**