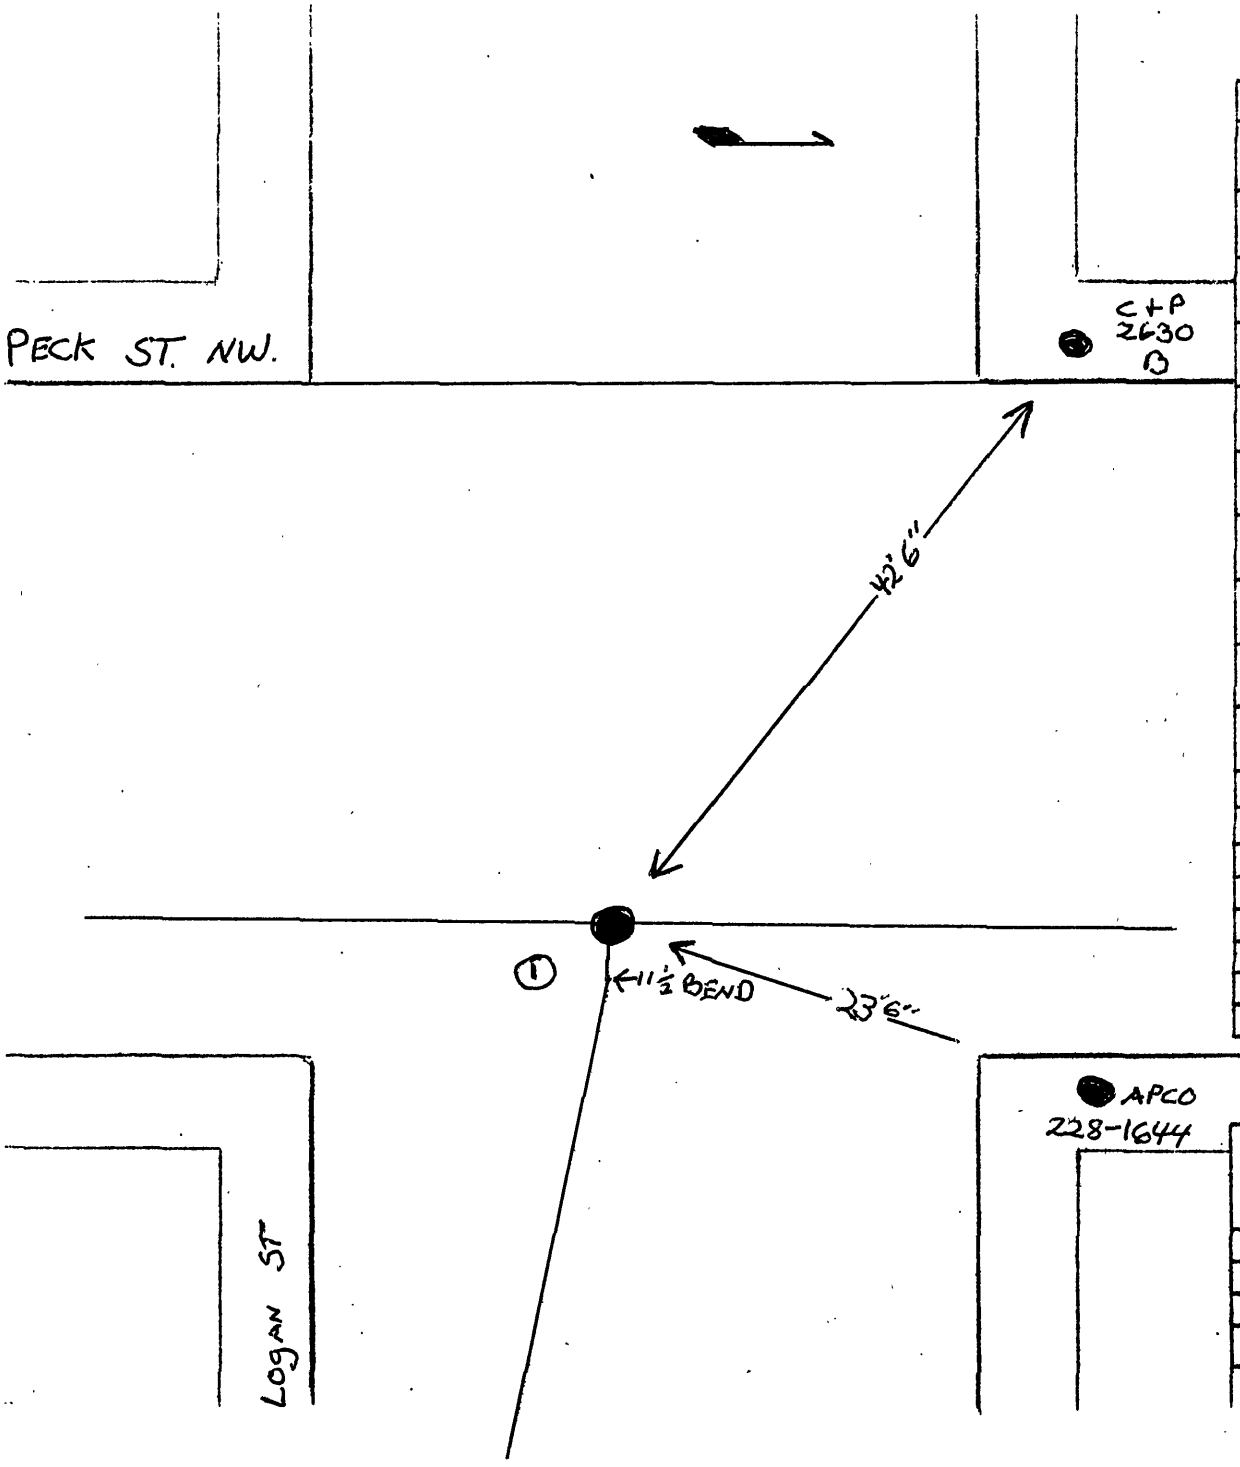

DATE	NO.	SIZE	MAKE	OPEN	TURNS
8-95	1	6"	MUELLER	R	21

P. L. Measurements

No.	Distance	Direction

CITY OF ROANOKE - WATER DEPT.

VALVE DIAGRAM

LOGAN ST. AND PECK ST. NW

Sec. Map 609

Date 8-22-95 Page No.