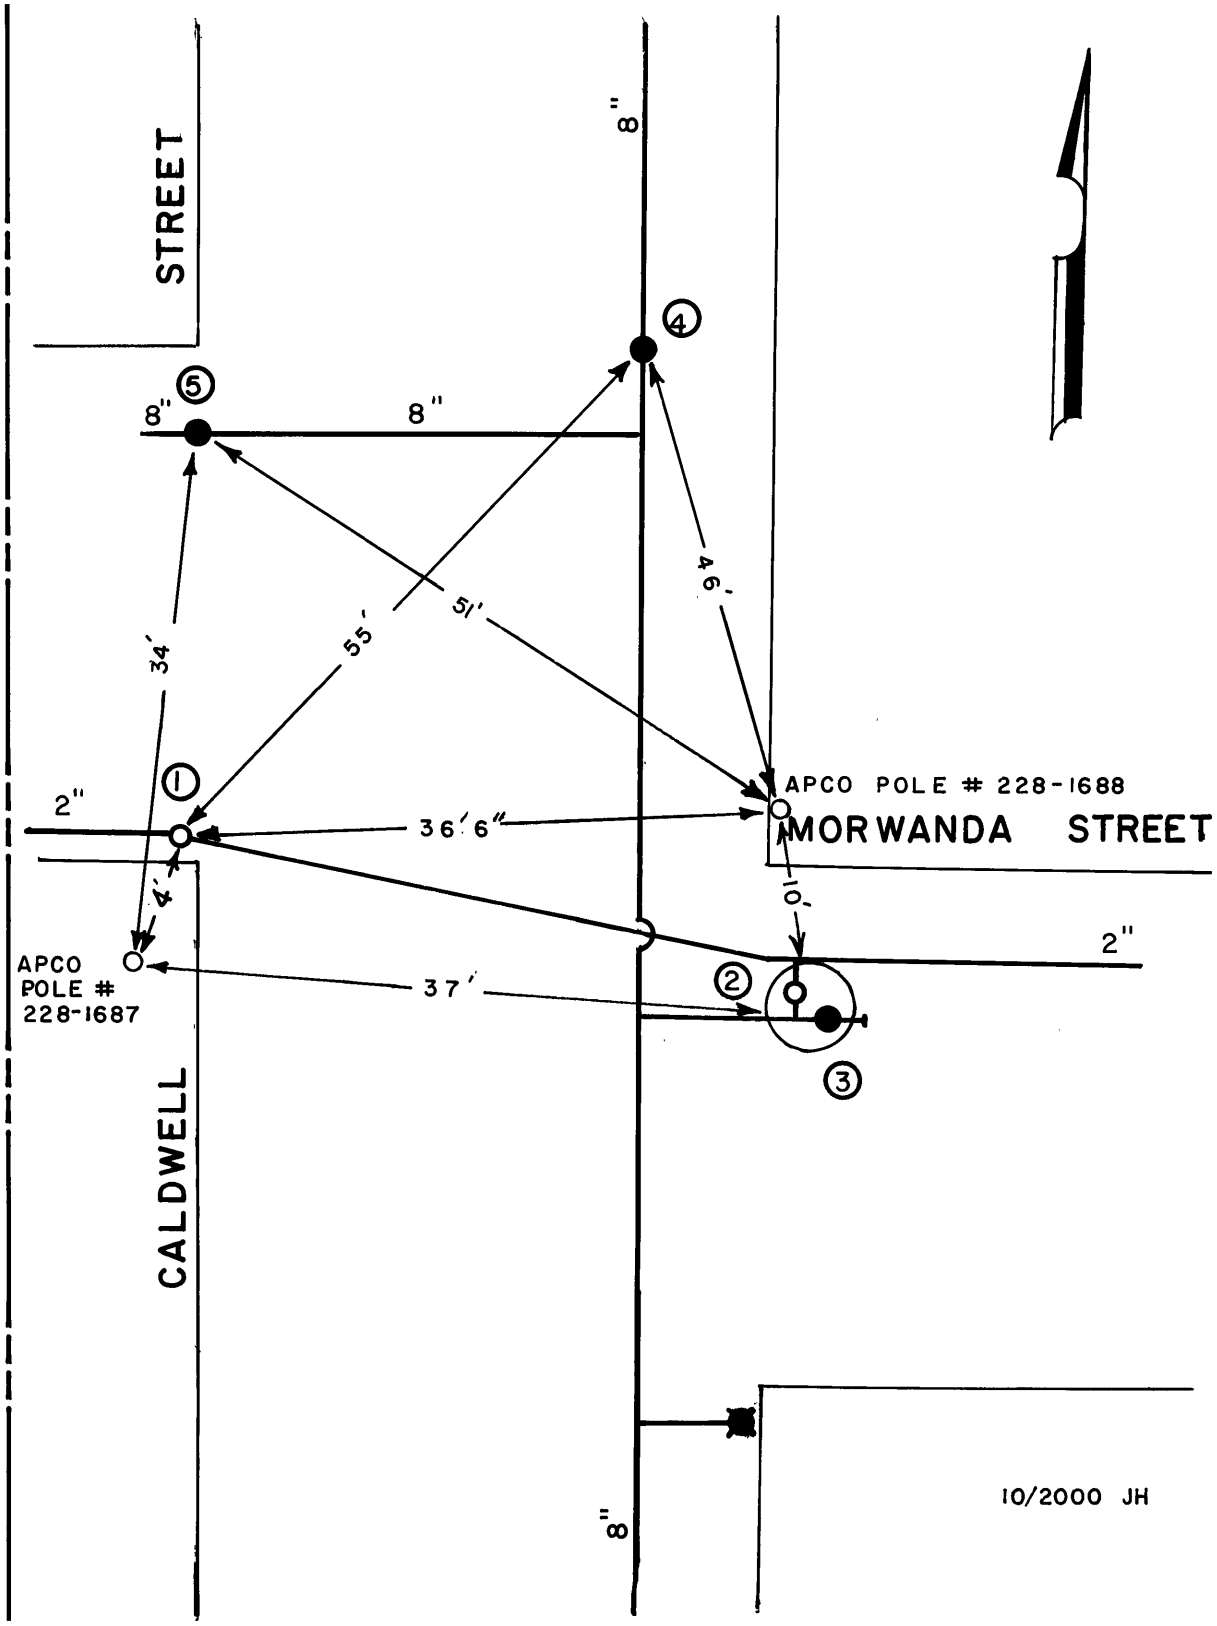

DATE	NO.	SIZE	MAKE	OPEN	TURNS
1977	1	2"	MISC.	L	
1977	2	2"	MISC.	L	
1977	3	8"	MUELLER	R	26
1977	4	8"	MUELLER	R	26
1977	5	8"	MUELLER	R	26

CITY OF ROANOKE - WATER DEP'T.

VALVE DIAGRAM

CALDWELL STREET &
MORWANDA STREET

SEC. MAP 608 N.W.

DATE: PAGE NO.