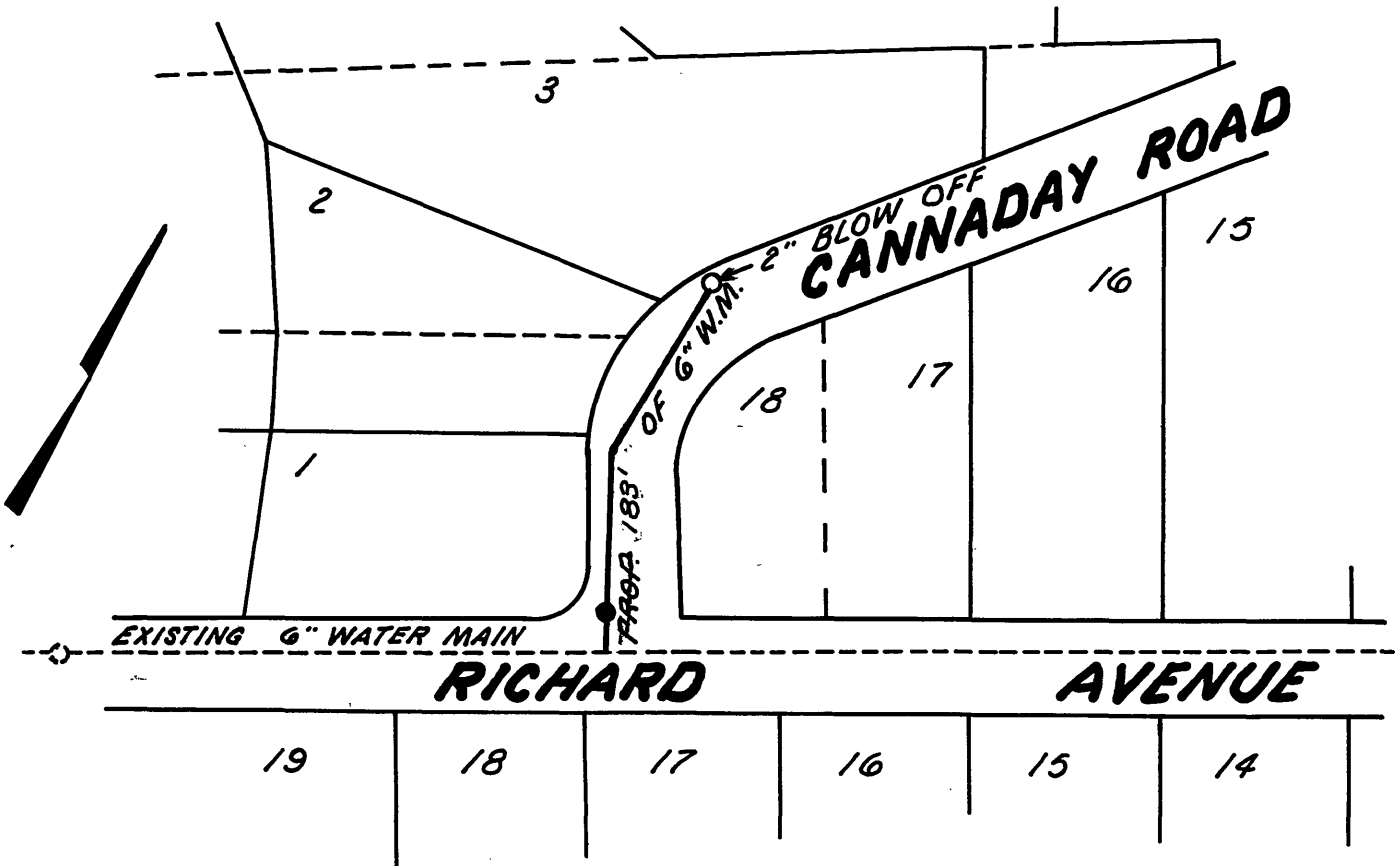

NOTE: EXISTING UTILITIES TO BE ASCERTAINED IN FIELD PRIOR TO CONSTRUCTION.

DIRECTOR UTILITIES & OPERATIONS	12-20-76 DATE
CITY ENGINEER OF ROANOKE, VA.	12-20-76 DATE
DIRECTOR OF PUBLIC WORKS	12-21-76 DATE
AGENT FOR ROANOKE PLANNING COMM.	12-20-76 DATE

DATE STARTED 5-19-78				
DATE COMP. 5-23-1978				
FEET MAIN	SIZE	VALVE	VAULT	BOX
~~185~~ 183'	6"	1	✓	#2
	2" BLOWOFF			#1
F. H. COMP. ____				
F. H. STUB ONLY ____				

SERV. INS. BY: U.L.F.
MAIN INS. BY: U.L.E.
NO. ¾" SERV. INS. 2
CITY ~~OR~~ CO.
DEPT. INSP. J.W.M.

LIST OF MATERIALS:
200'± 6" Ductile Iron Pipe
6" Tapping Sleeve & Valve
1 Valve Vault
1 Valve Box
1 - 2" Valve

CANNADAY ROAD
WATER DEPARTMENT
CITY OF ROANOKE, VA.
SCALE: 1" = 100'
DRWN: L. H. LOGAN 12-13-76
76-23

T#707