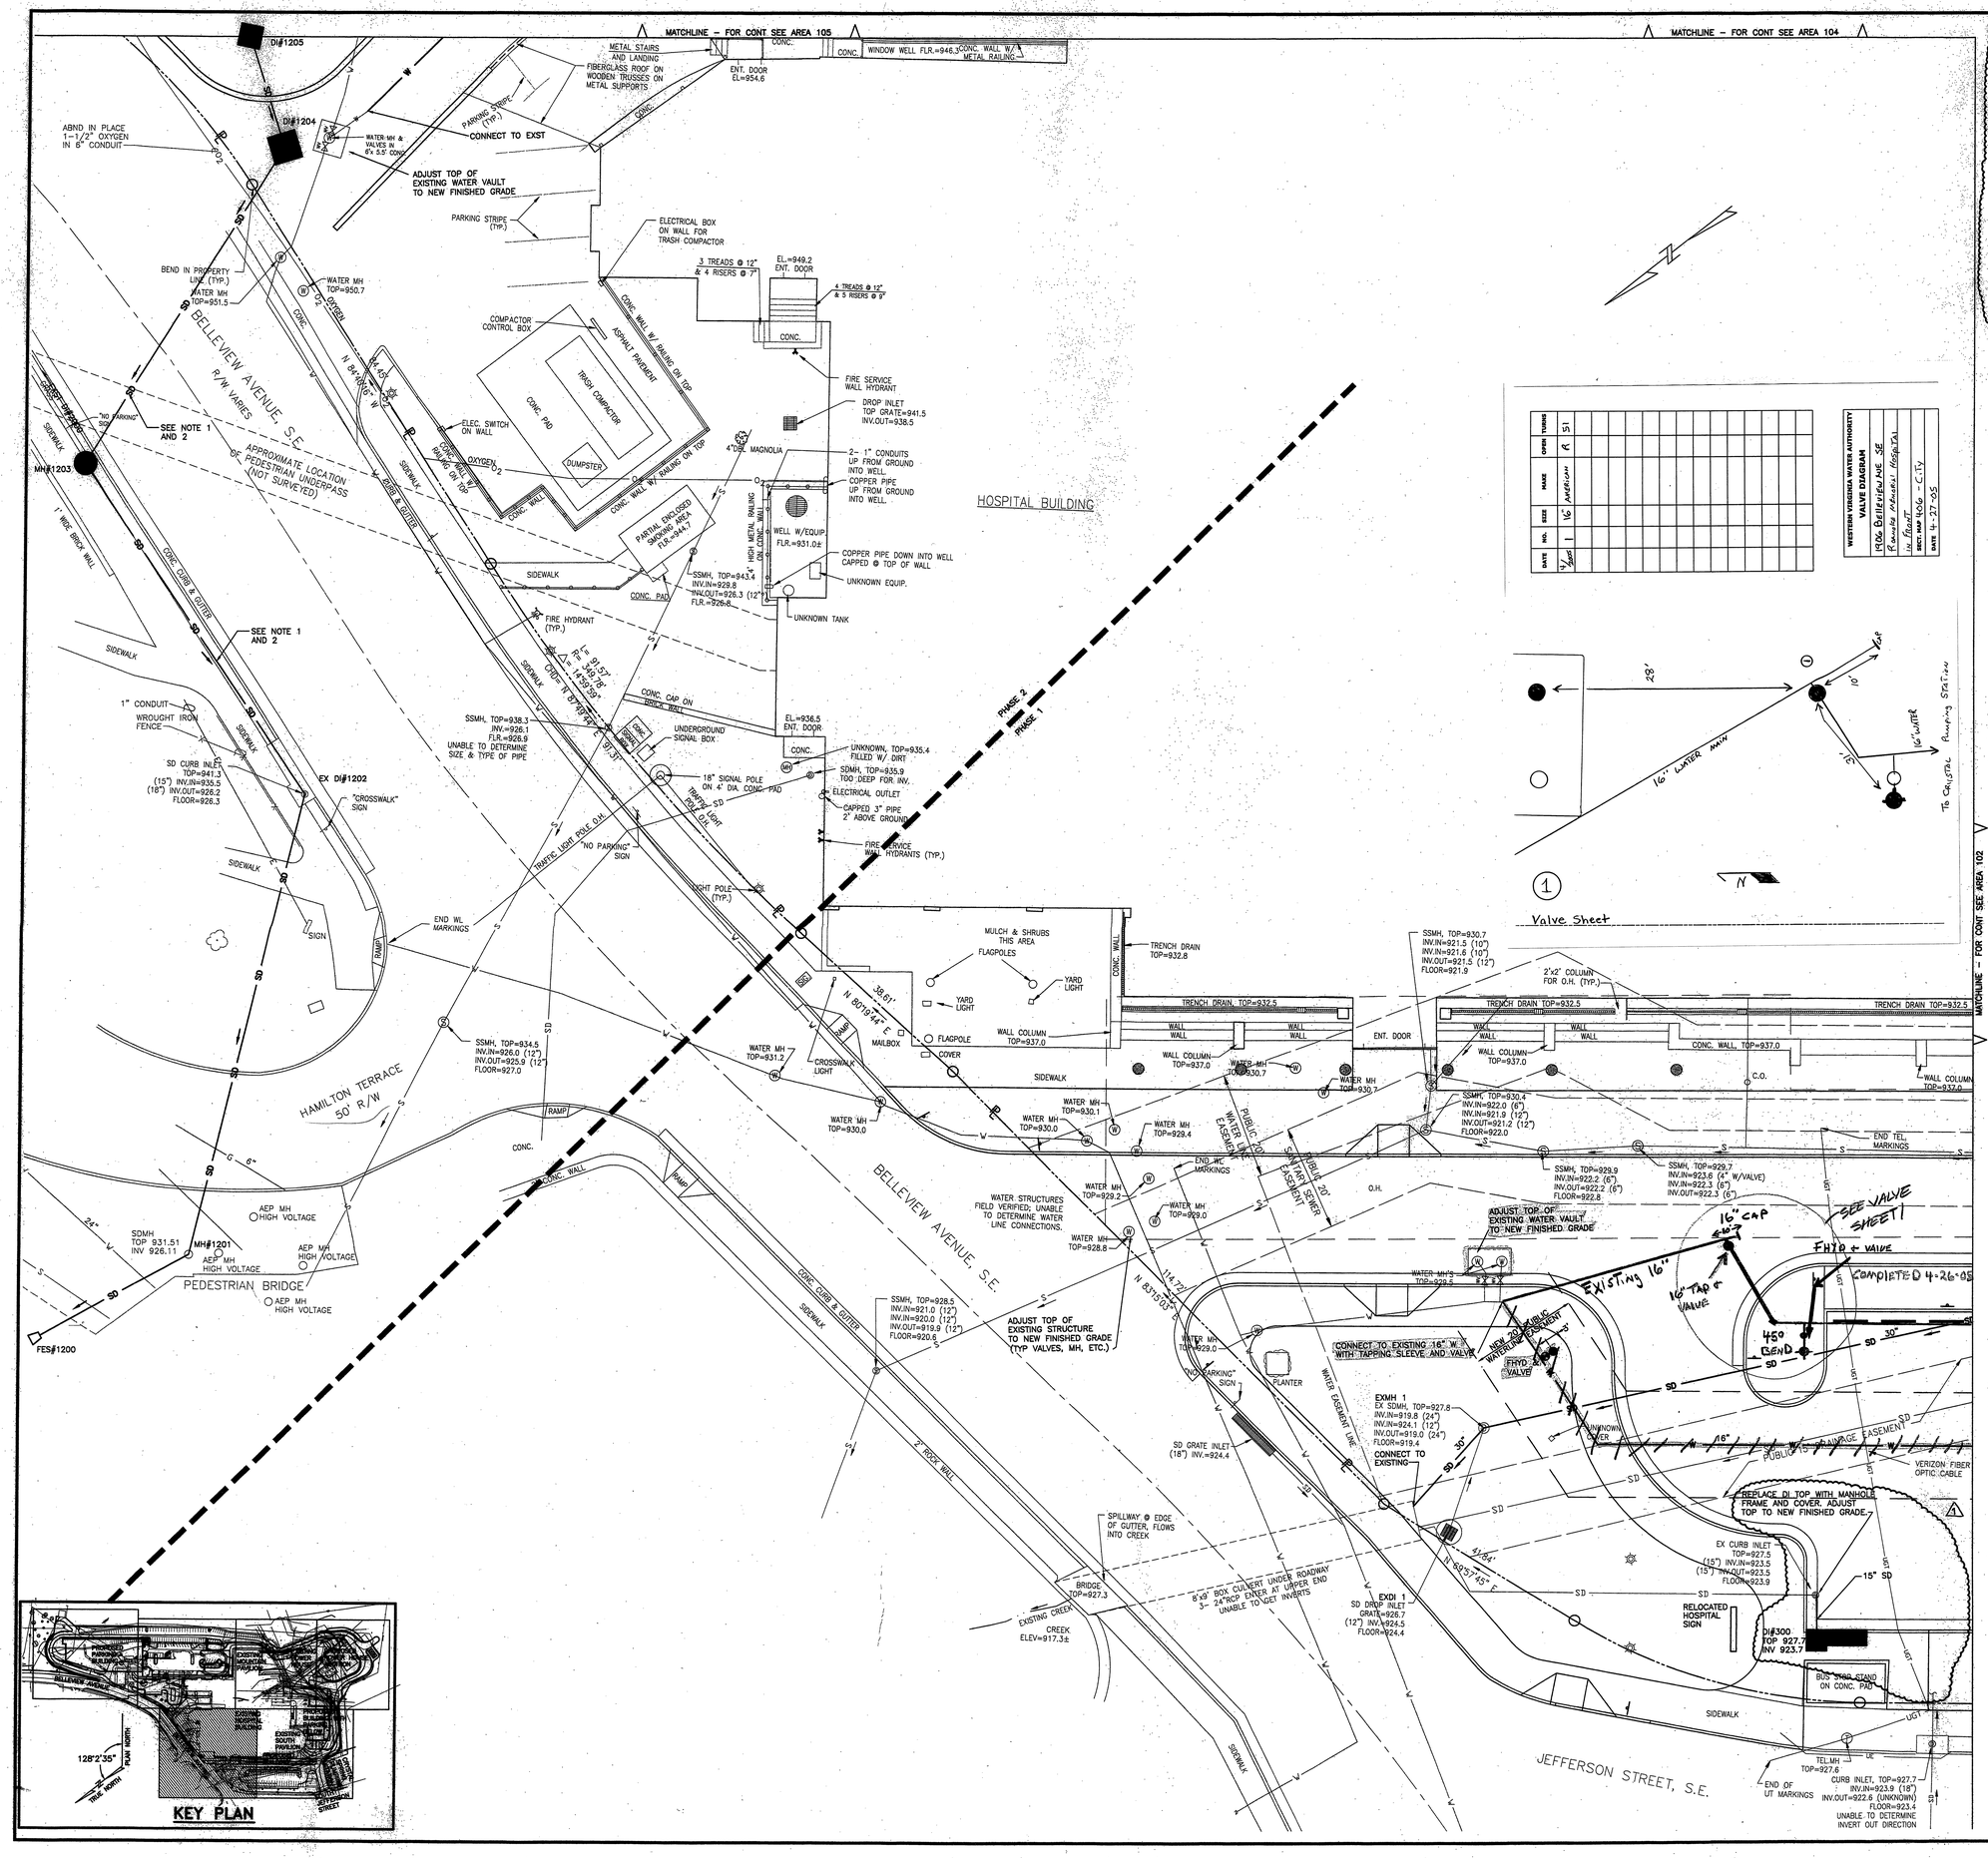

GENERAL UTILITIES NOTES:

1. CONTRACTOR SHALL MAINTAIN TWO-WAY TRAFFIC WHEN PRACTICAL WHEN WORKING WITHIN EXISTING STREETS. THE CONTRACTOR SHALL PLACE SIGNS, DANGER LIGHTS, BARRICADES, AND FURNISH FLAGMEN TO DIRECT TRAFFIC IN ACCORDANCE WITH THE WORK AREA TRAFFIC CONTROL HANDBOOK.
2. ALL PAVEMENT, CURBS, AND GUTTERS DISTURBED FOR INSTALLATION OF UTILITIES ALONG EXISTING ROADS SHALL BE RESTORED TO ORIGINAL CONDITION, INCLUDING PAVEMENT MARKINGS, IMMEDIATELY FOLLOWING THE INSTALLATION.
3. THE CITY OF ROANOKE'S UTILITY LINE SERVICES WILL MAKE THE CONNECTION TO THE SEWER MAIN FOLLOWING EXCAVATION AND SHORING PER OSHA REGULATIONS BY THE CONTRACTOR. A SEWER TAP FEE WILL BE CHARGED. TO SCHEDULE THE TAP OF THE SEWER MAIN OR MANHOLE, CONTACT UTILITY LINES SERVICES AT 540-853-2792, TWO (2) DAYS PRIOR TO THE ANTICIPATED DATE. THE MANHOLE TAP IS NEEDED. SEWER FEES SHOULD BE PAID AT LEAST ONE WEEK PRIOR TO THE DATE SEWER HOOKUP IS NEEDED.
4. THE WATER CONNECTION IS TO BE DONE BY THE CITY OF ROANOKE. A CONNECTION FEE WILL BE CHARGED WHICH WILL INCLUDE THE PUBLIC SERVICE LINE FROM MAIN TO METER, METER VAULT AND WATER METER AT THE PROPERTY LINE. PLEASE CONTACT THE CITY OF ROANOKE'S BILLINGS AND COLLECTIONS OFFICE, AT 540-853-6818 TO COORDINATE PAYMENT OF THE ABOVE REFERENCED WATER AND SEWER FEES. WATER FEES SHOULD BE PAID APPROXIMATELY EIGHT WEEKS PRIOR TO THE DATE OF WATER IS NEEDED.
5. CONTRACTOR SHALL ADHERE TO WESTERN VIRGINIA WATER AUTHORITY REGULATIONS AND CONSTRUCTION GUIDELINES AND REGULATIONS.

DATE	NO.	SIZE	MAKE	OPEN TURNS

WESTERN VIRGINIA WATER AUTHORITY
VALVE DIAGRAM
1906 Belleview NE SE
Roanoke Memorial Hospital
in front
SECT. MAP 406 - C.TY
DATE 4-27-05

SEALS

CONSULTANT
HELLMUTH, OBATA + KASSABAUM, INC.
ARCHITECTURE, ENGINEERING, PLANNING, INTERIORS, SPORTS/EXPOSITIONS
St. Louis, Missouri 63102 USA

CARILION Health System
CMC CONSOLIDATION
CARILION ROANOKE MEMORIAL HOSPITAL
ROANOKE, VIRGINIA

HSMM
ARCHITECTS ENGINEERS PLANNERS
HAYES, SEAY, MATTERN, & MATTERN, INC.
1315 FRANKLIN ROAD
ROANOKE, VA 24012
(540) 857-3100 WWW.HSMM.COM

REV	DATE	DESCRIPTION	APP
1	7/9/04	PHASE 1 AND II SITE PACKAGE SUBMITTAL	BJC

COMM. NO:	40044A
ISSUE DATE:	JUN 04, 2004
DESIGNED BY:	MJD
DRAWN BY:	TJG
CHECKED BY:	MJC
SUBMITTED BY:	BJC

© HAYES, SEAY, MATTERN, & MATTERN, INC., 2004. ALL RIGHTS RESERVED.

CIVIL

UTILITY PLAN

CU101

M:\FILES\40000SERIES\40044\CADD\DWG\SITE\EL3CU101.DWG C40044 07/08/2004 15:20:41 MDEEL
HSMM-Full.ctb RF: el3cex,el3ckx,el3gxbdr,el3cux,el3csx,??ph4esx??,el3esx