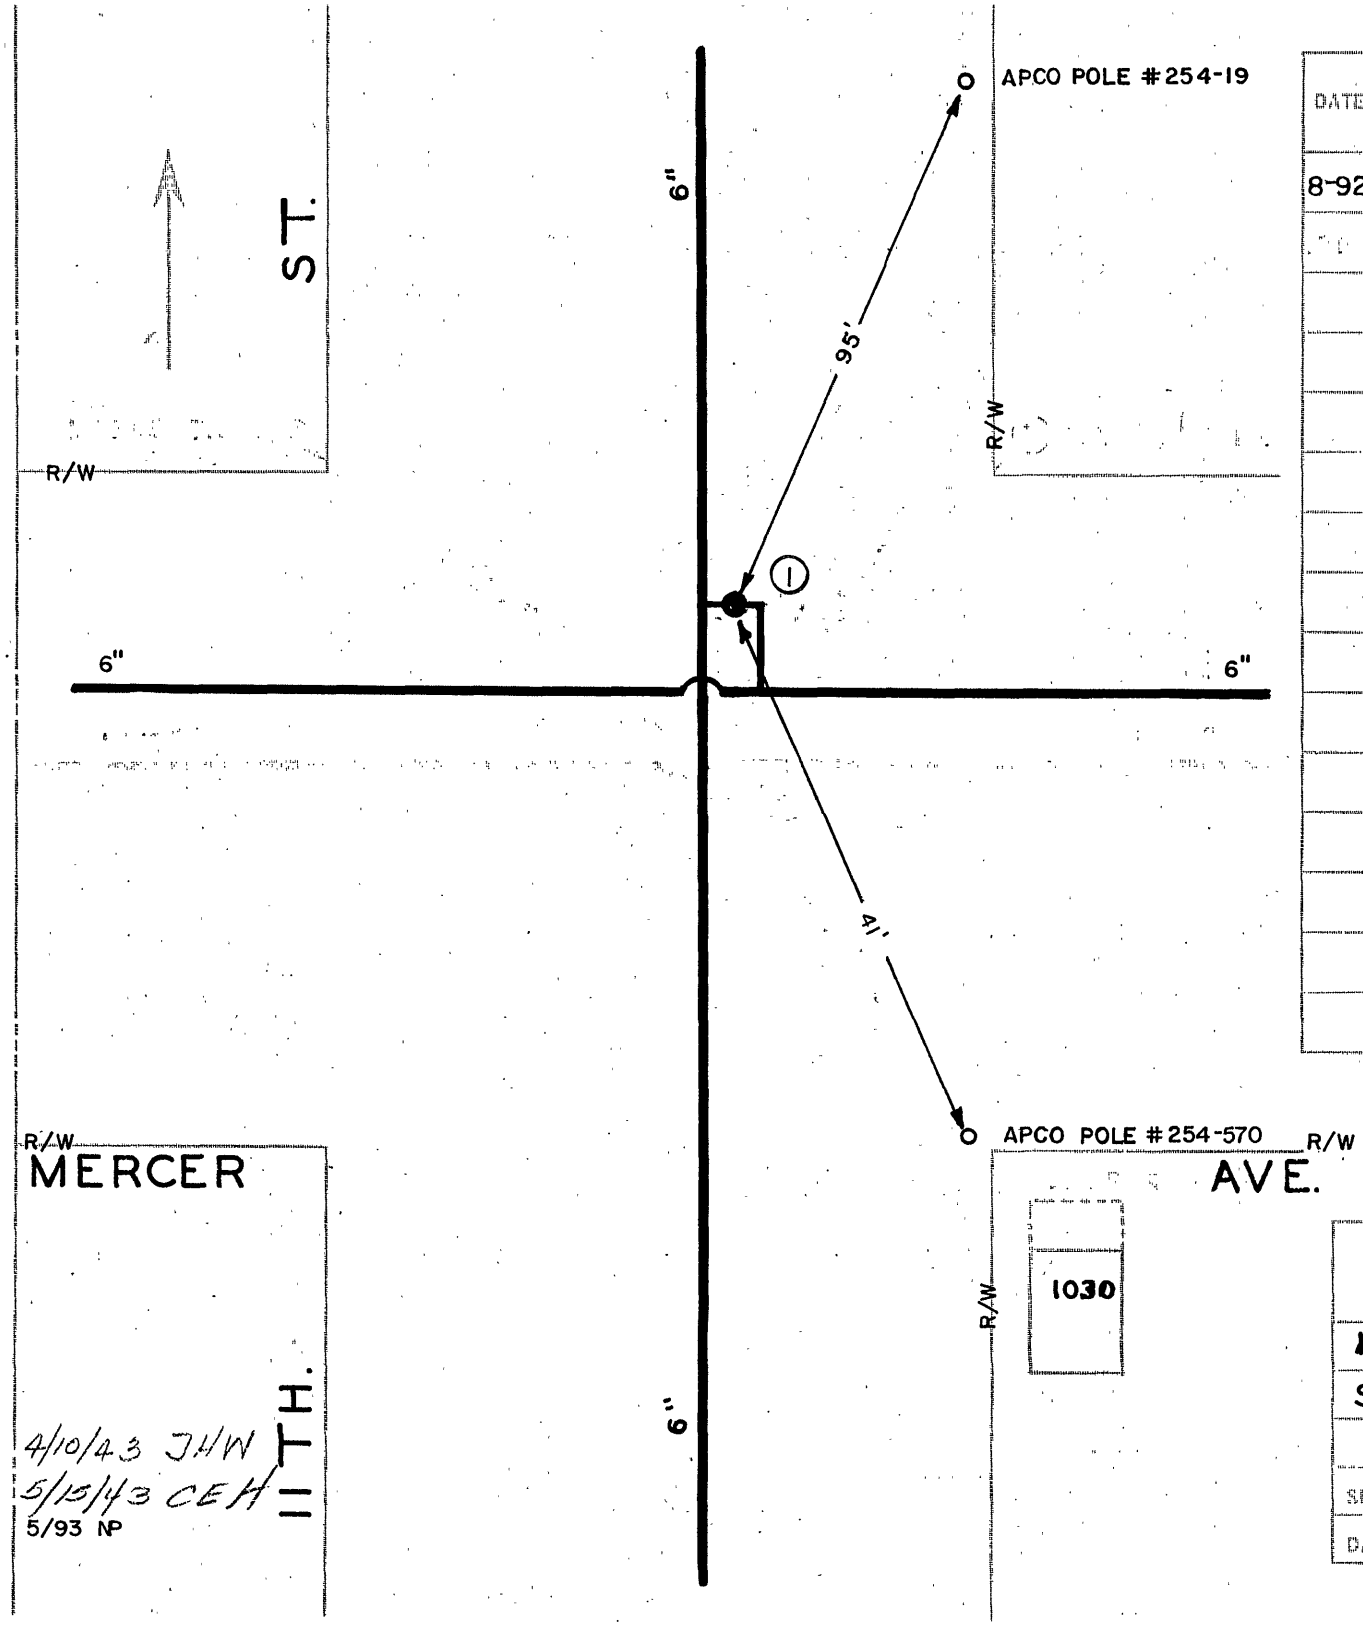


| DATE | NO. | SIZE | MAKE | OPEN | TURNS |
|---|---|---|---|---|---|
| 8-92 | 1 | 6" | MUELLER | R | |
| | | | | | |
| | | | | | |
CITY OF ROANOKE—WATER DEP'T

VALVE DIAGRAM

MERCER AVE. & 11TH. ST. N.W.

SEC. MAP 223

DATE

PAGE NO. NW.166