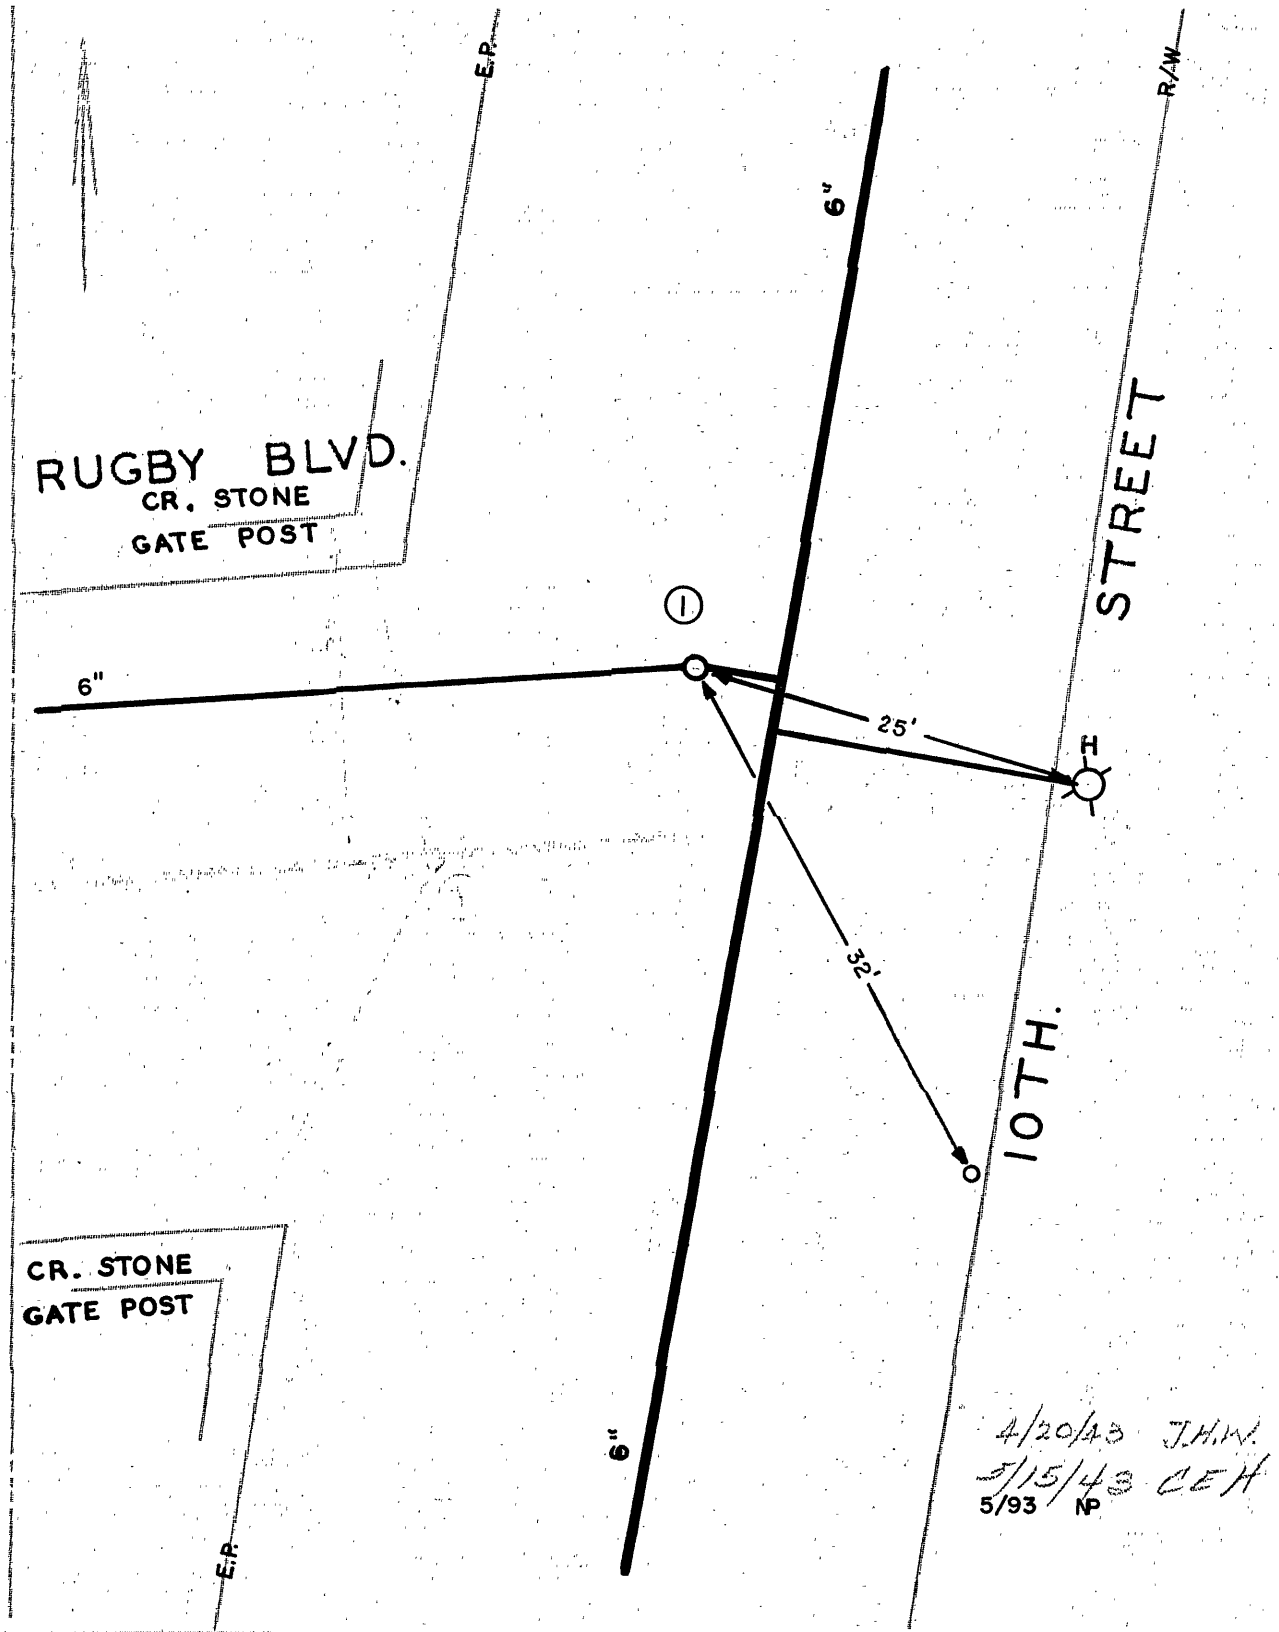

DATE	NO.	SIZE	MAKE	OPEN	TURNS
9-92	1	6"	MUELLER	R	19

CITY OF ROANOKE—WATER DEP'T

VALVE DIAGRAM

RUGBY BLVD. & 10TH. ST. N.W.

SEC. MAP 223

DATE

PAGE NO. NW.169