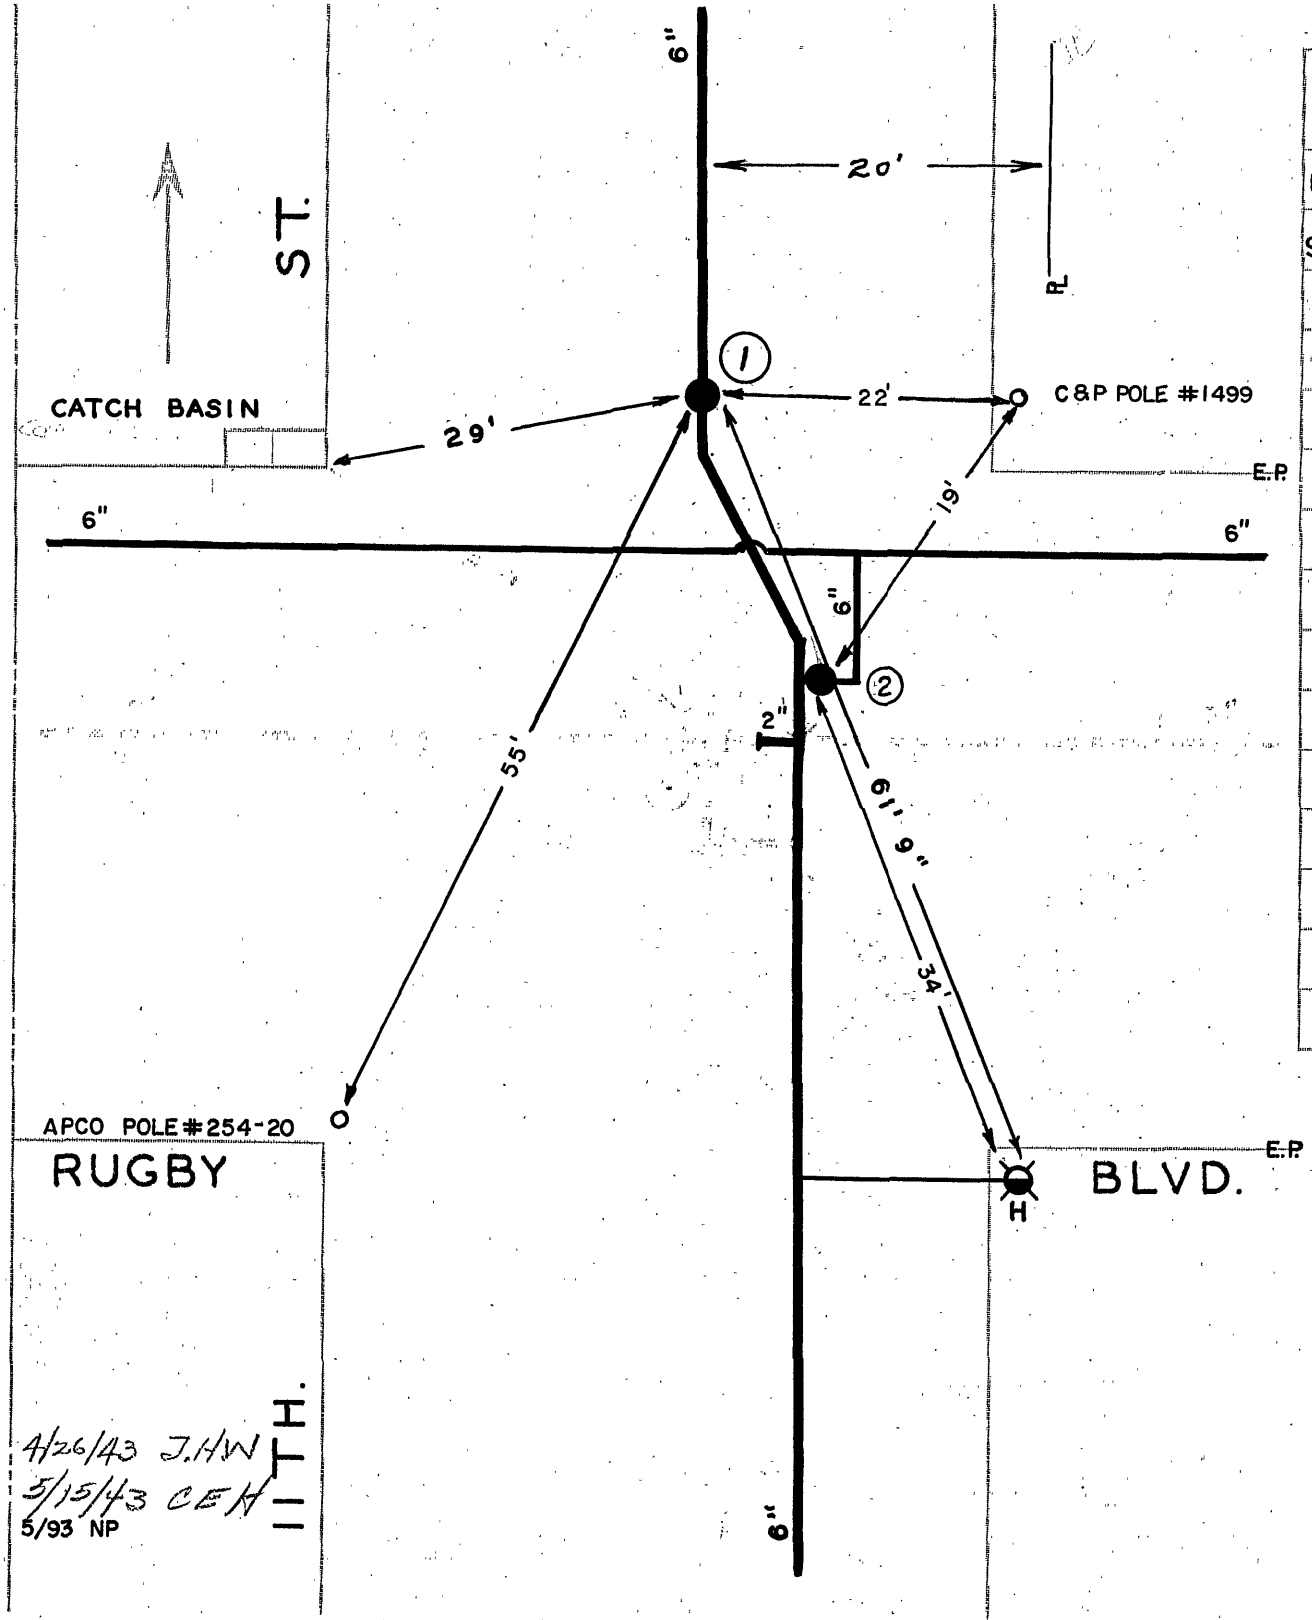

DATE	NO.	SIZE	MAKE	OPEN	TURNS
1939	1	6"		R	20
9-92	2	6"	MUELLER	R	19
	1	0	NPL		

CITY OF ROANOKE — WATER DEP'T

VALVE DIAGRAM

RUGBY BLVD & 11TH. ST. N. W.

SEC. MAP 223

DATE

PAGE NO. N.W. 170