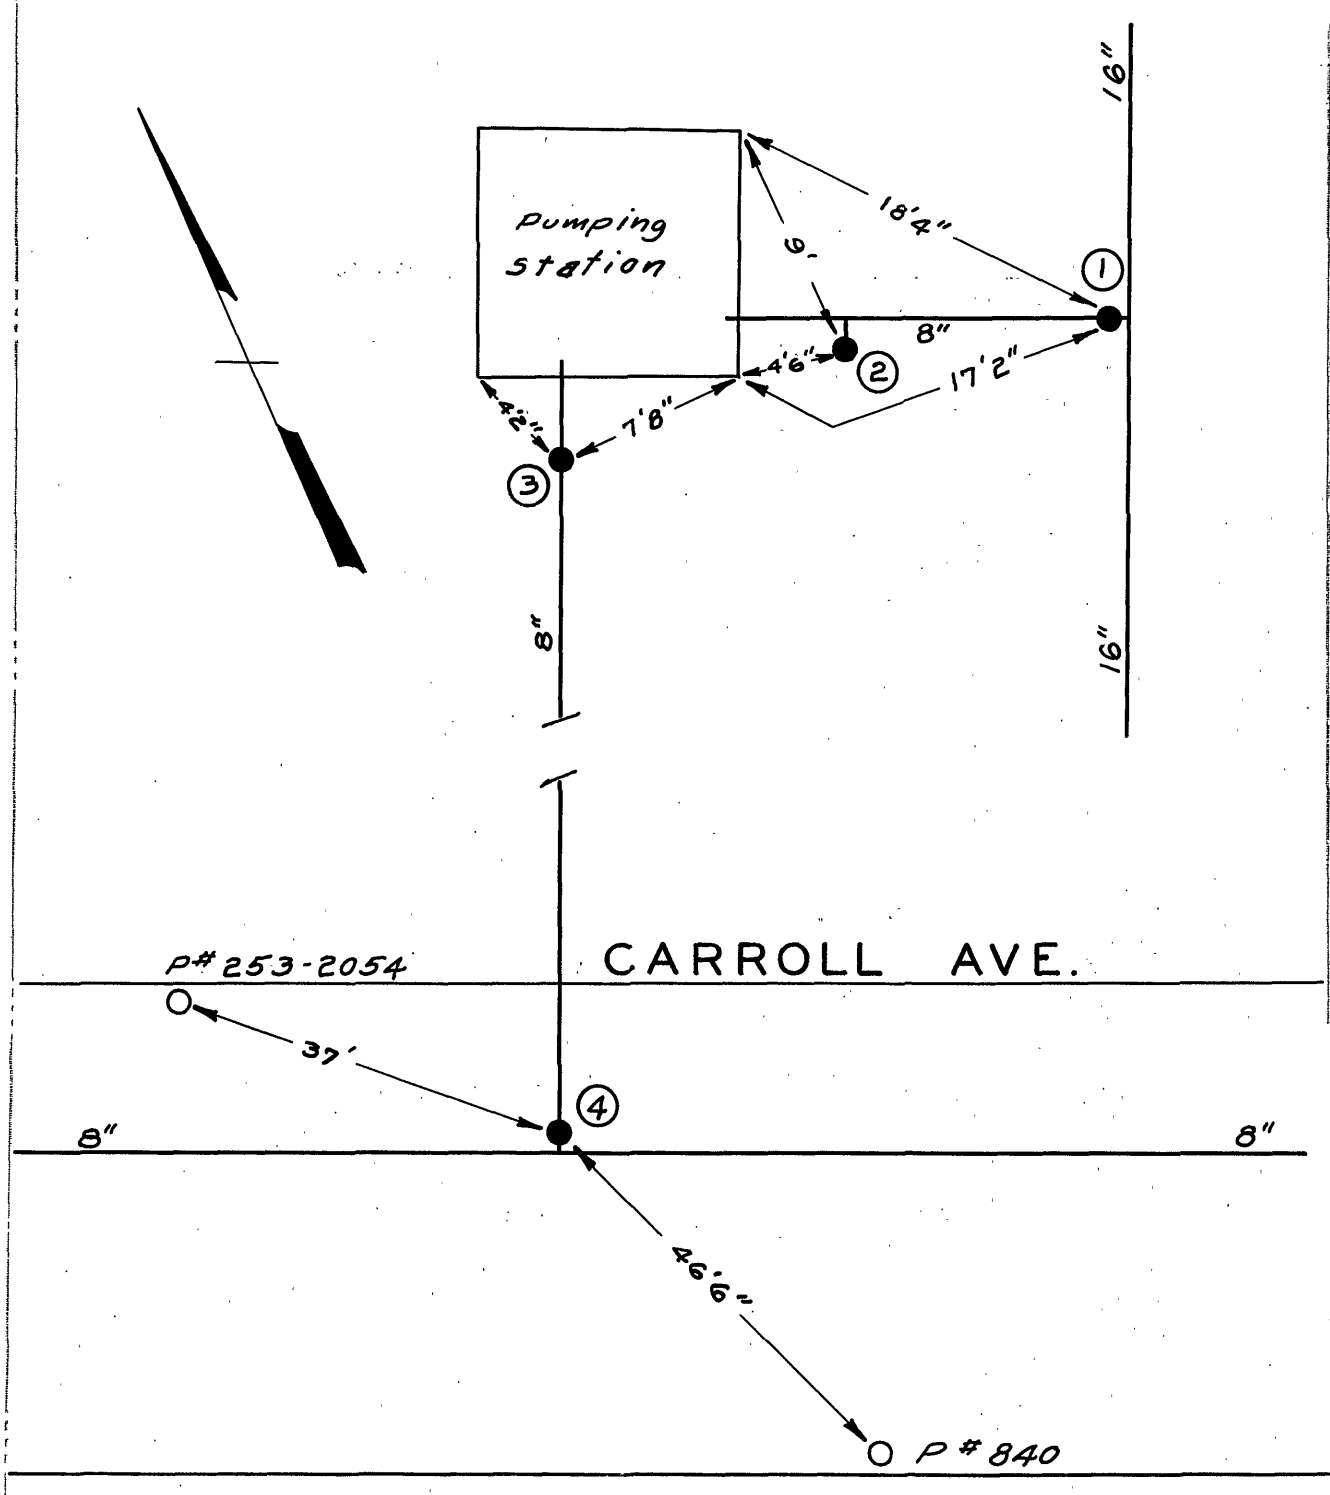

DATE	NO.	SIZE	MAKE	OPEN	TURNS
'59	1	8"		R	
'59	2	3/4"	DRAIN		
'59	3	6"	METER		
'59	4	8"	WITH 3/4" DRAIN	R	

CITY OF ROANOKE—WATER DEPT.

VALVE DIAGRAM

CARROLL AVENUE

PUMPING STATION

N.W.

SEC. MAP 234

DATE PAGE NO.