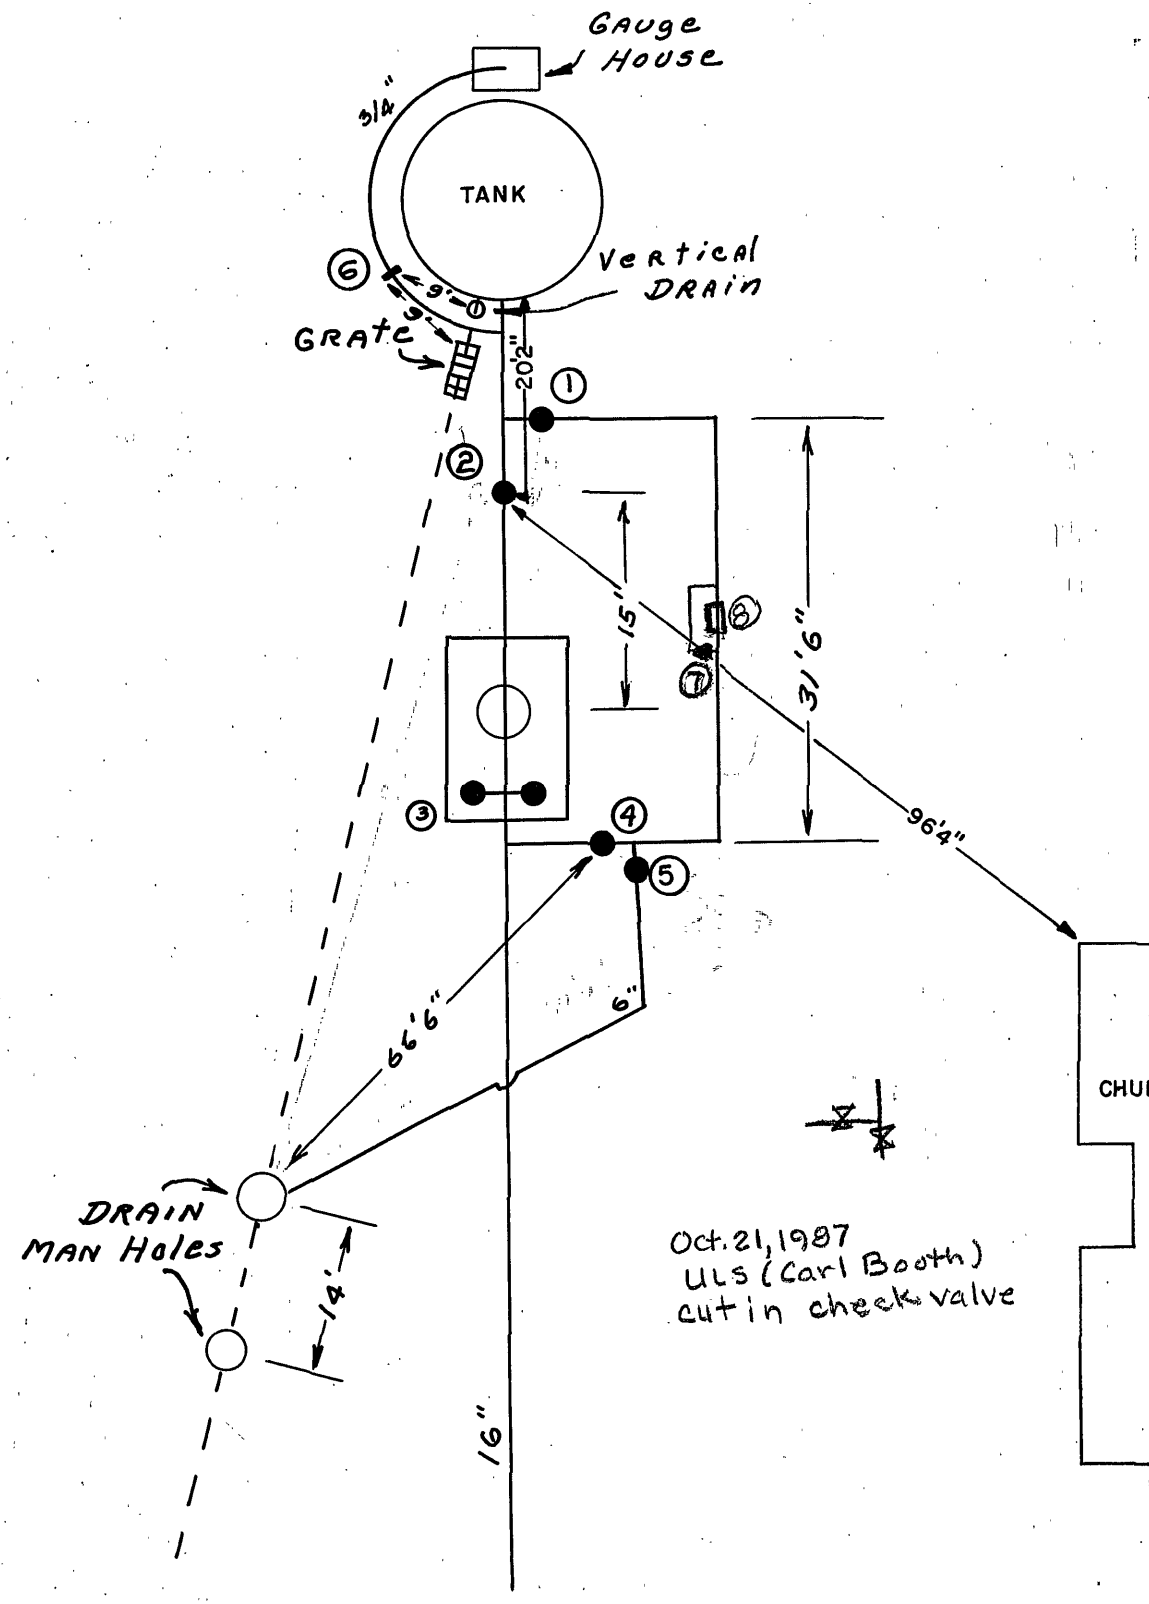

DATE	NO.	SIZE	MAKE	OPEN	TURNS
1946	1	6"		R	
1993	2	16"	DARLING	R	
1946	3	16"	DARLING	R	
1946	4	6"		R	
1946	5	6"		R	
1946	6	3/4"	CURBCOCK		
1987	7	8"	BYPASS	R	
1987	8	8"	CHECK VALVE		

CITY OF ROANOKE — WATER DEPT.

VALVE DIAGRAM

CARROLL AVE. WATER TANK N.W.

SEC. MAP 234

DATE PAGE NO.

"IMPERIAL" TRACING CLOTH
K & E CO., N.Y.