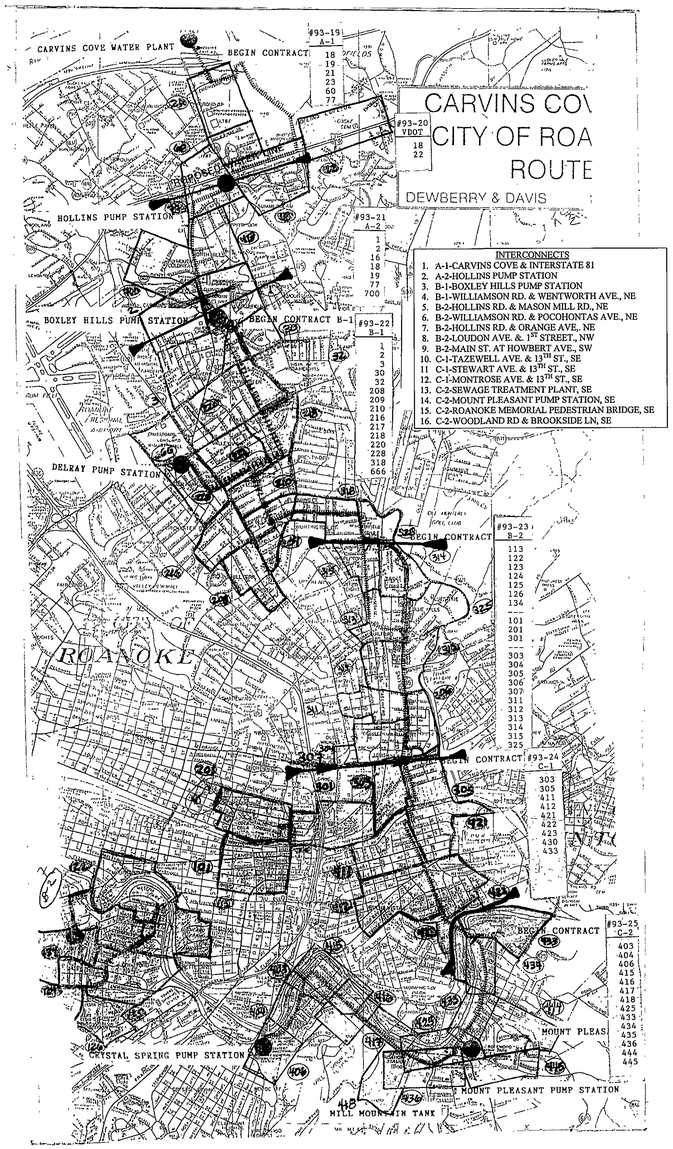

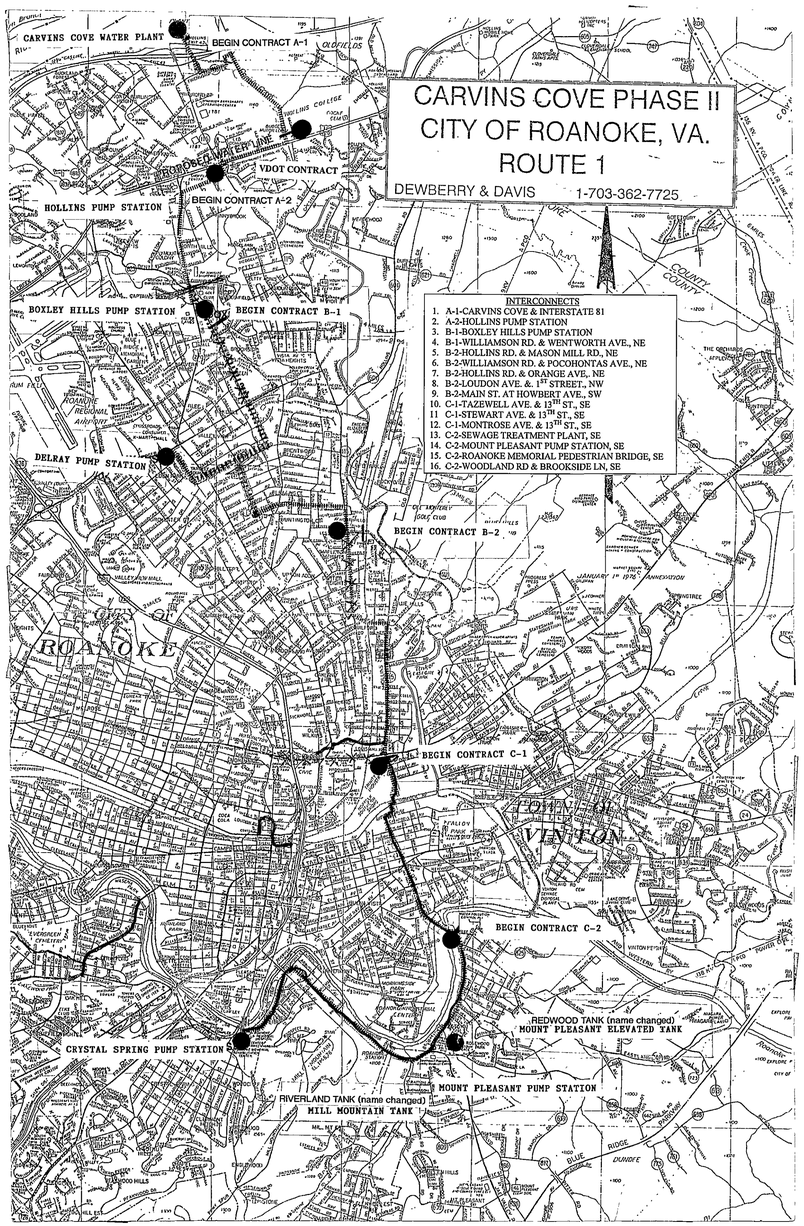

CO: = completed project

CARVINS COVE PROJECT 1995
Drawn: 1993

(CO:4/28/95) #93-19 (A-1)	(CO: 195) #93-20 (VDOT)	(CO:5/24/96) #93-21 (A-2)	(CO:4/30/95) #93-22 (B-1)	(CO:5/10/95) #93-23 (B-2)
RO.CO.18.00	RO.CO.27.07	RO.CO.27.11	1	113
" 18.18	" 27.08	1	2	122
" 18.19	" 27.11	2	3	123
" 27.06	" 27.12	16	30	124
" 27.07	18	18	32	125
" 27.10		19	208	126
18		77	209	134
19		700	210	----
23			216	101
	VDOT	(Boxley to B-1) Hanner Gaye (Contractor) & (VDOT to Boxley) Laramore (Contractor)	217	201
Aaron J. Connor (Contractor)	(Contractor)		218	301
			220	----
			228	303
			318	304
			666	305
			Hanner Gaye (Contractor)	306
				307
				311
				312
				313
				314
				315
				325
				Aaron J. Connor General Contractor, Inc (Contractor)

(CO:4/24/95) #93-24 (C-1)	(CO:1/31/95) #93-25 (C-2)
303	403
305	404
411	406
412	415
421	416
422	417
423	418
430	425
433	433
	434
	435
E.C. Pace (Contractor)	436
	444
	445
	Hanner Gaye (Contractor)