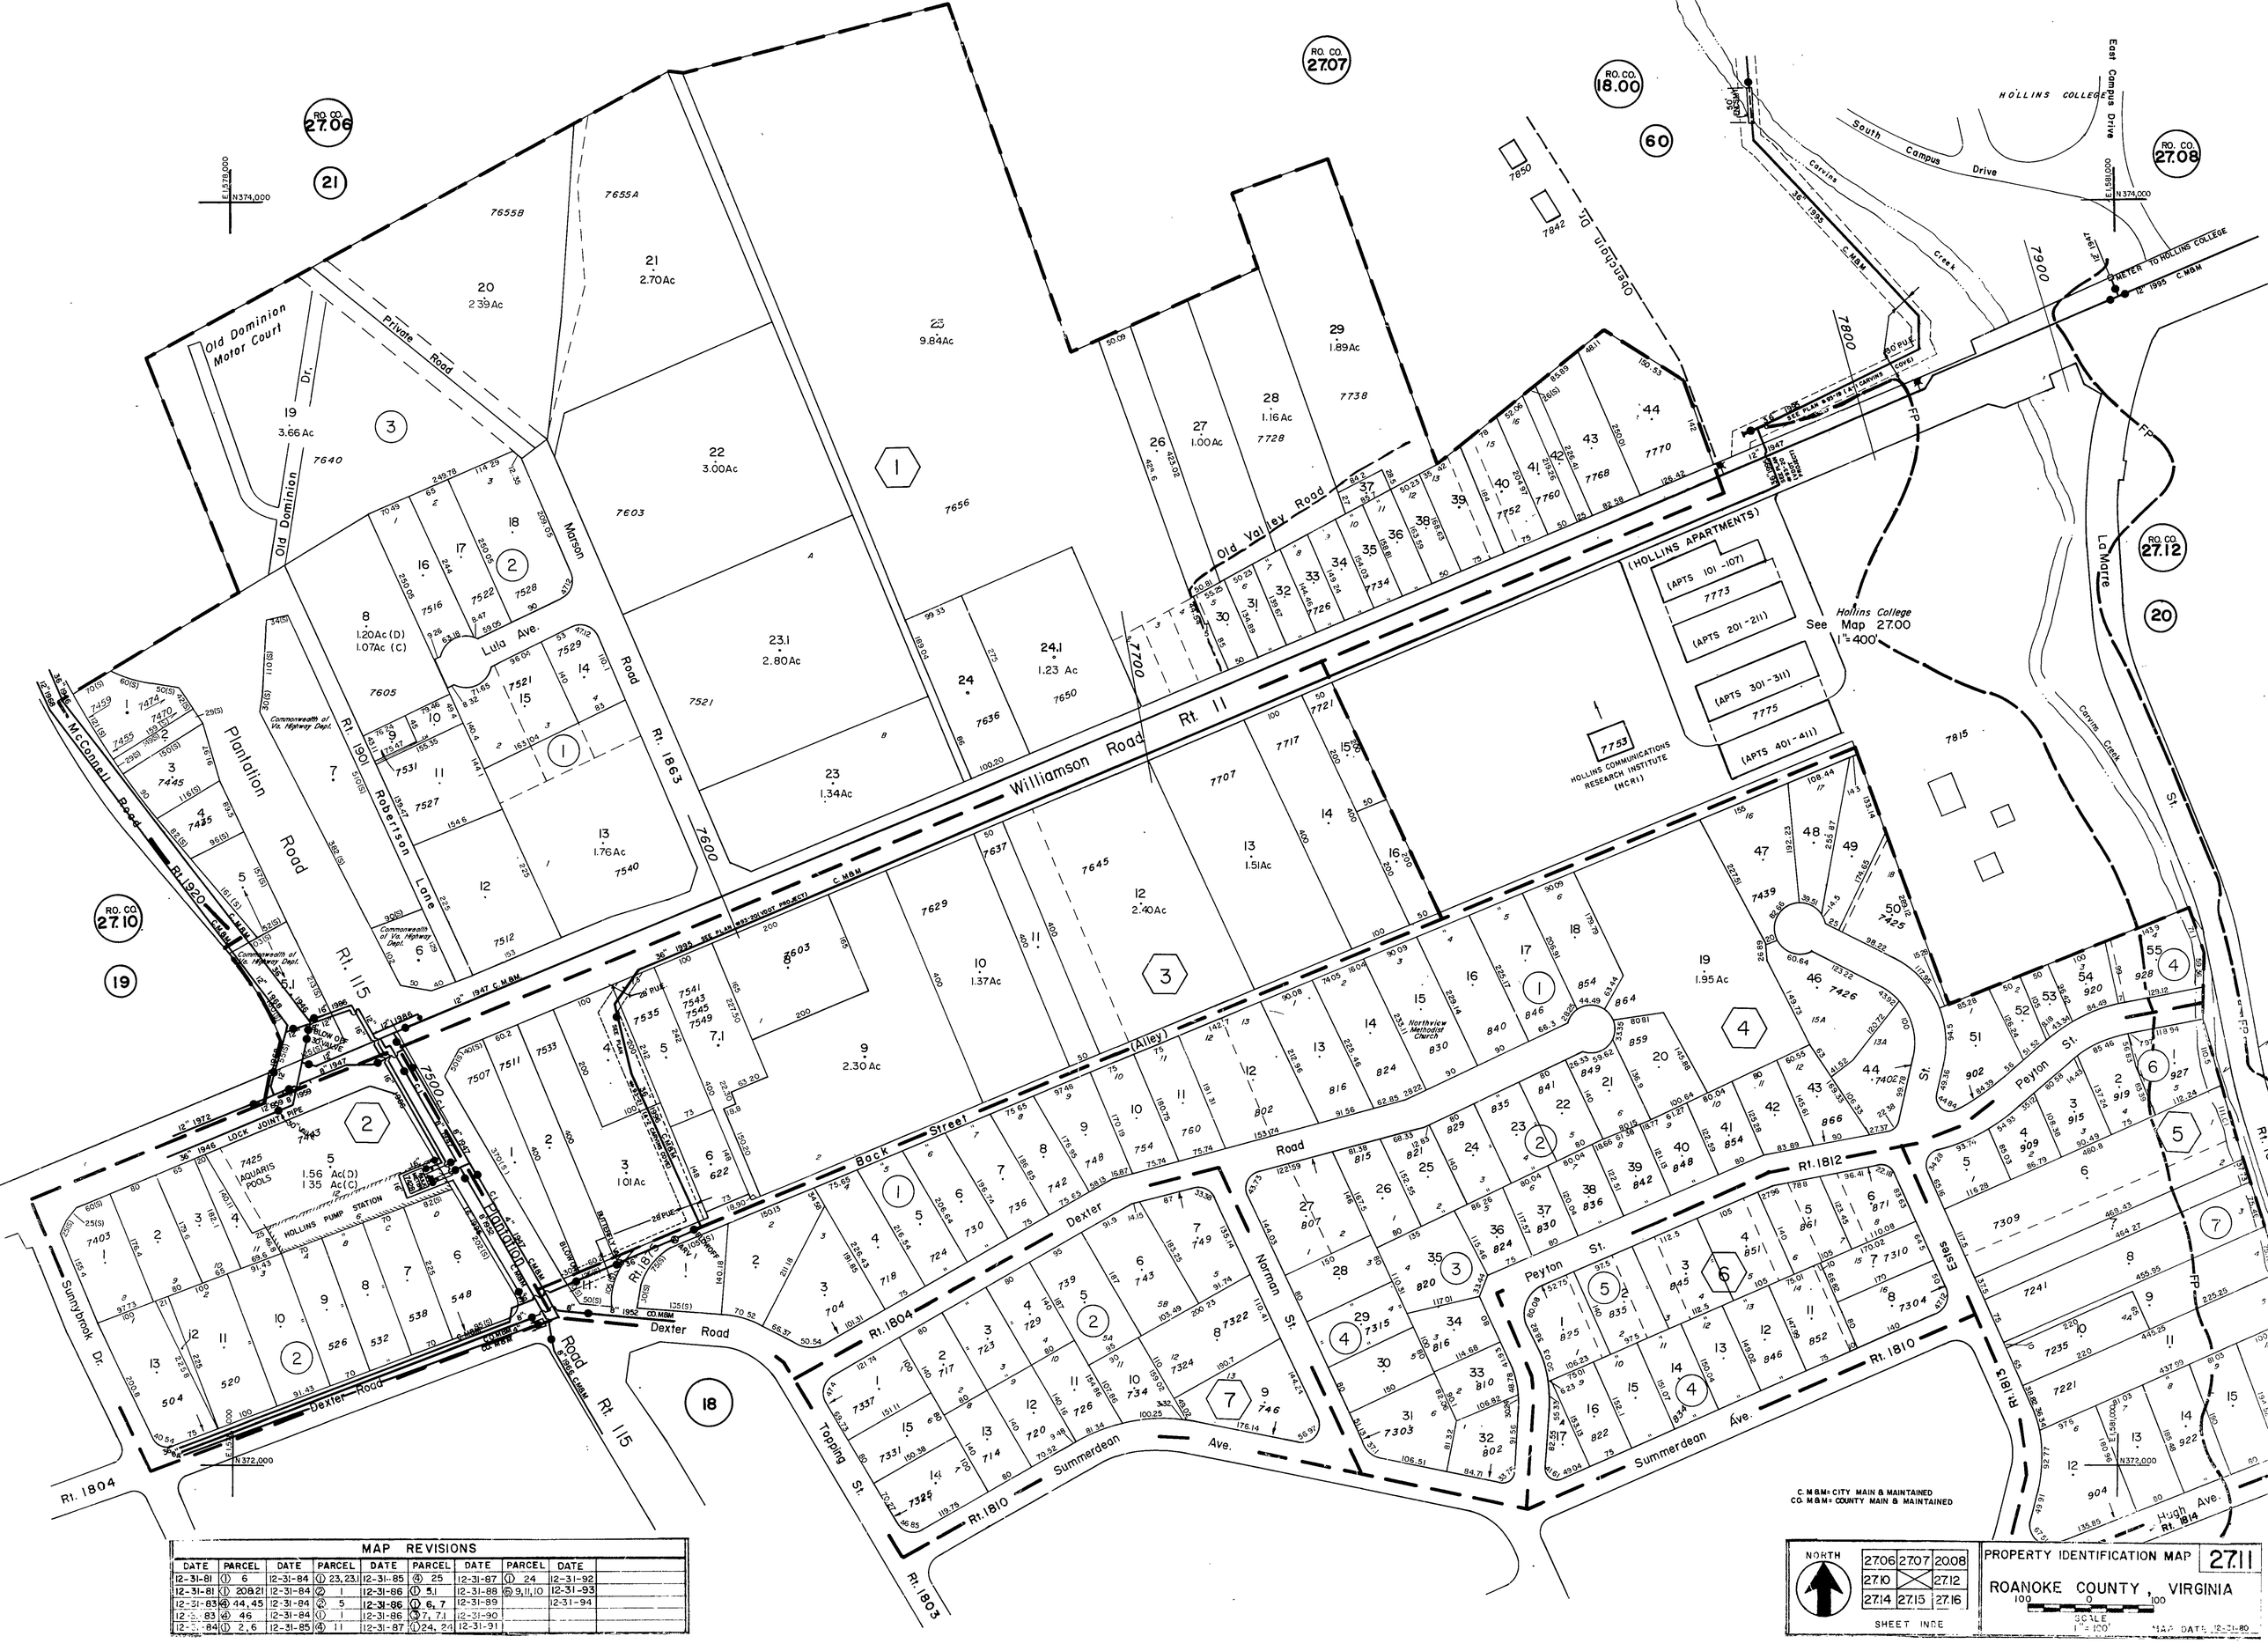

MAP REVISIONS									
DATE	PARCEL	DATE	PARCEL	DATE	PARCEL	DATE	PARCEL	DATE	
12-31-81	(1) 6	12-31-84	(1) 23, 23.1	12-31-85	(4) 25	12-31-87	(1) 24	12-31-92	
12-31-81	(1) 20&21	12-31-84	(2) 1	12-31-86	(1) 5.1	12-31-88	(5) 9, 11, 10	12-31-93	
12-31-83	(4) 44, 45	12-31-84	(2) 5	12-31-86	(1) 6, 7	12-31-89		12-31-94	
12-31-83	(4) 46	12-31-84	(1) 1	12-31-86	(3) 7, 7.1	12-31-90			
12-31-84	(1) 2, 6	12-31-85	(4) 11	12-31-87	(1) 24, 24	12-31-91			

NORTH			
	27.06	27.07	2008
	27.10		27.12
	27.14	27.15	27.16

SHEET INDE

PROPERTY IDENTIFICATION MAP 27.11

ROANOKE COUNTY, VIRGINIA

100 0 100

SCALE 1" = 100'

MAP DATE 12-31-80