NOTES:

1. EROSION CONTROL MEASURES (SILT FENCE ETC.) SHALL BE INSTALLED ON THE DOWN SLOPE OF THE EXCAVATED TRENCH. ADDITIONAL EROSION CONTROL MEASURES MAY BE REQUIRED BY ROANOKE COUNTY.
2. ROANOKE COUNTY UTILITY DEPARTMENT WILL MAKE ALL MODIFICATIONS / REPAIRS TO SANITARY SEWER LINES. ROANOKE COUNTY ENGINEERING AND INSPECTIONS DEPARTMENT SHALL BE NOTIFIED AND A ROANOKE COUNTY INSPECTOR SHALL BE PRESENT PRIOR TO ANY DISTURBANCE WITHIN A SANITARY SEWER EASEMENT.

THIS SHEET

1000 LF	36" WATERMAIN
2 EA.	8" BLOWOFF
1 EA.	1" A.R.V.

PLAN VIEW LINE 200

AS BUILT

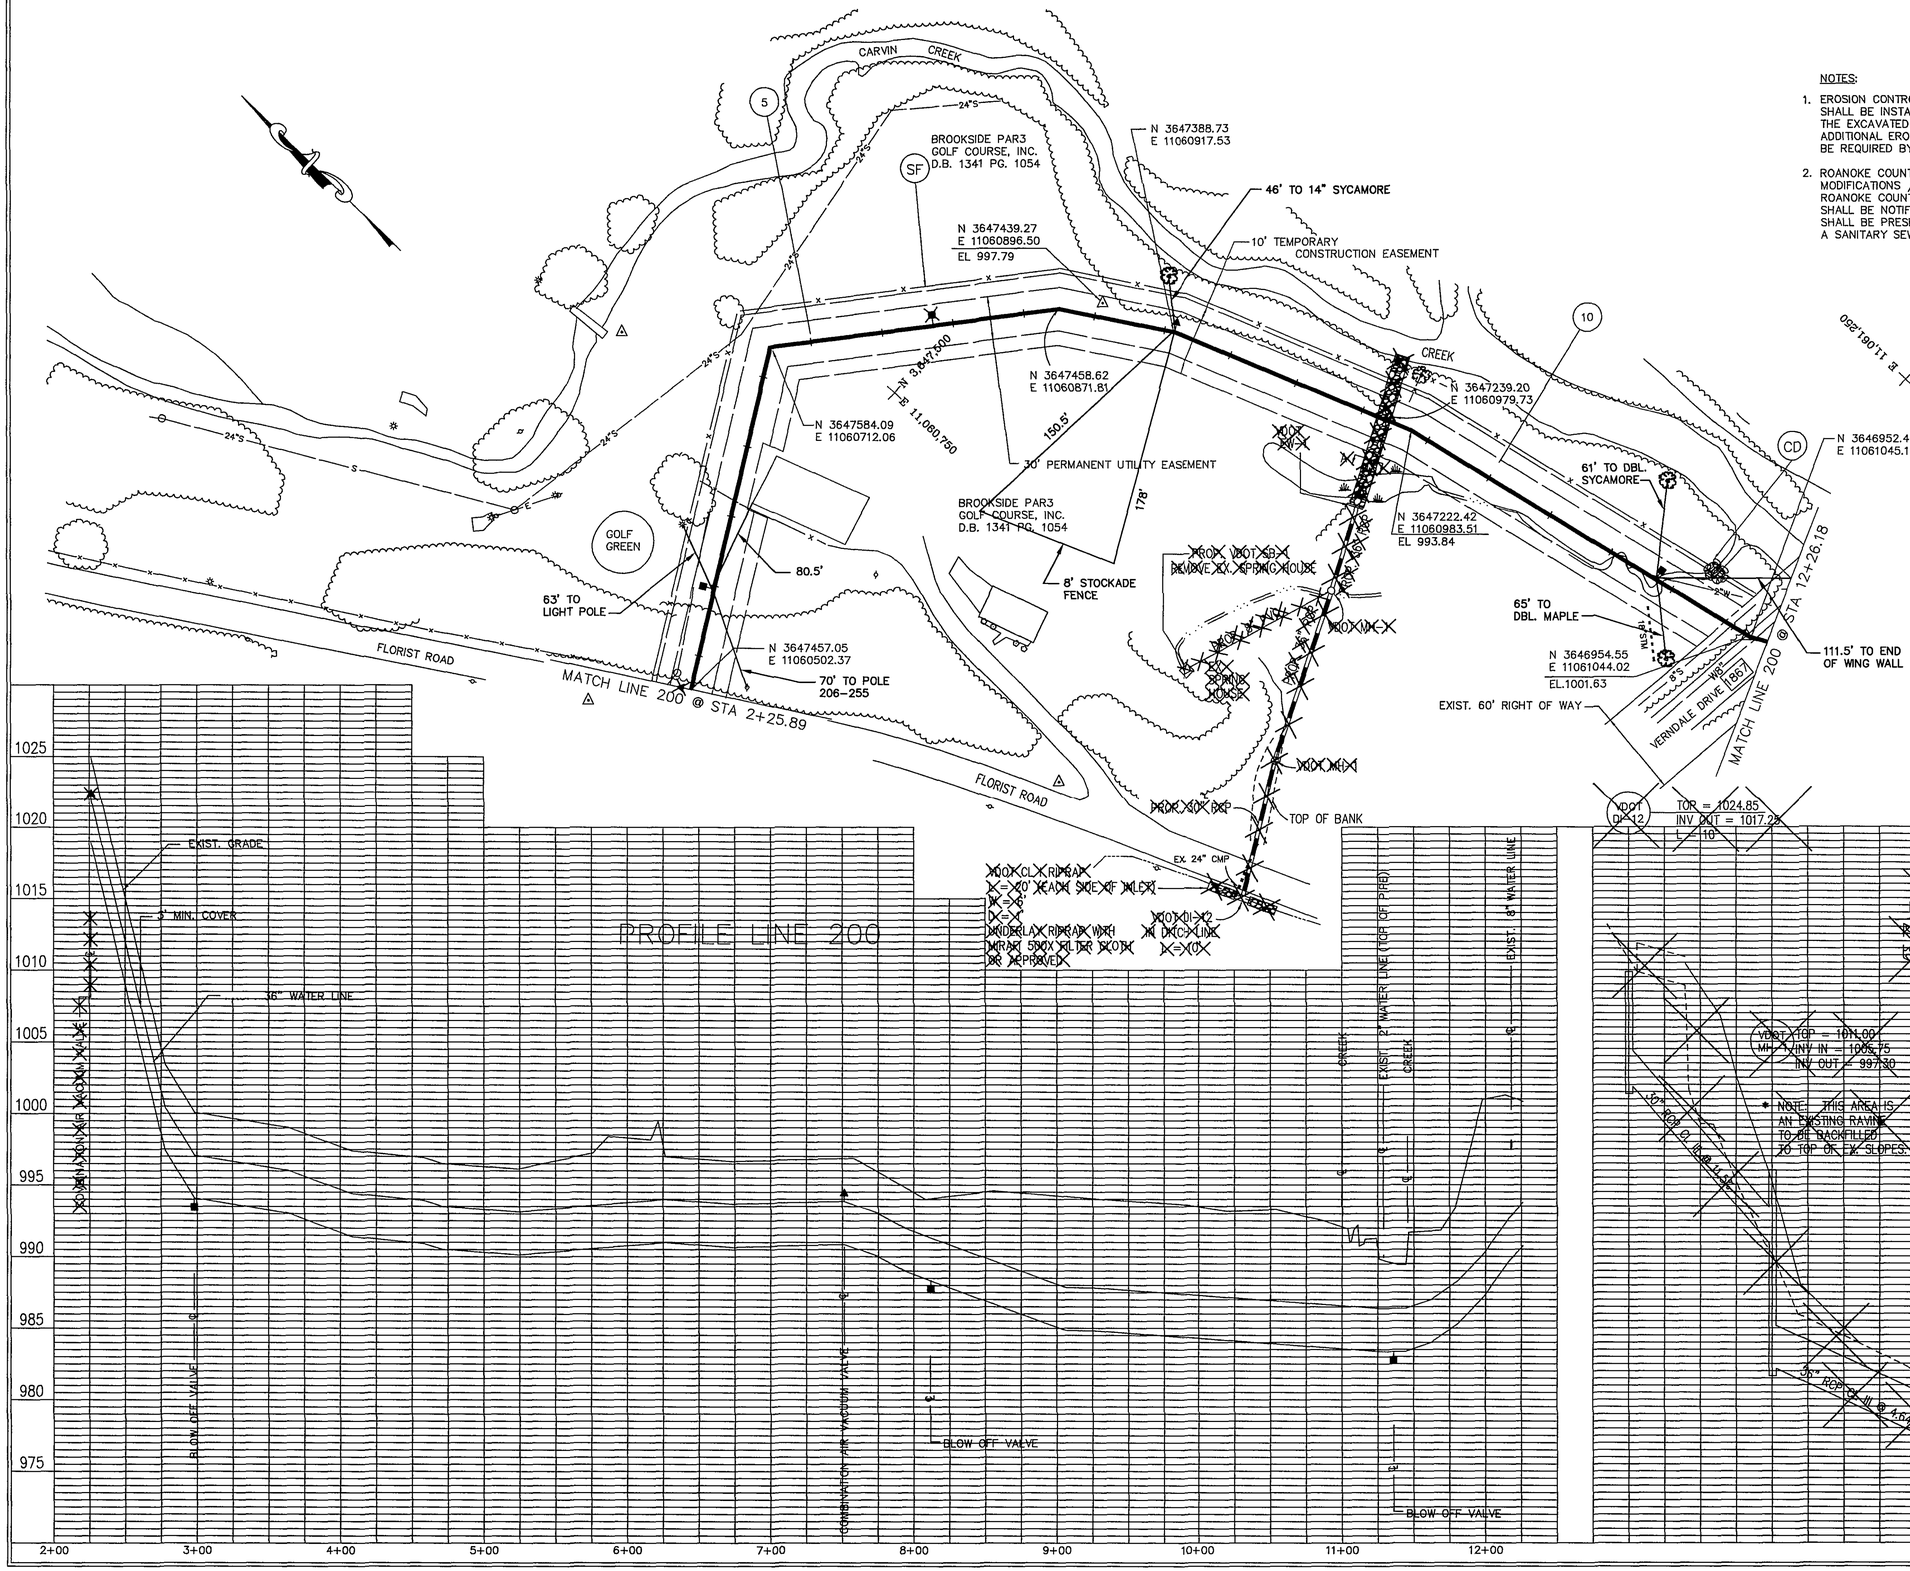

COMMONWEALTH OF VIRGINIA
STEVE E. HIVELY
NO. 9580
PROFESSIONAL ENGINEER

ENGINEER'S SEAL | ENGINEER'S SEAL

Dewberry & Davis
Architects Engineers Planners Surveyors
5238 Valleypointe Parkway, Suite One-B
Roanoke, Virginia 24019
☎ 703 362-7725

Carvins Cove, Phase II
City of Roanoke
Roanoke, Virginia

CONTRACT "B1"
LINE 200
STA 2+25.89 - 12+26.18

Drawn By	REH/ACF
Designed By	RBS
Checked By	SEH
Date	OCT 93 REV.
Scale	V: 1" = 5' H: 1" = 50'
Plan Number	E1 COUNTY
Zoned	NONE
Sheet	2 of 25
File Number	C1160