


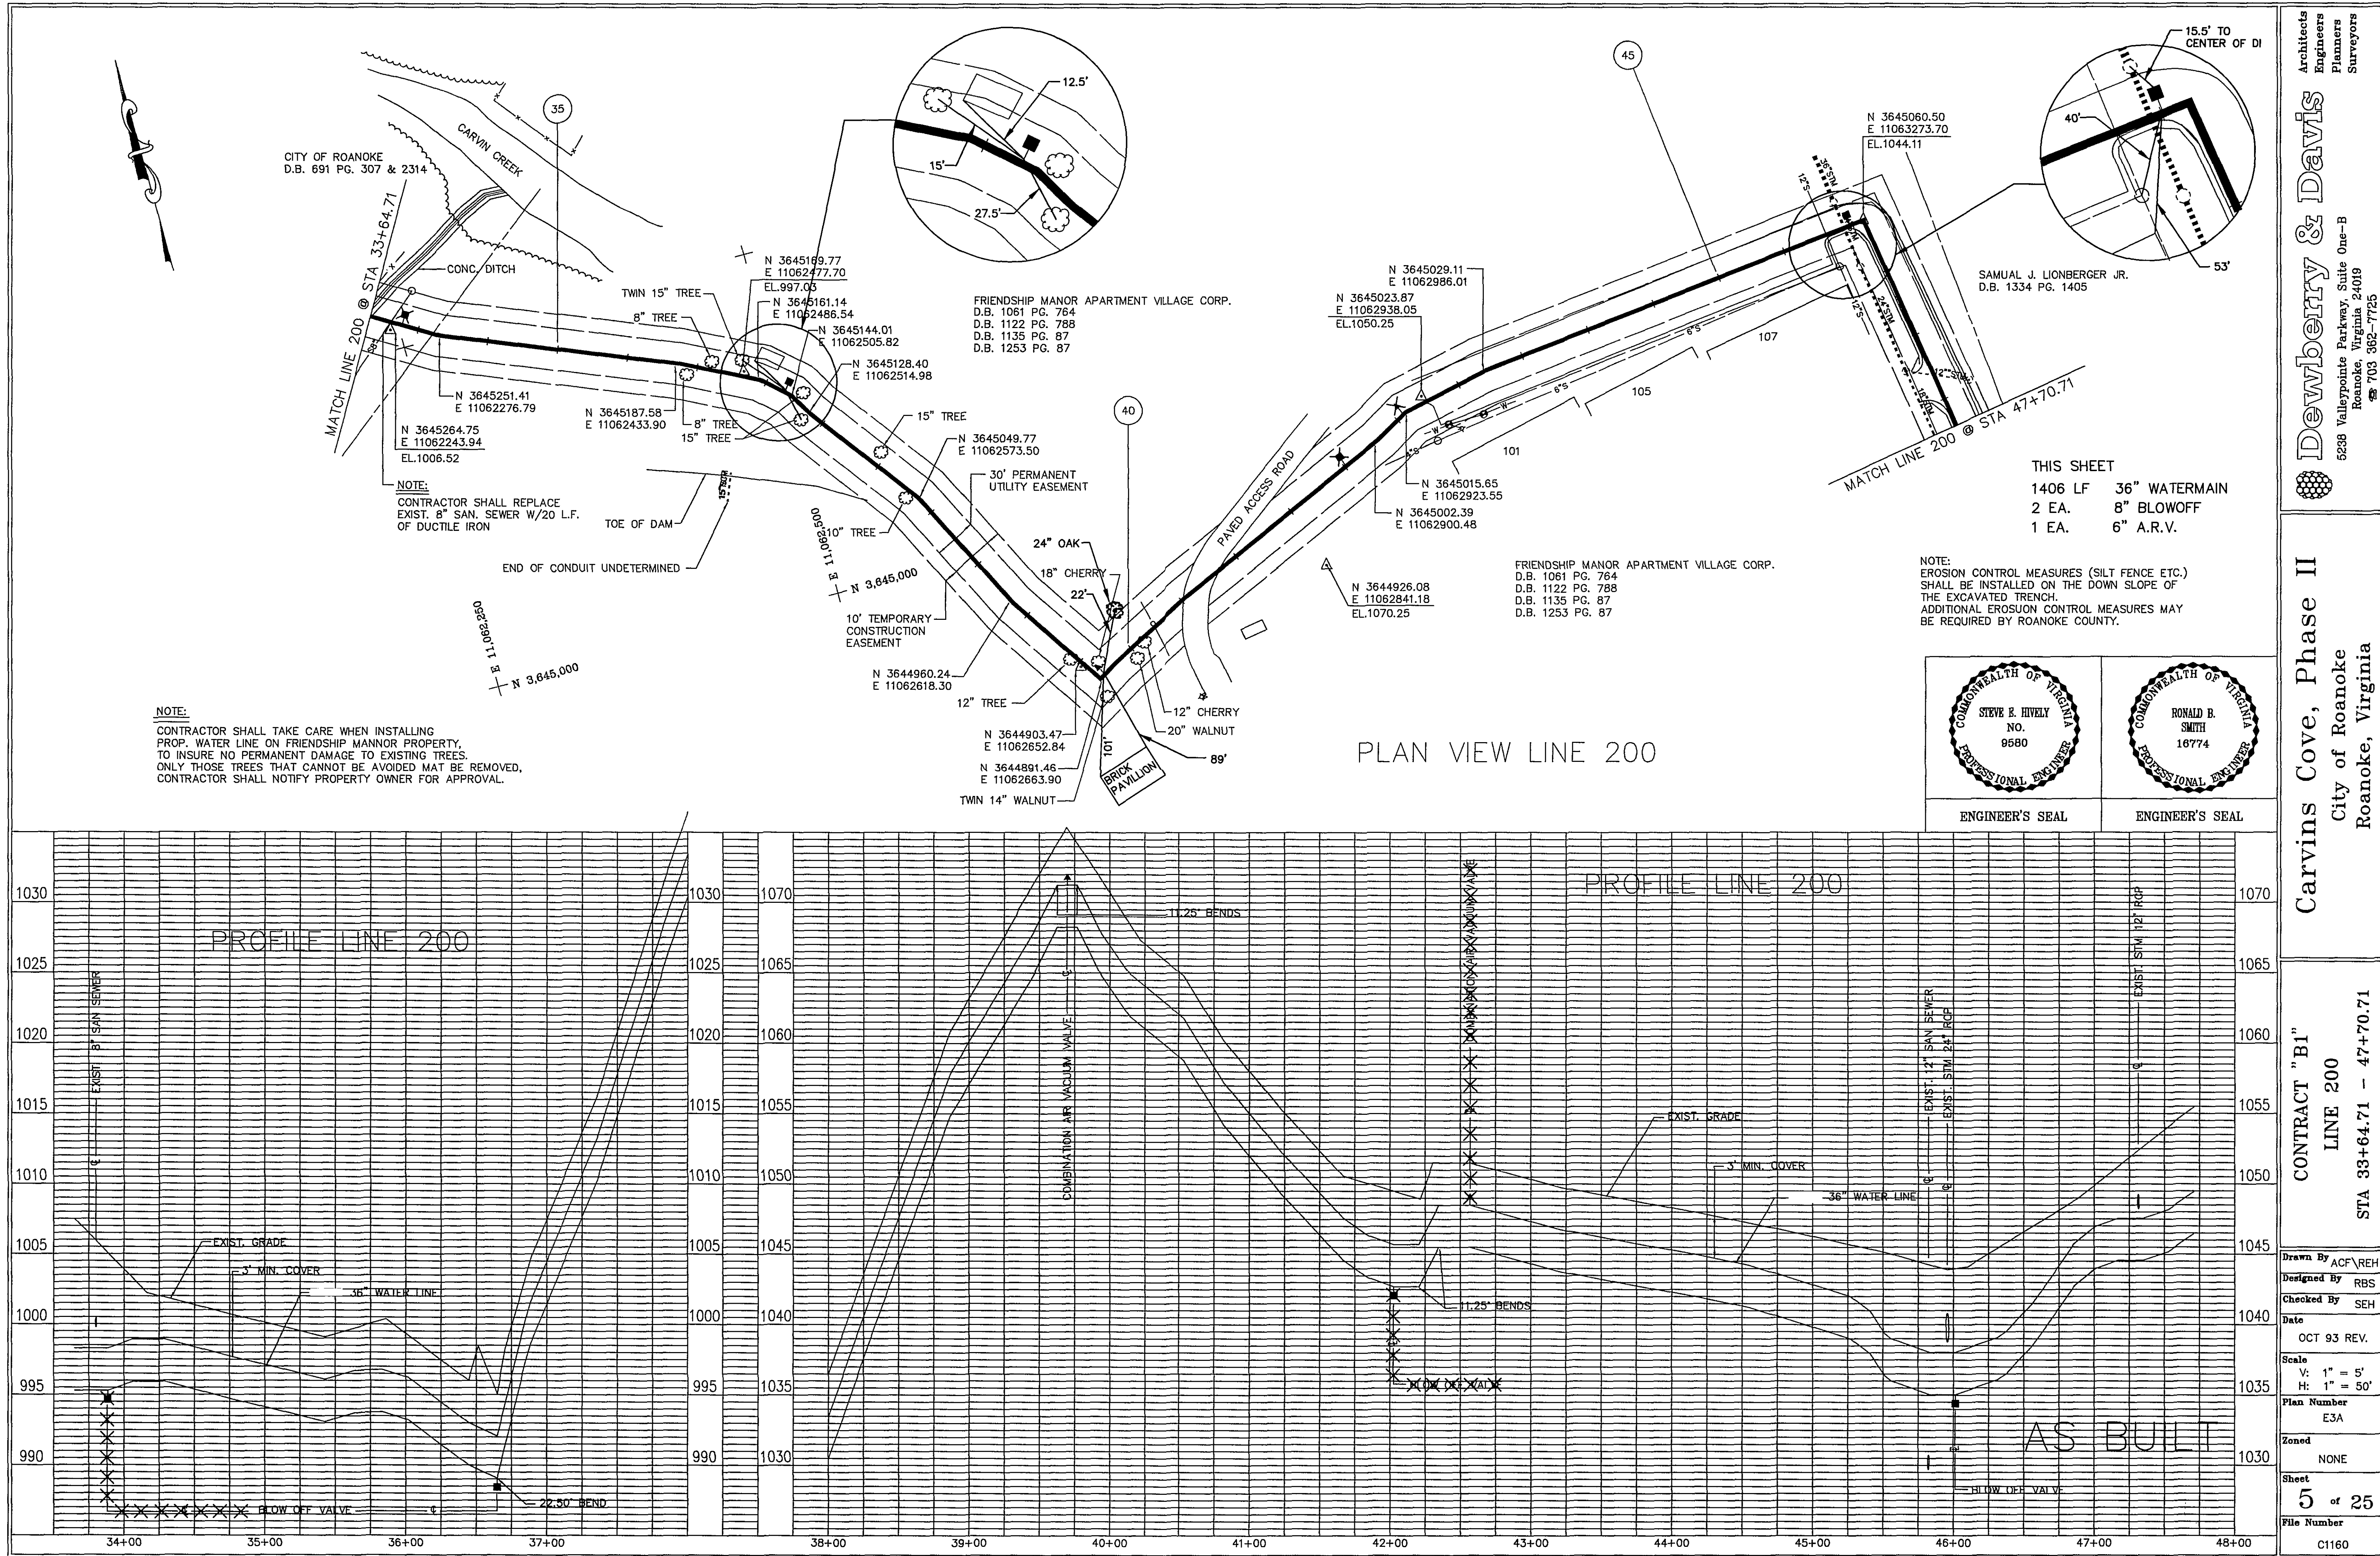

NOTE:
CONTRACTOR SHALL TAKE CARE WHEN INSTALLING
PROP. WATER LINE ON FRIENDSHIP MANOR PROPERTY.
TO INSURE NO PERMANENT DAMAGE TO EXISTING TREES.
ONLY THOSE TREES THAT CANNOT BE AVOIDED MAY BE REMOVED.
CONTRACTOR SHALL NOTIFY PROPERTY OWNER FOR APPROVAL.



NOTE:
CONTRACTOR SHALL REPLACE
EXIST. 8" SAN. SEWER W/20 L.F.
OF DUCTILE IRON

FRIENDSHIP MANOR APARTMENT VILLAGE CORP.
D.B. 1061 PG. 764
D.B. 1122 PG. 788
D.B. 1135 PG. 87
D.B. 1253 PG. 87

FRIENDSHIP MANOR APARTMENT VILLAGE CORP.
D.B. 1061 PG. 764
D.B. 1122 PG. 788
D.B. 1135 PG. 87
D.B. 1253 PG. 87

THIS SHEET
1406 LF 36" WATERMAIN
2 EA. 8" BLOWOFF
1 EA. 6" A.R.V.

NOTE:
EROSION CONTROL MEASURES (SILT FENCE ETC.)
SHALL BE INSTALLED ON THE DOWN SLOPE OF
THE EXCAVATED TRENCH.
ADDITIONAL EROSION CONTROL MEASURES MAY
BE REQUIRED BY ROANOKE COUNTY.

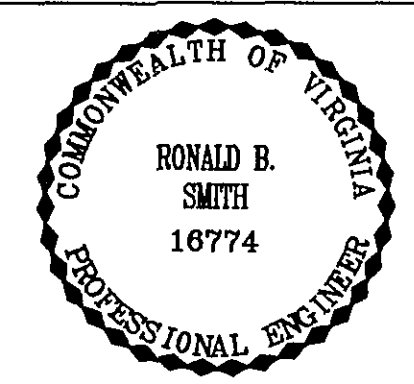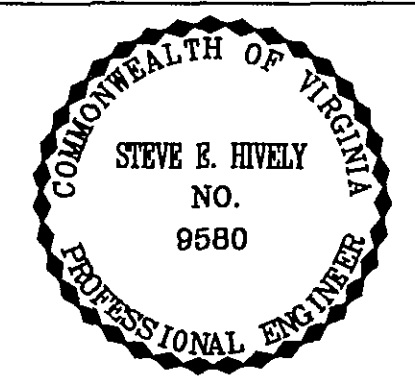

ENGINEER'S SEAL

ENGINEER'S SEAL

Dewberry & Davis
Architects
Engineers
Planners
Surveyors
5238 Valleypointe Parkway, Suite One-B
Roanoke, Virginia 24019
703 352-7725

Carvins Cove, Phase II
City of Roanoke
Roanoke, Virginia

CONTRACT "B1"
LINE 200
STA 33+64.71 - 47+70.71

Drawn By ACF/REH
Designed By RBS
Checked By SEH
Date OCT 93 REV.
Scale V: 1" = 5'
H: 1" = 50'
Plan Number E3A
Zoned NONE
Sheet 5 of 25
File Number C1160