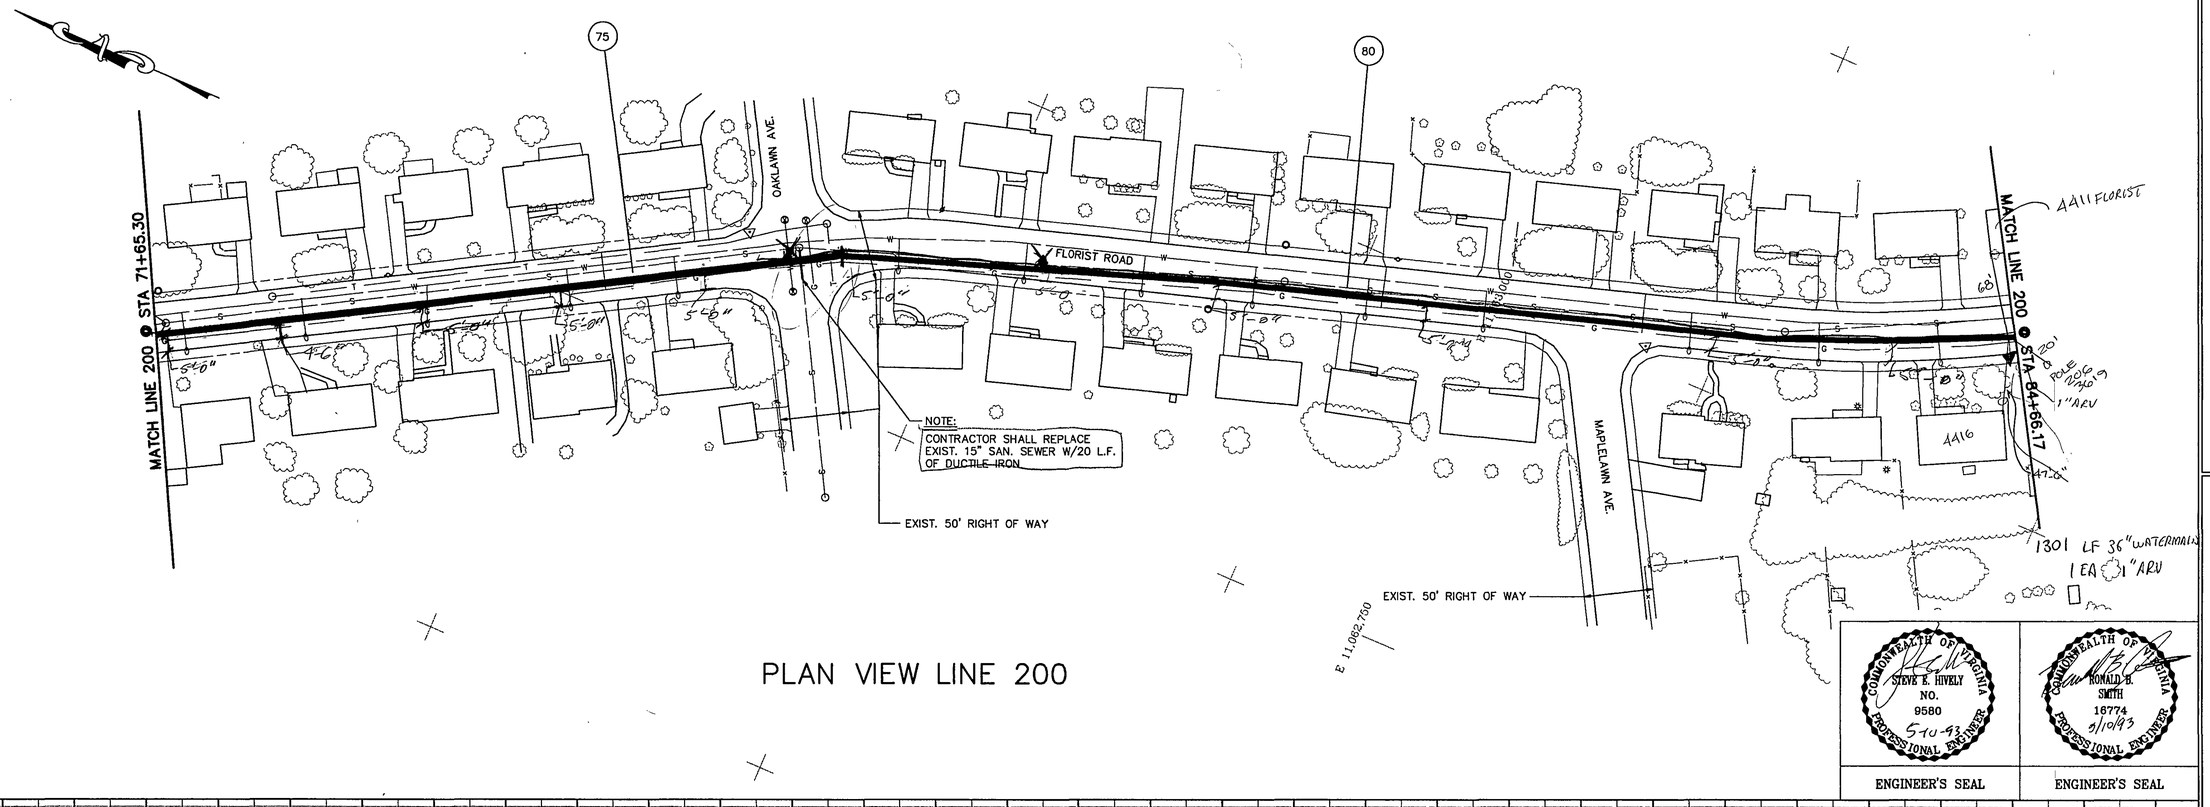

PLAN VIEW LINE 200

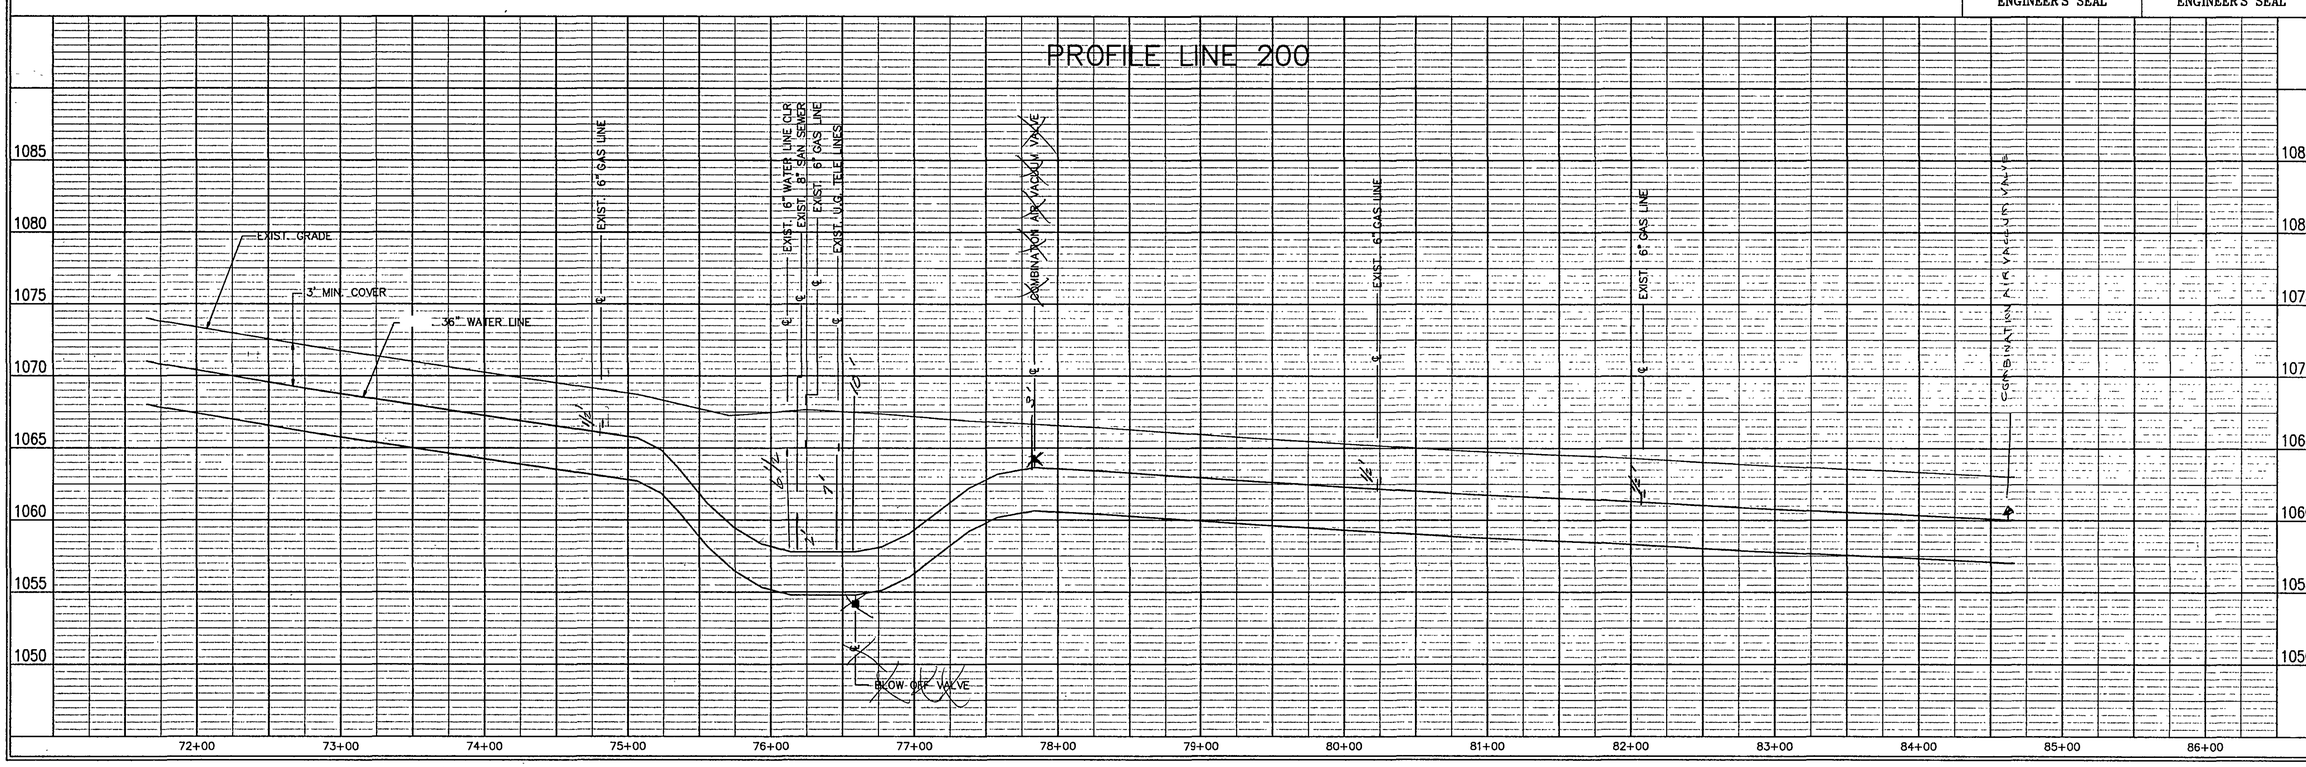

COMMONWEALTH OF VIRGINIA
STEVE E. HIVELY
NO. 9580
5-10-93
PROFESSIONAL ENGINEER

ENGINEER'S SEAL

COMMONWEALTH OF VIRGINIA
RONALD B. SMITH
16774
5/10/93
PROFESSIONAL ENGINEER

ENGINEER'S SEAL

Dewberry & Davis
Architects
Engineers
Planners
Surveyors
5238 Valleypointe Parkway, Suite One-B
Roanoke, Virginia 24019
☎ 703 362-7725

Carvins Cove, Phase II

City of Roanoke
Roanoke, Virginia

CONTRACT "B1"
LINE 200
STA 71+65.30 - 84+66.17

Drawn By	ACF/REH
Designed By	RBS
Checked By	SEH
Date	MAY 93
Scale	V: 1" = 5' H: 1" = 50'
Plan Number	E5
Zoned	NONE
Sheet	8 of 25
File Number	C1160