THIS SHEET

594 LF	24" WATERMAIN
1 EA.	6" BLOWOFF
1 EA.	4" A.R.V.

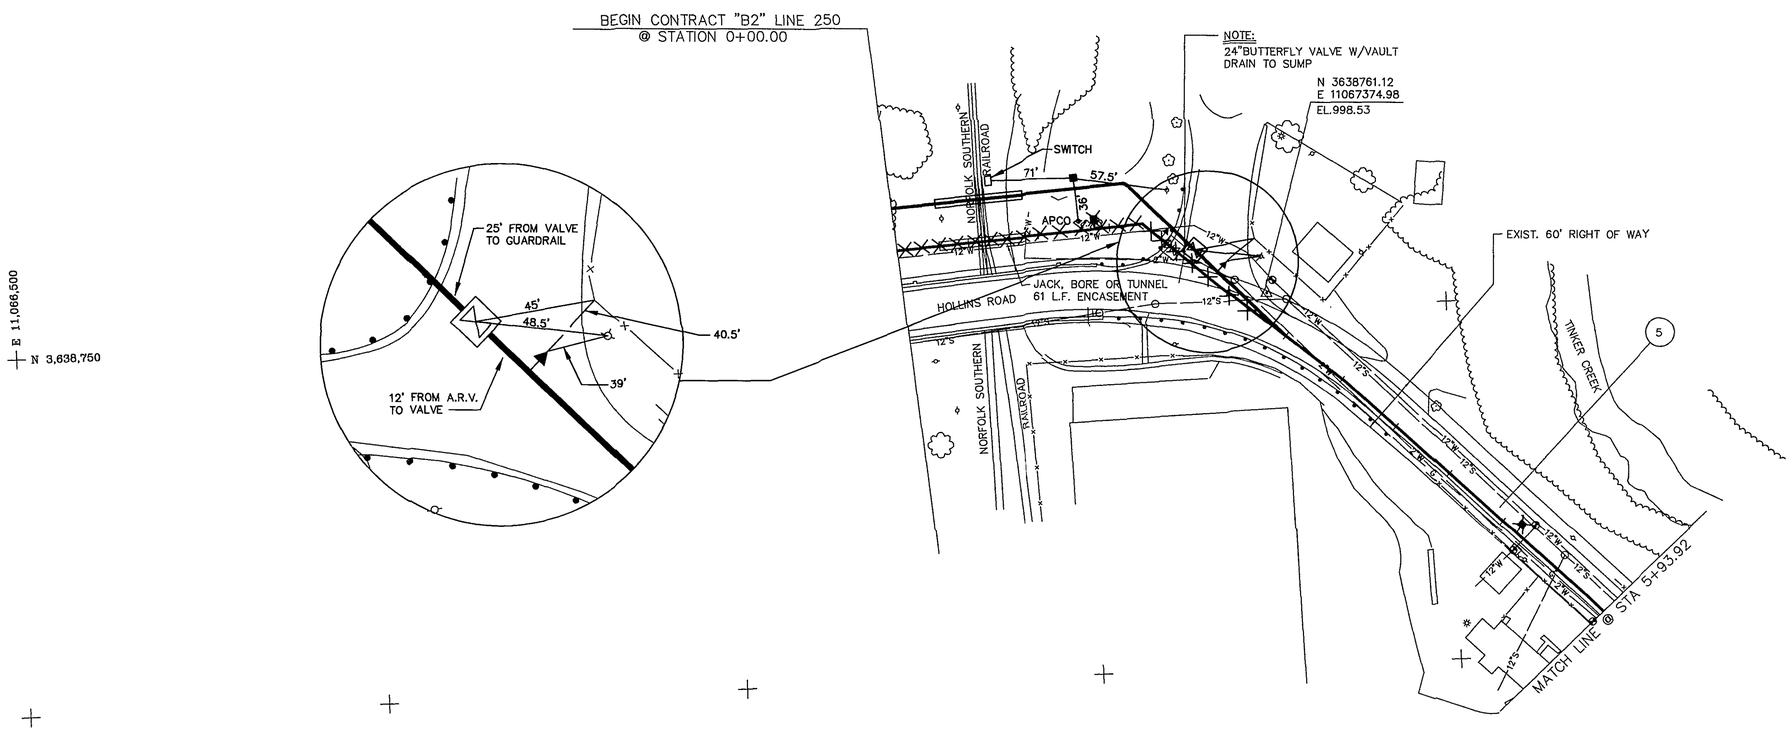

PLAN VIEW LINE 250

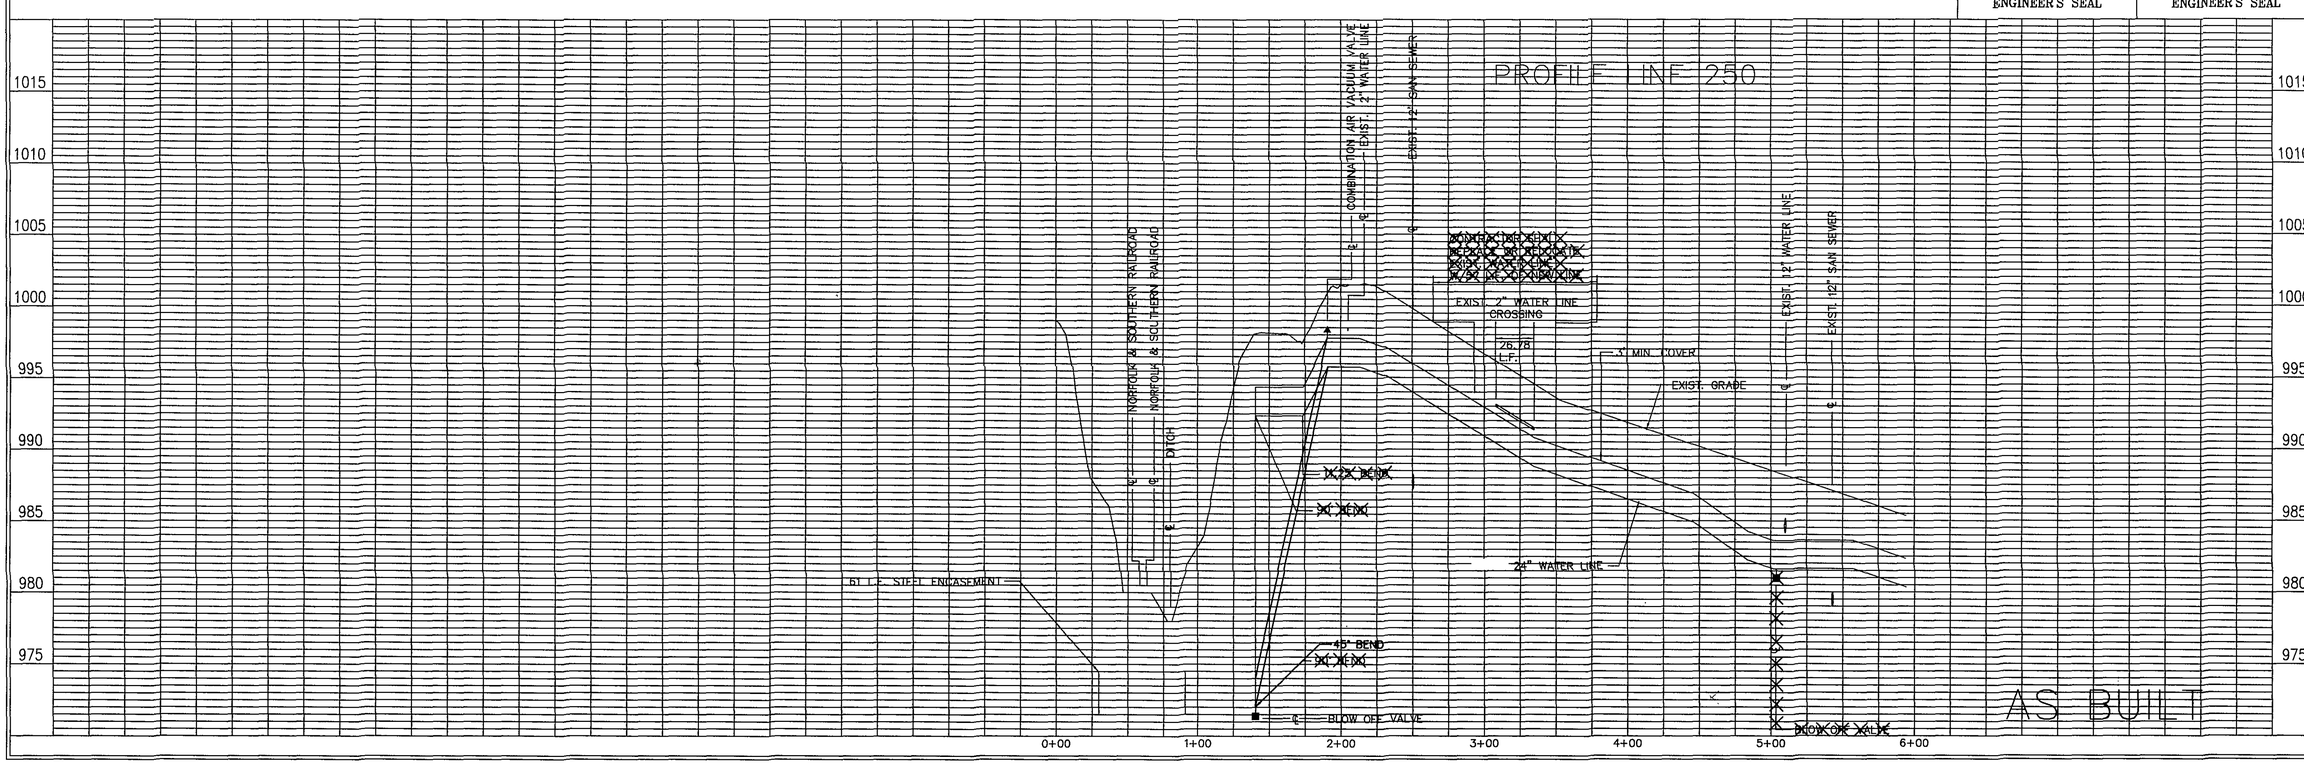

AS BUILT

COMMONWEALTH OF VIRGINIA
STEVE E. HIVELY
NO. 9580
PROFESSIONAL ENGINEER
ENGINEER'S SEAL

COMMONWEALTH OF VIRGINIA
RONALD B. SMITH
16774
PROFESSIONAL ENGINEER
ENGINEER'S SEAL

Dewberry & Davis
Architects
Engineers
Planners
Surveyors
5238 Valleypointe Parkway, Suite One-B
Roanoke, Virginia 24019
☎ 703 362-7725

Carvins Cove, Phase II

City of Roanoke
Roanoke, Virginia

BEGIN CONTRACT "B2"
BEGIN LINE 250
STA 0+00.00 - 5+93.92

Drawn By	REH/ACF
Designed By	RBS
Checked By	SEH
Date	APRIL 93
Scale	V: 1" = 5' H: 1" = 50'
Plan Number	A7B
Zoned	NONE
Sheet	1 of 22
File Number	C1160