

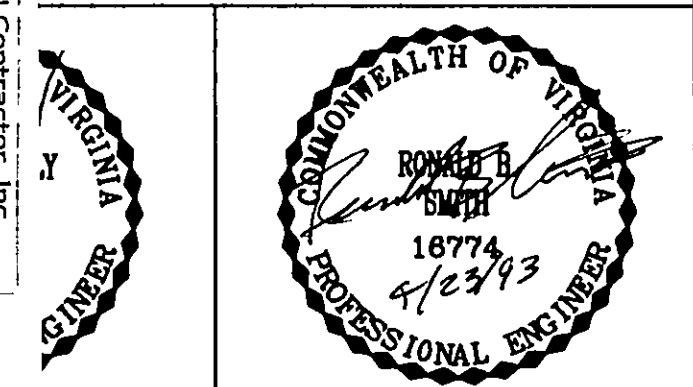


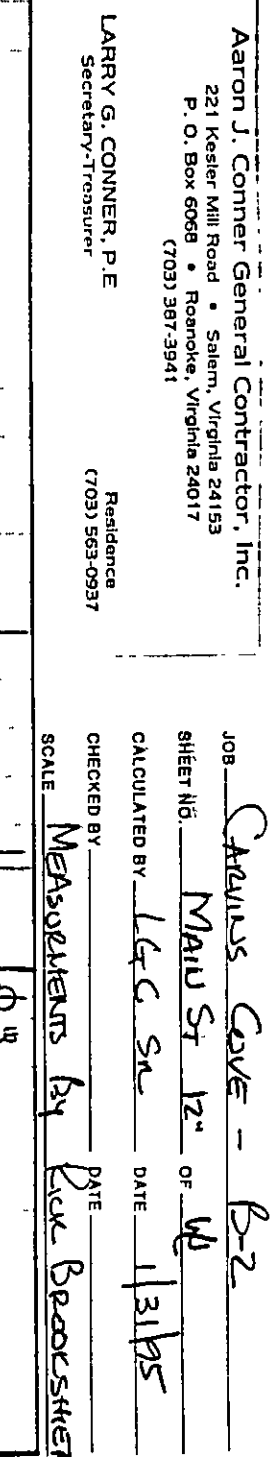

SEAL		ENGINEER'S SEAL		

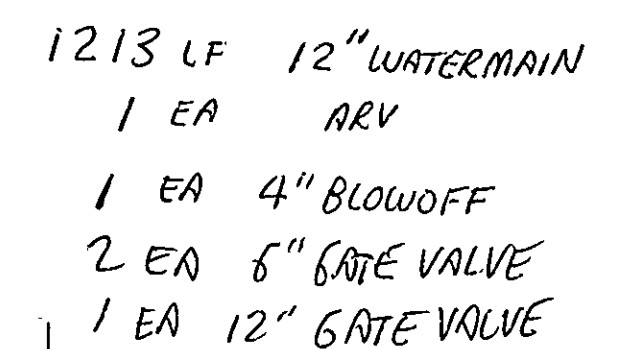