


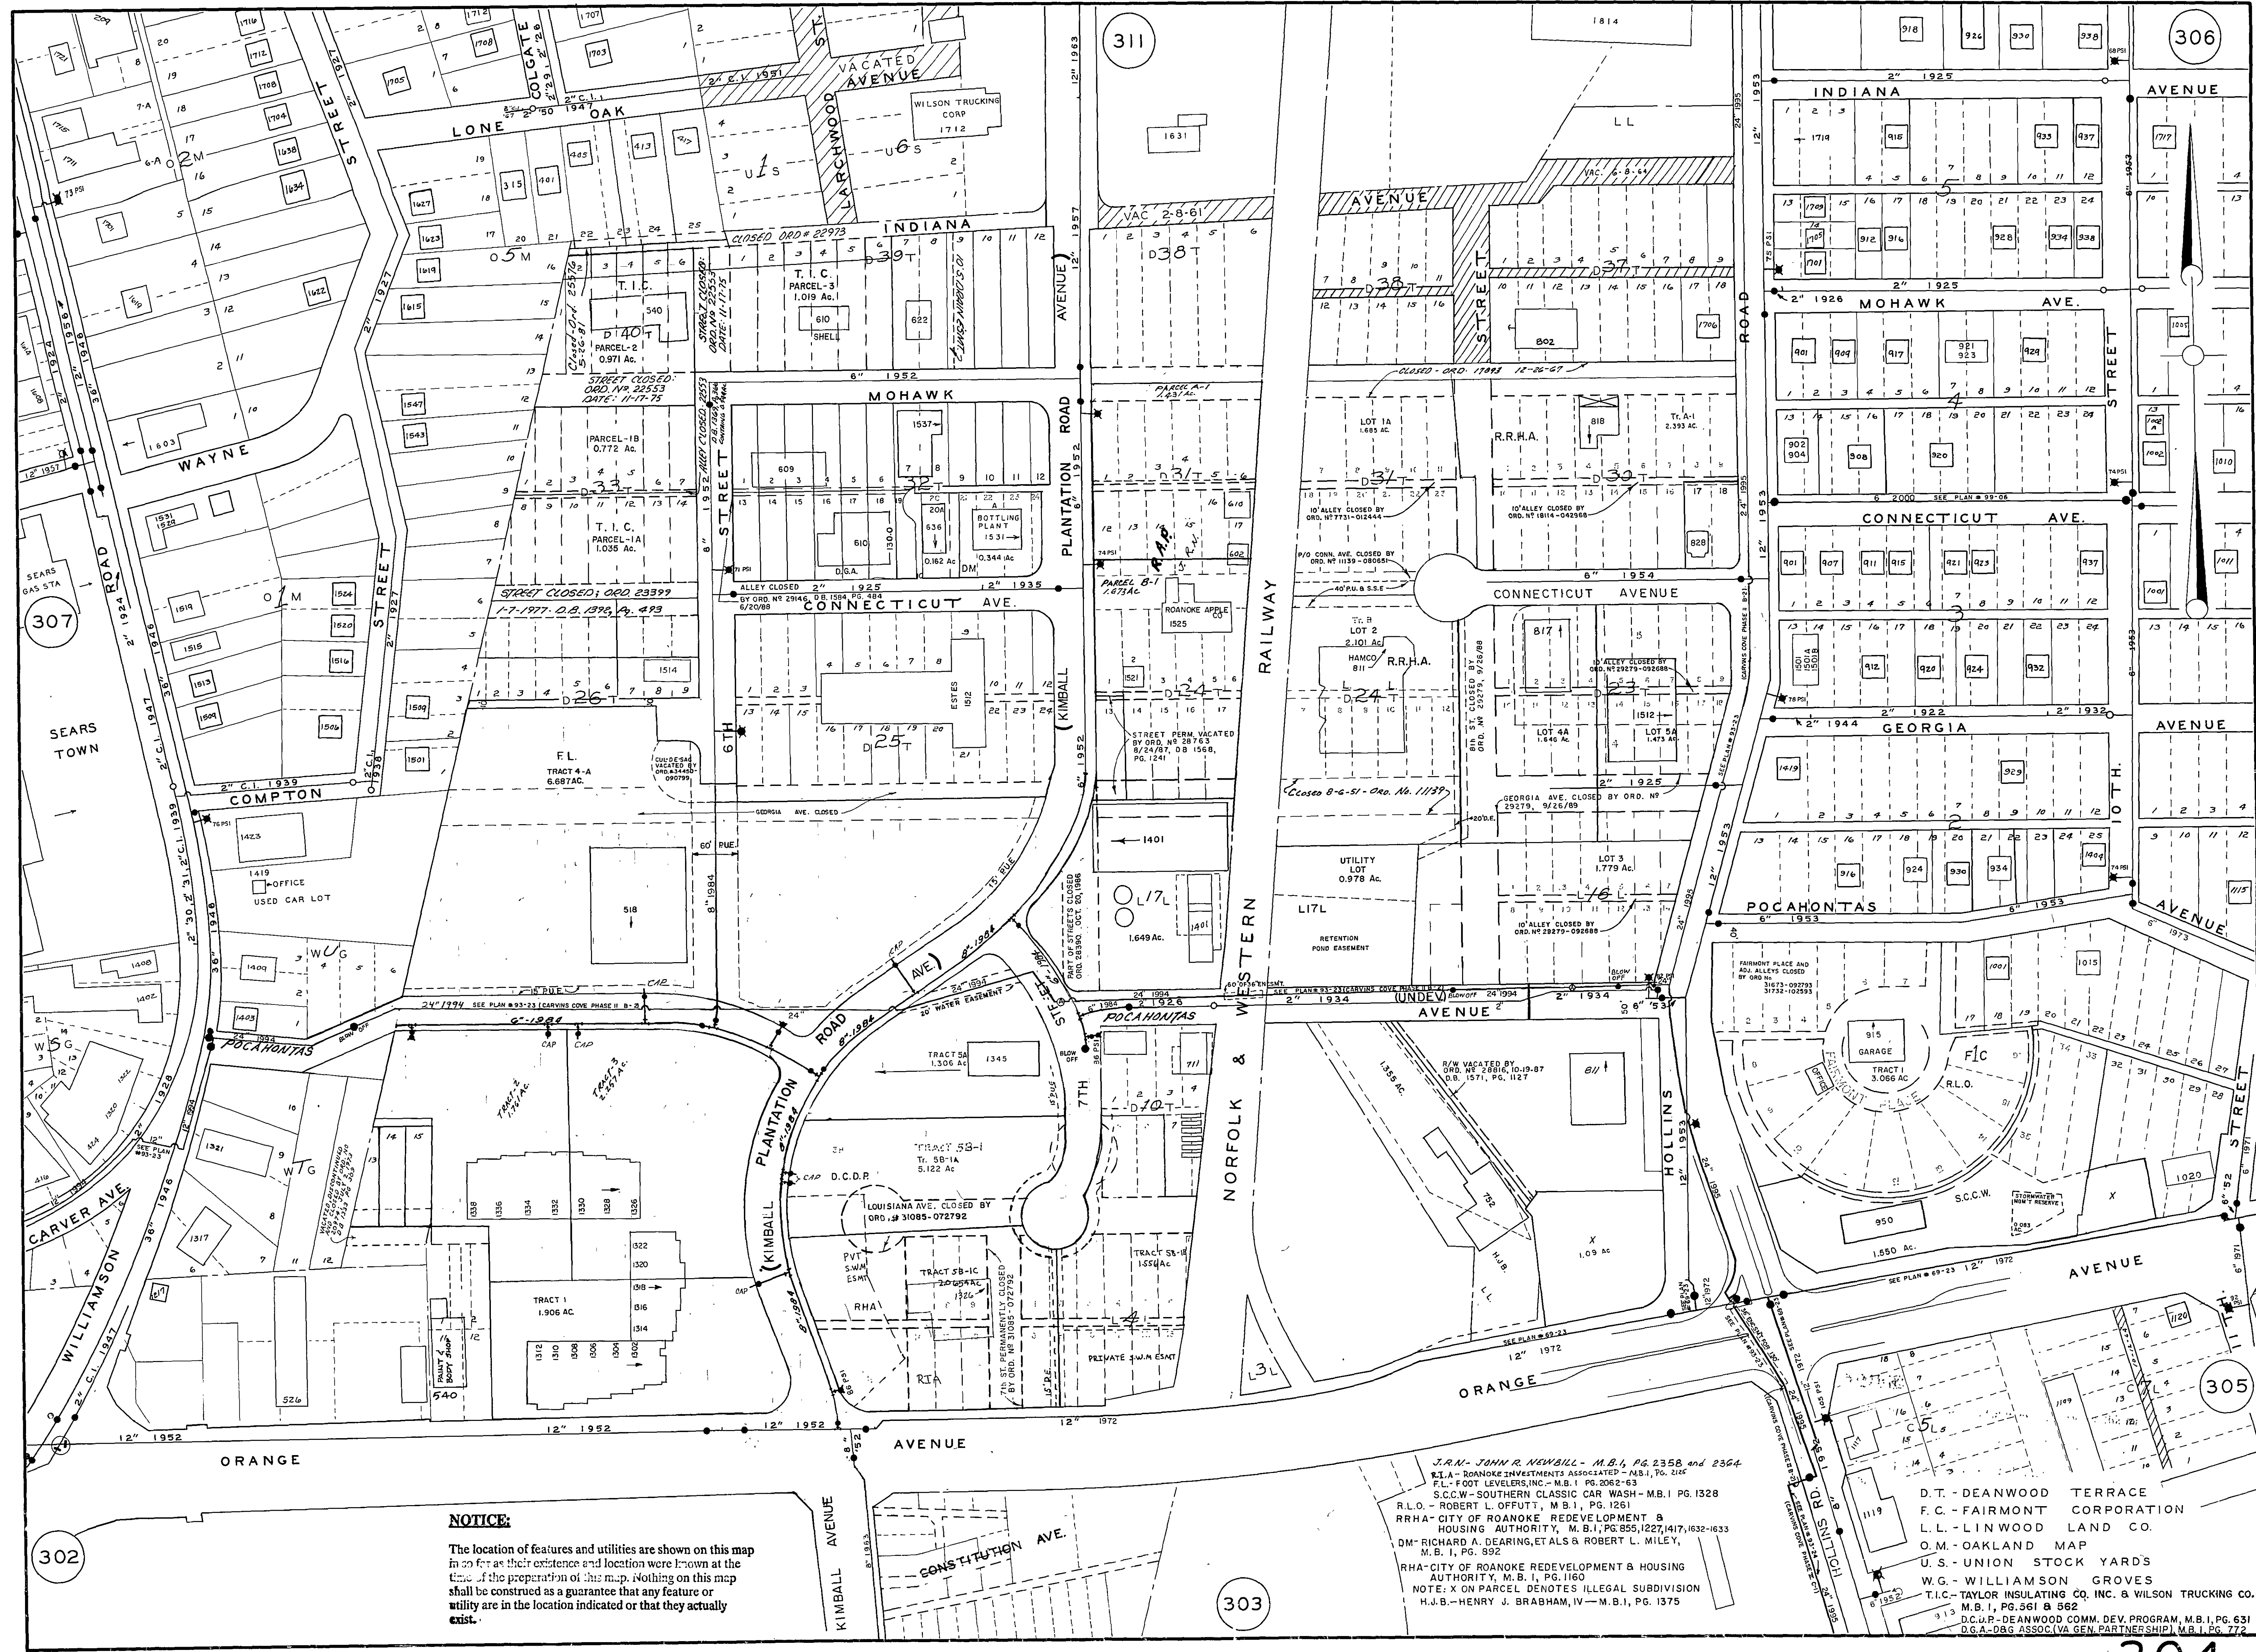

NOTICE:

The location of features and utilities are shown on this map in so far as their existence and location were known at the time of the preparation of this map. Nothing on this map shall be construed as a guarantee that any feature or utility are in the location indicated or that they actually exist.

J.R.N. - JOHN R. NEWBELL - M.B.I., PG. 2358 and 2364
R.I.A. - ROANOKE INVESTMENTS ASSOCIATED - M.B.I., PG. 2445
F.L. - FOOT LEVELERS, INC. - M.B.I., PG. 2062-63
S.C.C.W. - SOUTHERN CLASSIC CAR WASH - M.B.I., PG. 1328
R.L.O. - ROBERT L. OFFUTT, M.B.I., PG. 1261
RRHA - CITY OF ROANOKE REDEVELOPMENT & HOUSING AUTHORITY, M.B.I., PG. 855, 1227, 1417, 1632-1633
DM - RICHARD A. DEARING, ETALS & ROBERT L. MILEY, M.B.I., PG. 892
RHA - CITY OF ROANOKE REDEVELOPMENT & HOUSING AUTHORITY, M.B.I., PG. 1160
NOTE: X ON PARCEL DENOTES ILLEGAL SUBDIVISION
H.J.B. - HENRY J. BRABHAM, IV - M.B.I., PG. 1375

D.T. - DEANWOOD TERRACE
F.C. - FAIRMONT CORPORATION
L.L. - LINWOOD LAND CO.
O.M. - OAKLAND MAP
U.S. - UNION STOCK YARDS
W.G. - WILLIAMSON GROVES
T.I.C. - TAYLOR INSULATING CO., INC. & WILSON TRUCKING CO., M.B.I., PG. 561 & 562
D.C.U.P. - DEANWOOD COMM. DEV. PROGRAM, M.B.I., PG. 631
D.G.A. - D&G ASSOC. (A GEN. PARTNERSHIP), M.B.I., PG. 772