


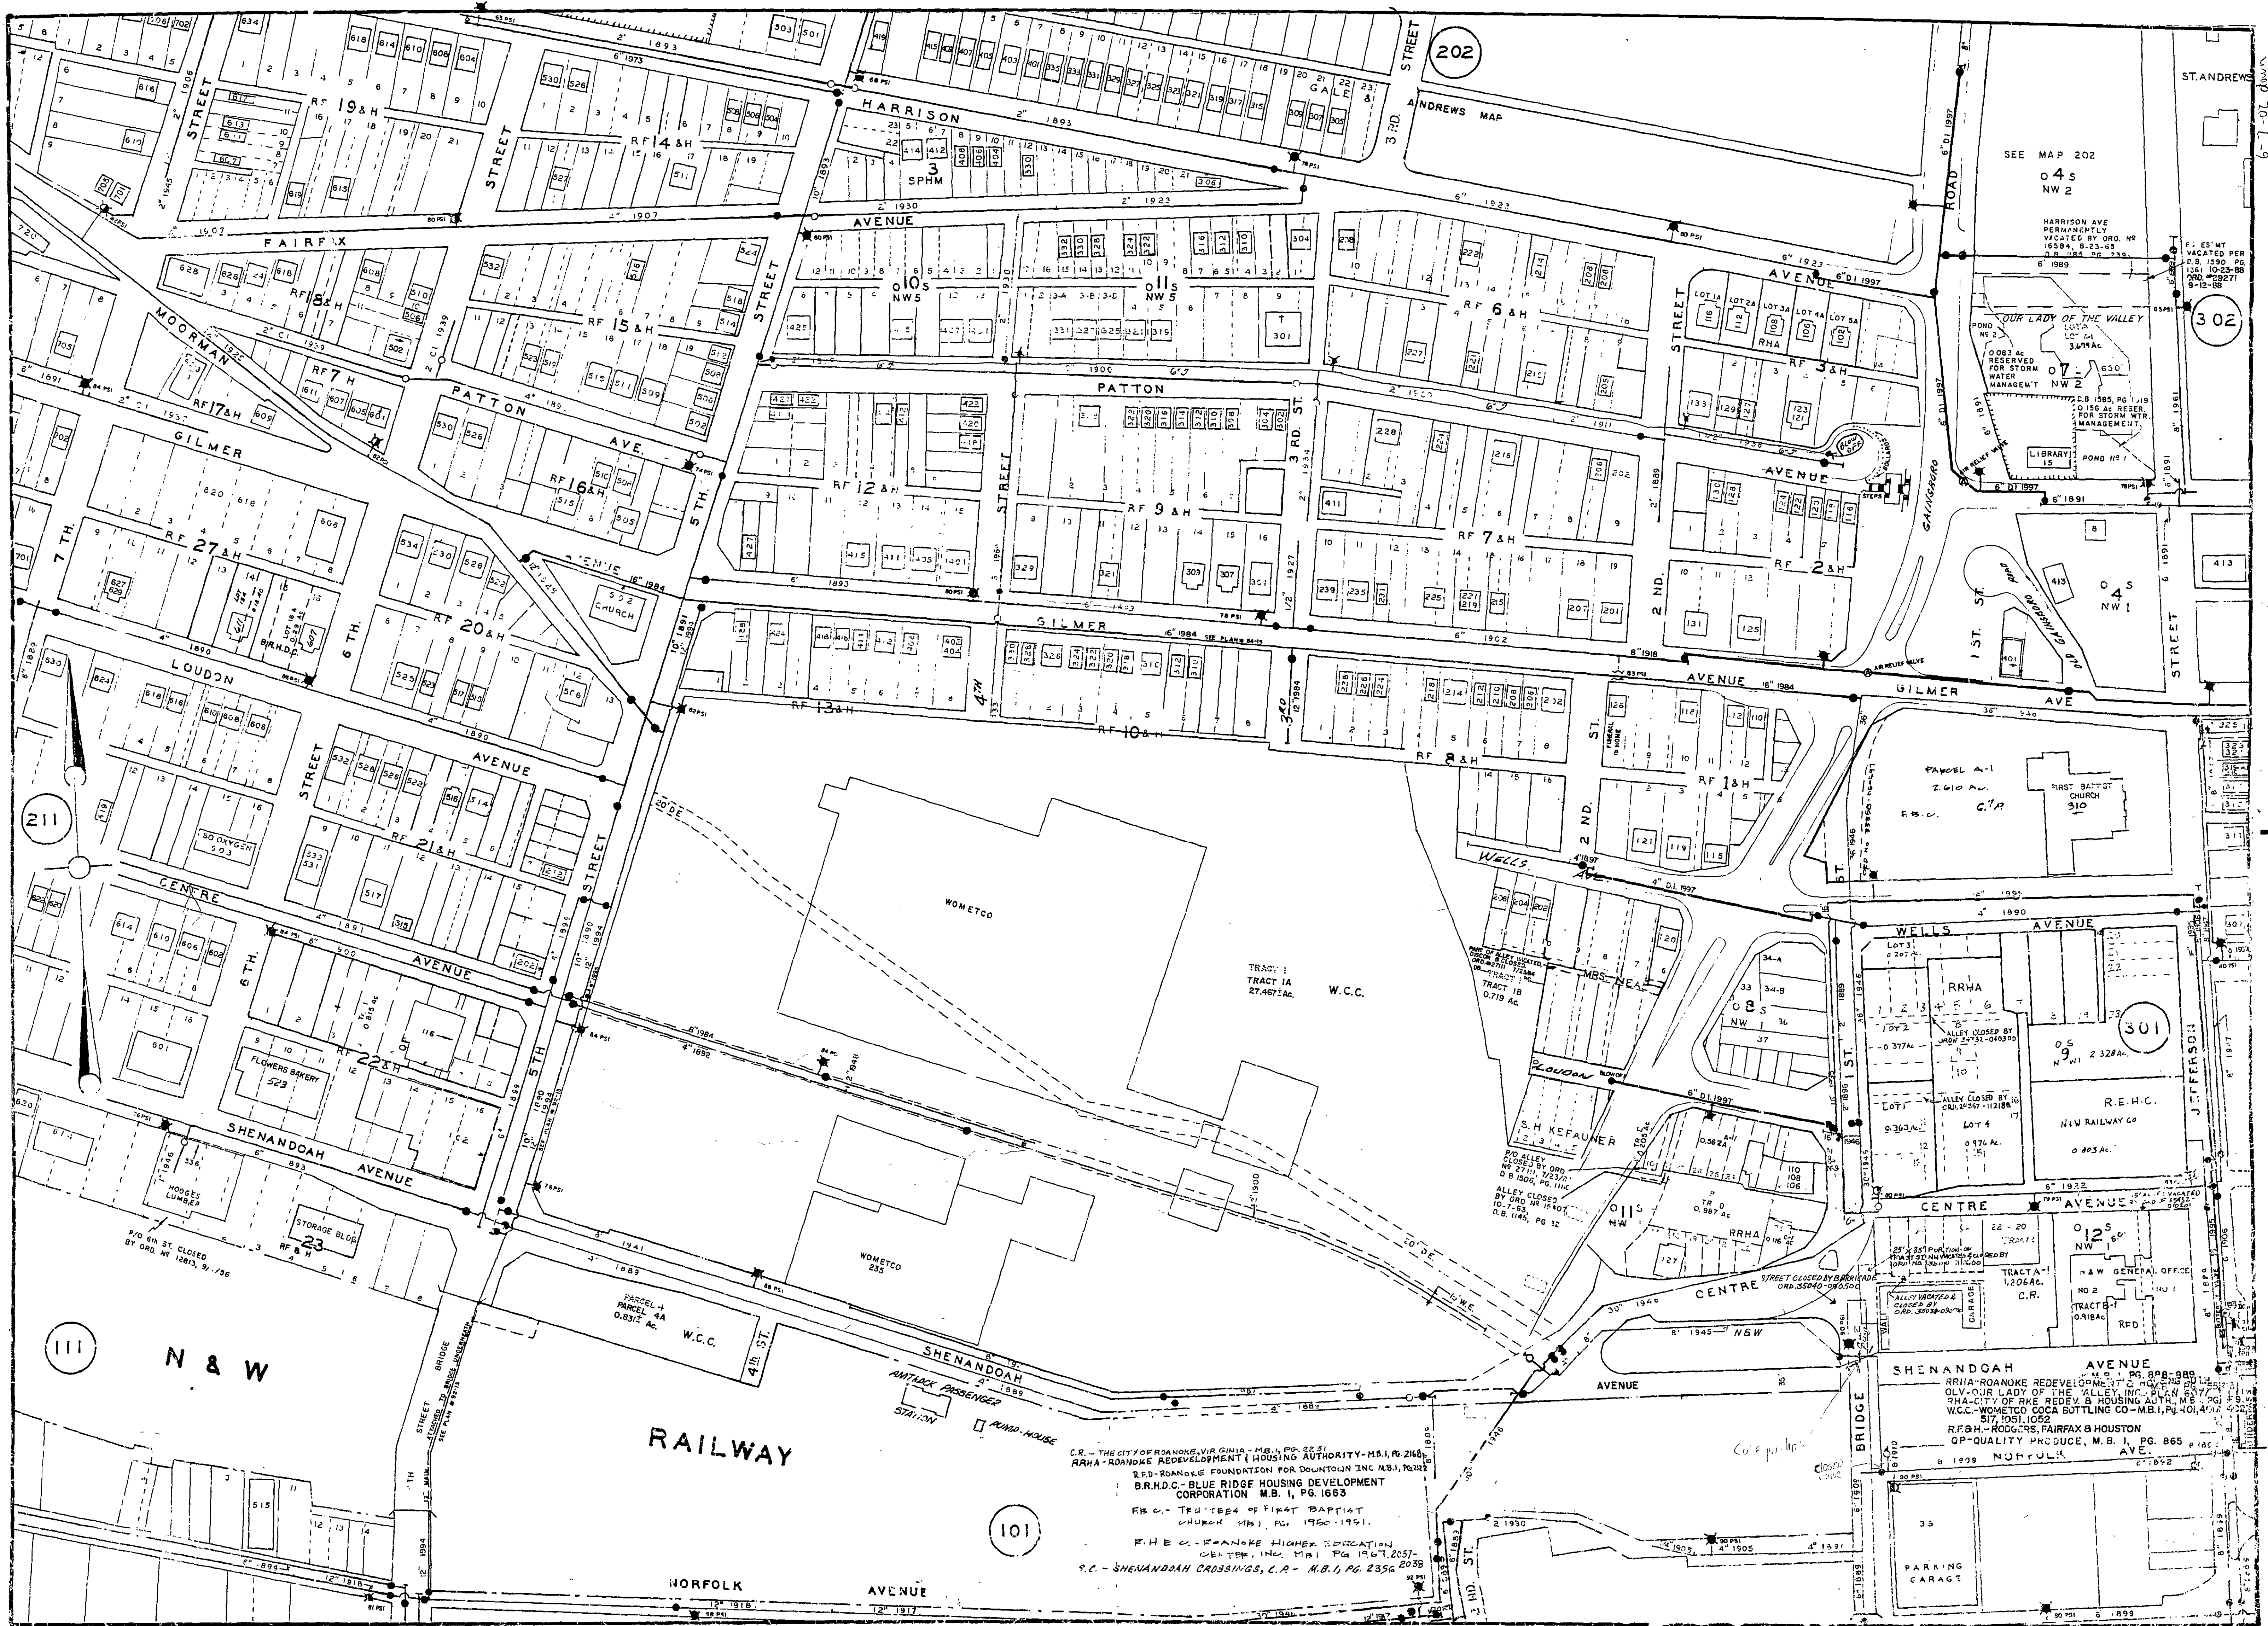

RRHA - ROANOKE REDEVELOPMENT & HOUSING AUTHORITY, M.B. 1, PG. 2168
R.F.D. - ROANOKE FOUNDATION FOR DOWNTOWN INC. M.B. 1, PG. 2168
B.R.H.D.C. - BLUE RIDGE HOUSING DEVELOPMENT CORPORATION, M.B. 1, PG. 1663
