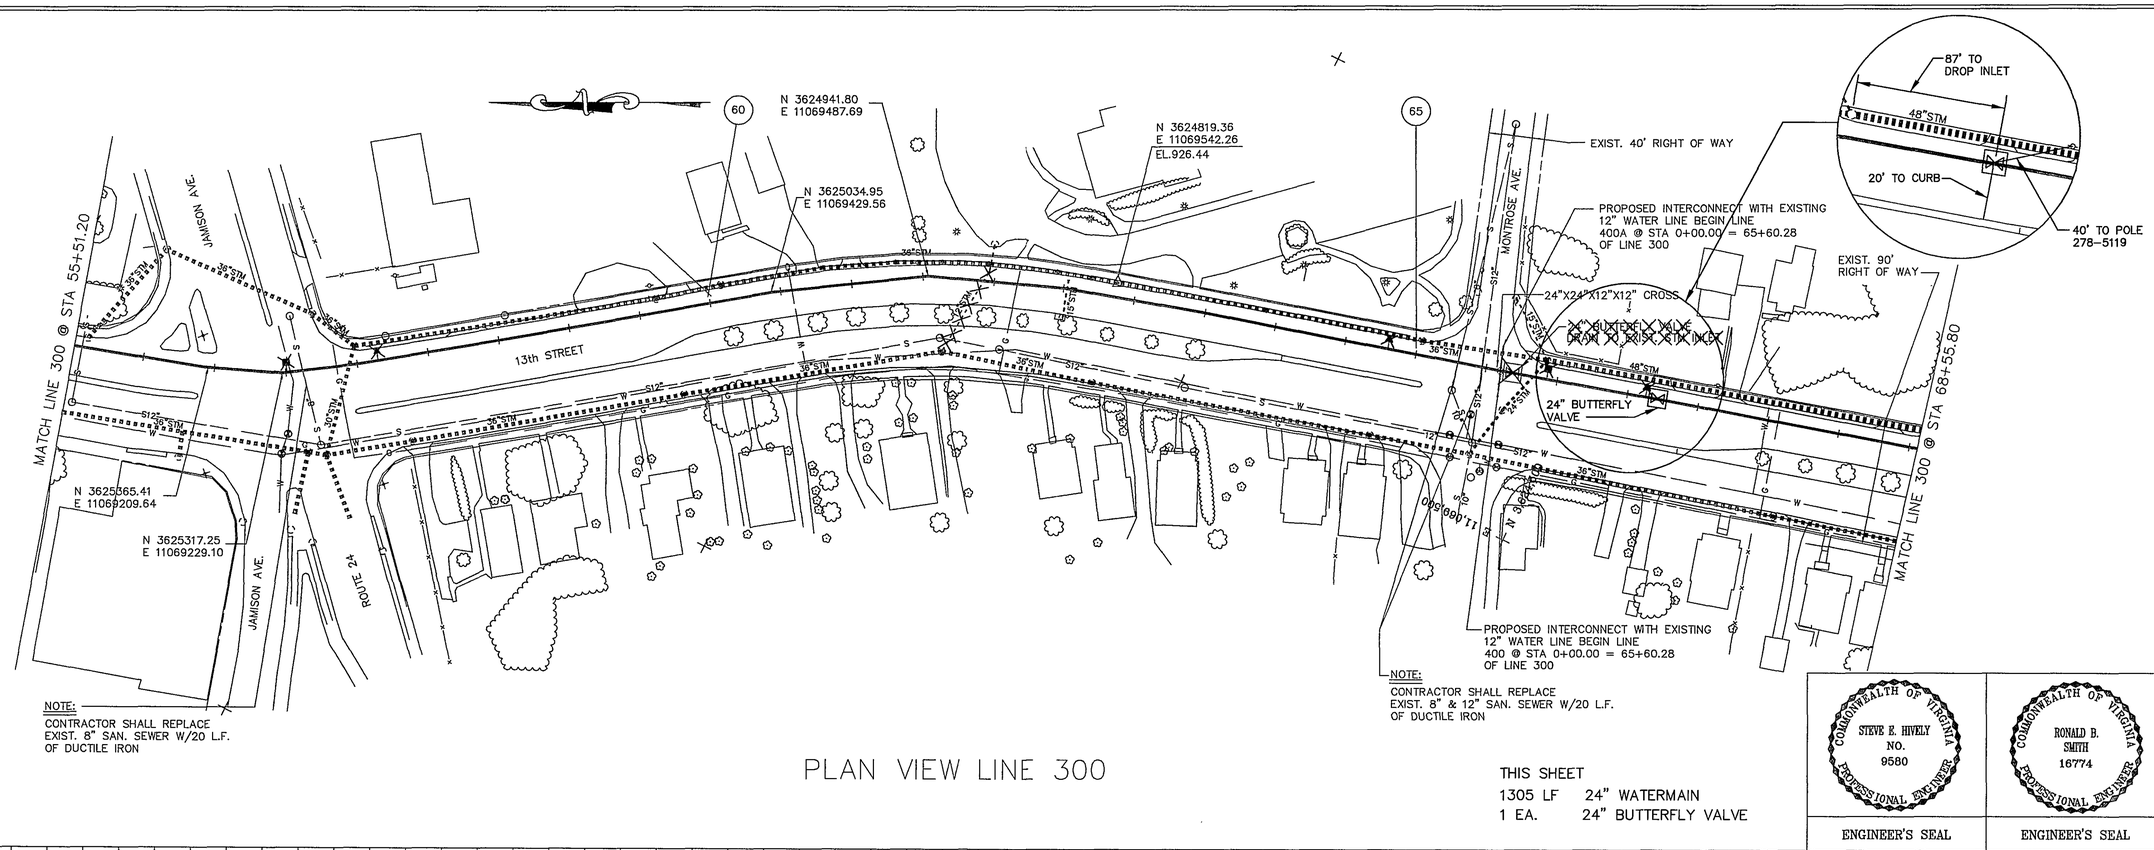

PLAN VIEW LINE 300

THIS SHEET
1305 LF 24" WATERMAIN
1 EA. 24" BUTTERFLY VALVE

COMMONWEALTH OF VIRGINIA
STEVE E. HIVELY
NO. 9580
PROFESSIONAL ENGINEER
ENGINEER'S SEAL

COMMONWEALTH OF VIRGINIA
RONALD B. SMITH
16774
PROFESSIONAL ENGINEER
ENGINEER'S SEAL

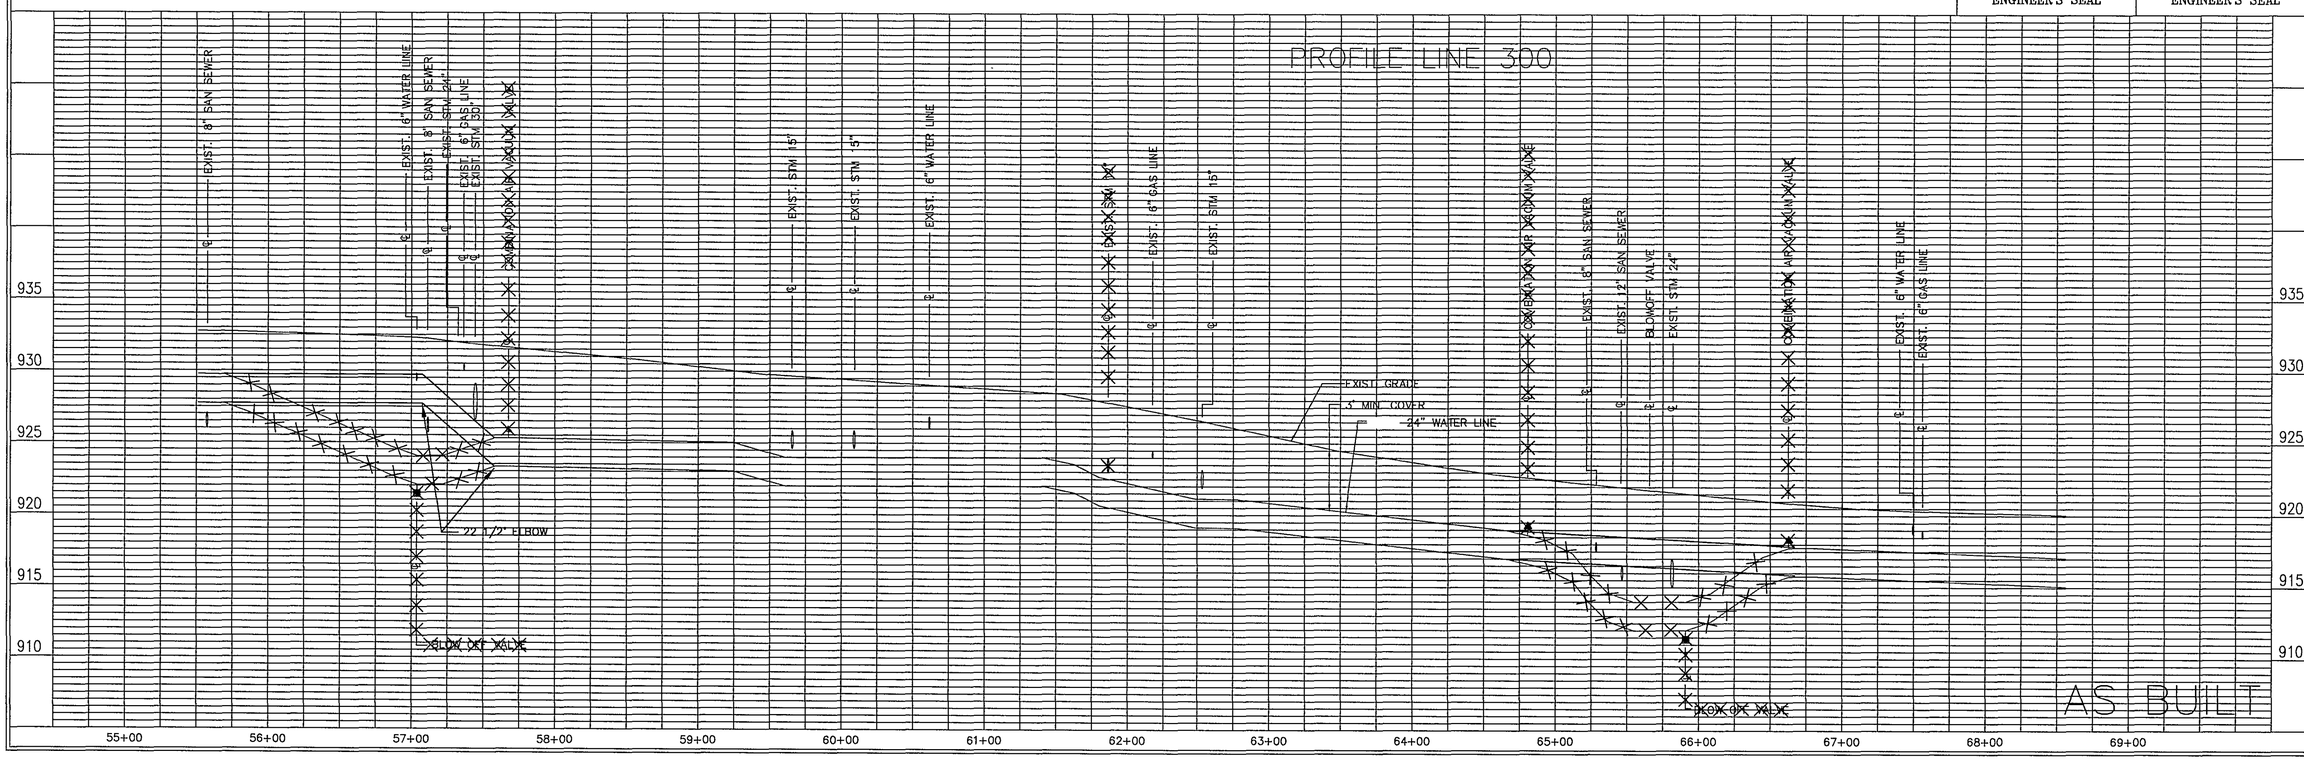

Dewberry & Davis
Architects
Engineers
Planners
Surveyors
5238 Valleypointe Parkway, Suite One-B
Roanoke, Virginia 24019
☎ 703 362-7725

Carvins Cove, Phase II
City of Roanoke
Roanoke, Virginia

CONTRACT "C1"
LINE 300
STA 55+51.20 - 68+55.80

Drawn By	REH/ACF
Designed By	RBS
Checked By	SEH
Date	APRIL 93
Scale	V: 1" = 5' H: 1" = 50'
Plan Number	D1
Zoned	NONE
Sheet	6 of 12
File Number	C1160