


NOTICE:

The location of features and utilities are shown on this map so far as their existence and location were known at the time of the preparation of this map. Nothing on this map shall be construed as a guarantee that any feature or utility are in the location indicated or that they actually exist.

NOTE: "X" ON PARCEL DENOTES ILLEGAL SUBDIVISION

NOTE:
R.J.M.-C.M.-D.A.G., M.B.I., PG.1219-1220.
F.M.C.-FRANK MC CARTER, MBI, PG.2253.
S.J.C.-SHERMAN W. JENELL B. CHIDOM, M.B.I., PG.2397

401

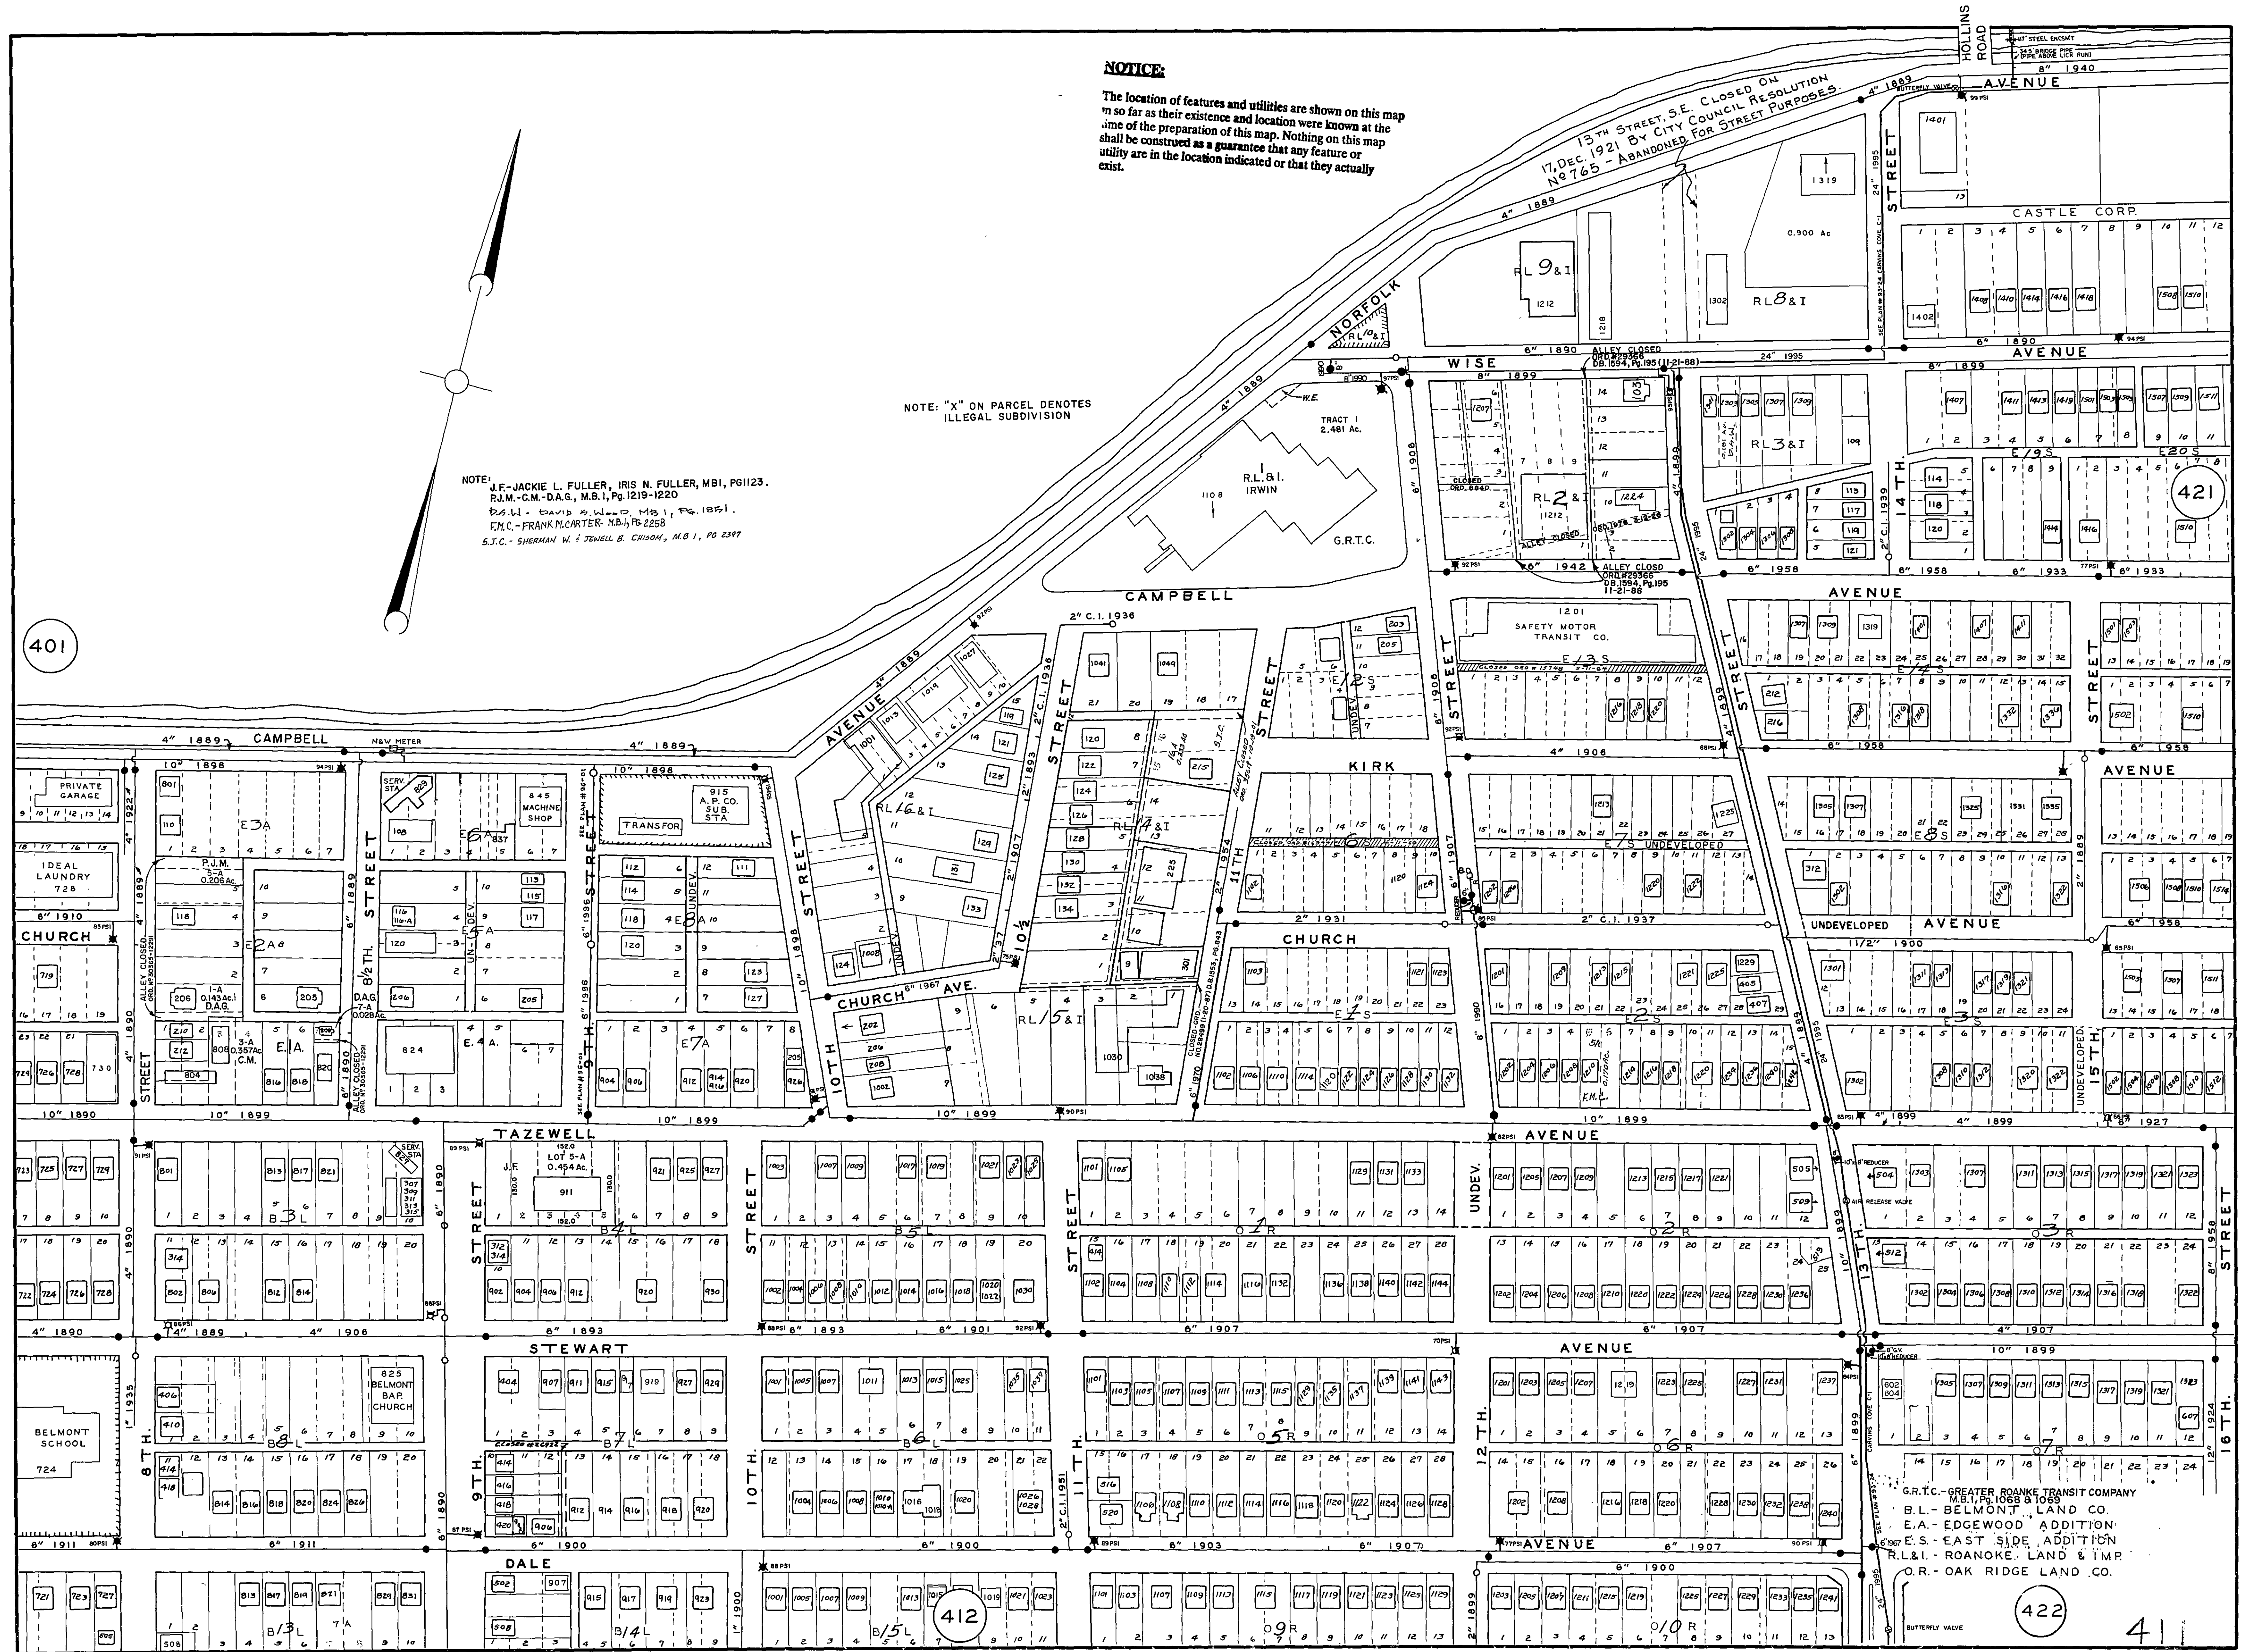

412

422

411