THIS SHEET
1265 LF 24" WATERMAIN
1 EA. 6" BLOWOFF
1 EA. 1" A.R.V.

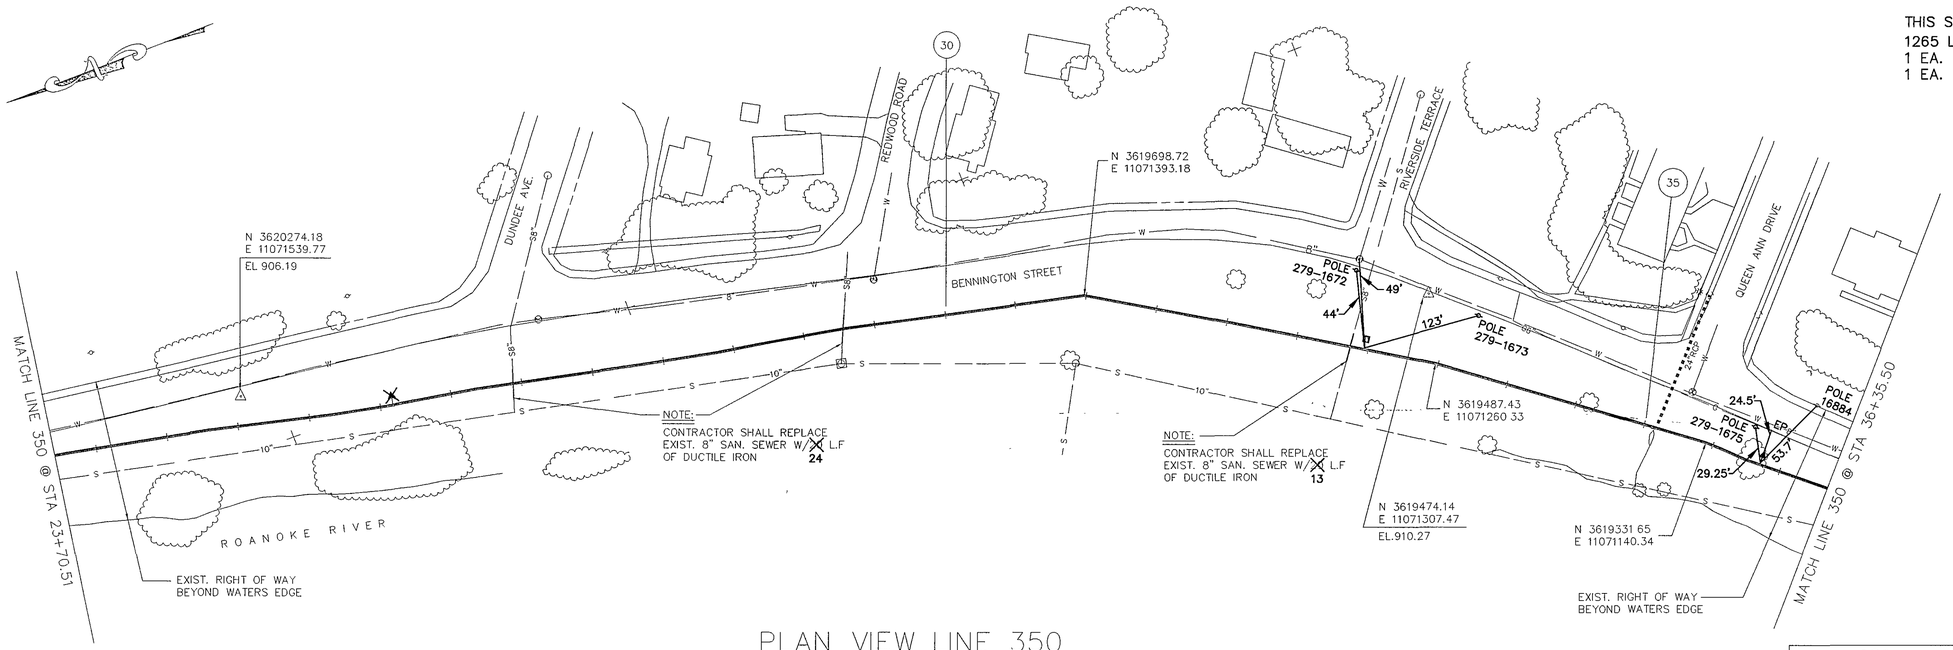

PLAN VIEW LINE 350

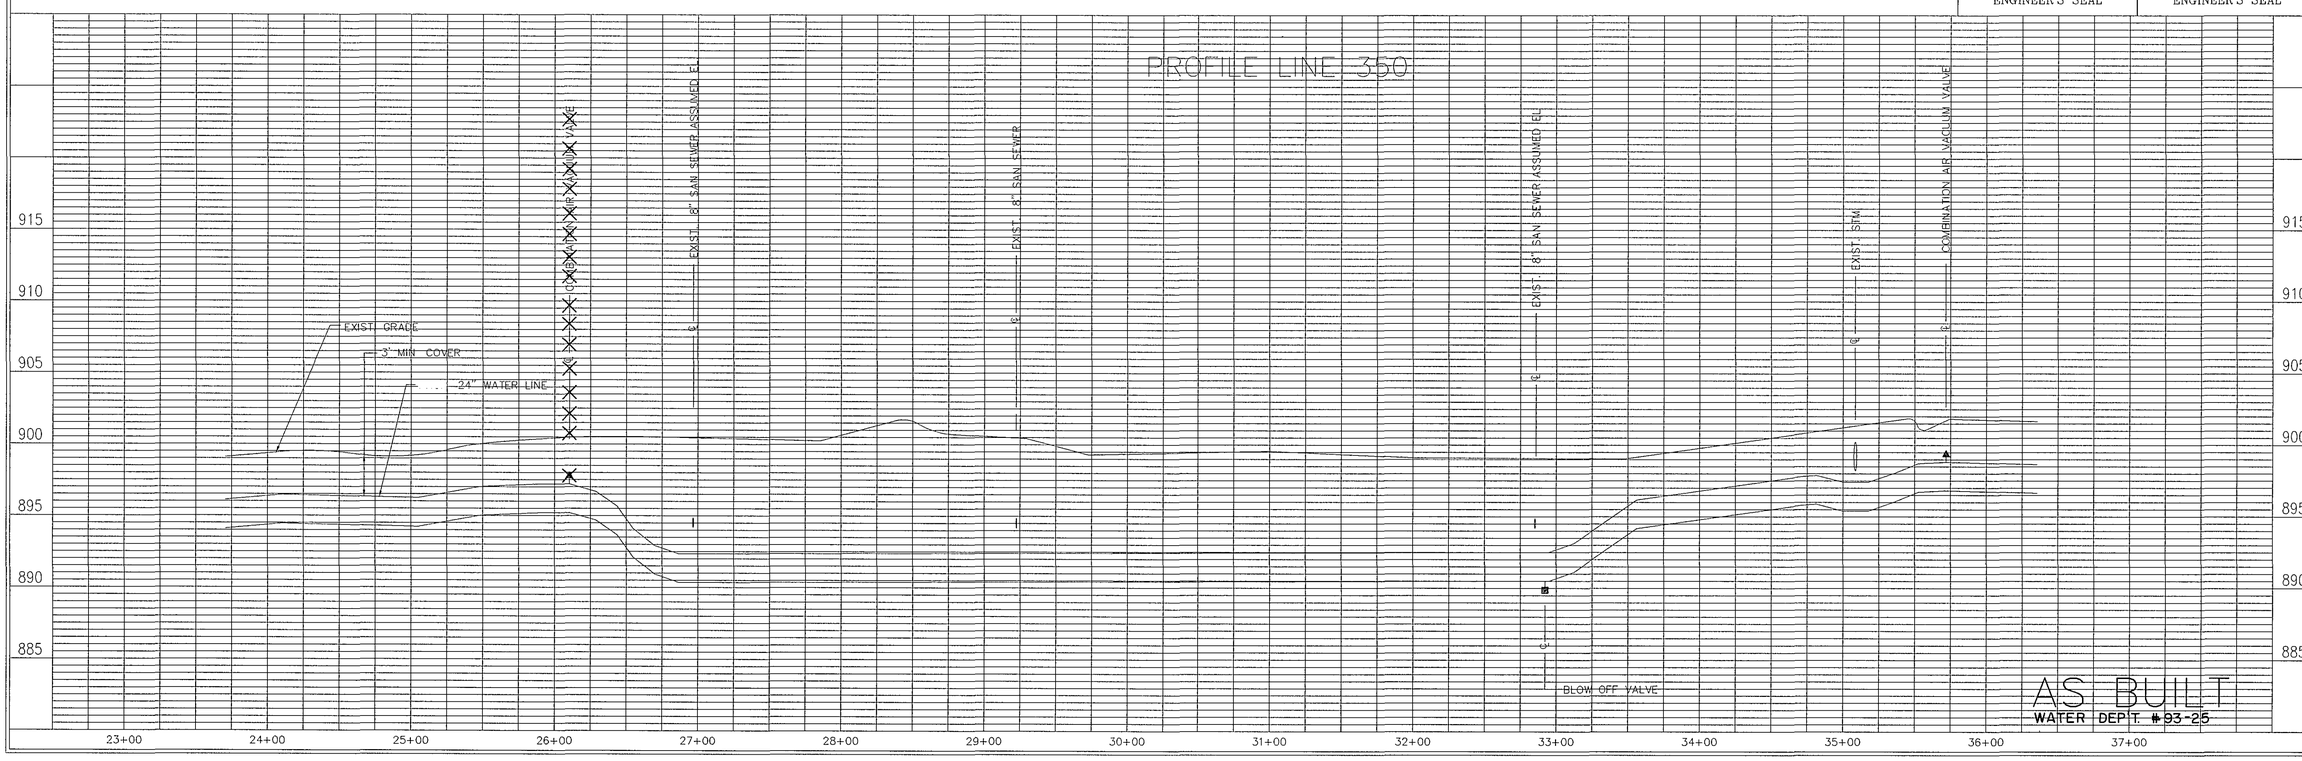

AS BUILT
WATER DEPT. #93-25

COMMONWEALTH OF VIRGINIA
STEVE E. HIVELY
NO. 9580
PROFESSIONAL ENGINEER
ENGINEER'S SEAL

COMMONWEALTH OF VIRGINIA
RONALD B. SMITH
16774
PROFESSIONAL ENGINEER
ENGINEER'S SEAL

Dewberry & Davis
Architects
Engineers
Planners
Surveyors
5238 Valleypointe Parkway, Suite One-B
Roanoke, Virginia 24019
☎ 703 362-7725

Carvins Cove, Phase II
City of Roanoke
Roanoke, Virginia

CONTRACT "C2"
LINE 350
STA 23+70.51 – 36+35.50

Drawn By	ACF/REH
Designed By	RBS
Checked By	SEH
Date	MARCH 93
Scale	V: 1" = 5' H: 1" = 50'
Plan Number	D6
Zoned	NONE
Sheet	3 of 25
File Number	C1160