THIS SHEET

| | |
|---|---|
| 1195 LF | 24" WATERMAIN |
| 2 EA. | 6" BLOWOFF |
| 1 EA. | 1" A.R.V. |

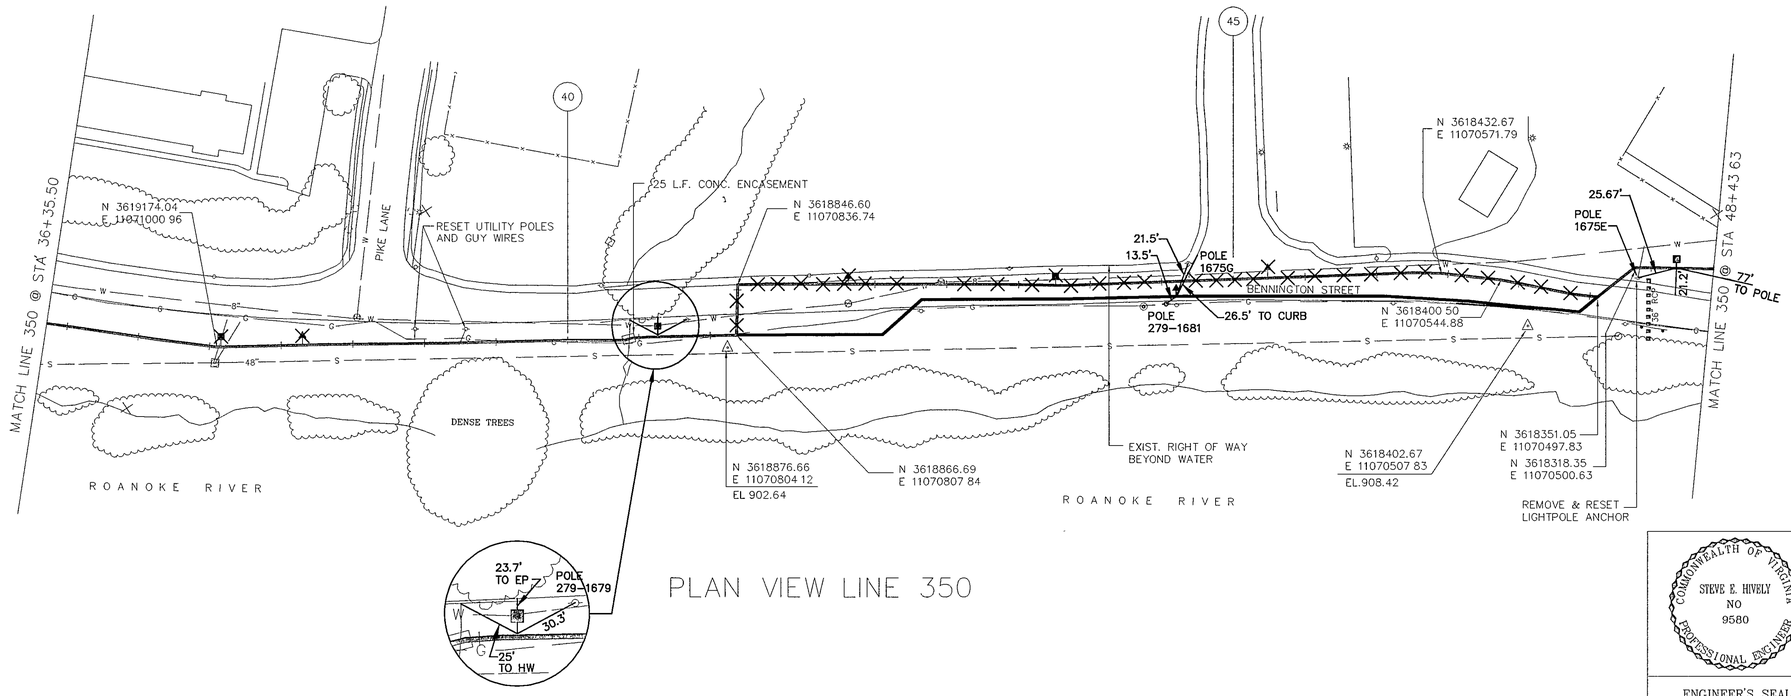


PLAN VIEW LINE 350

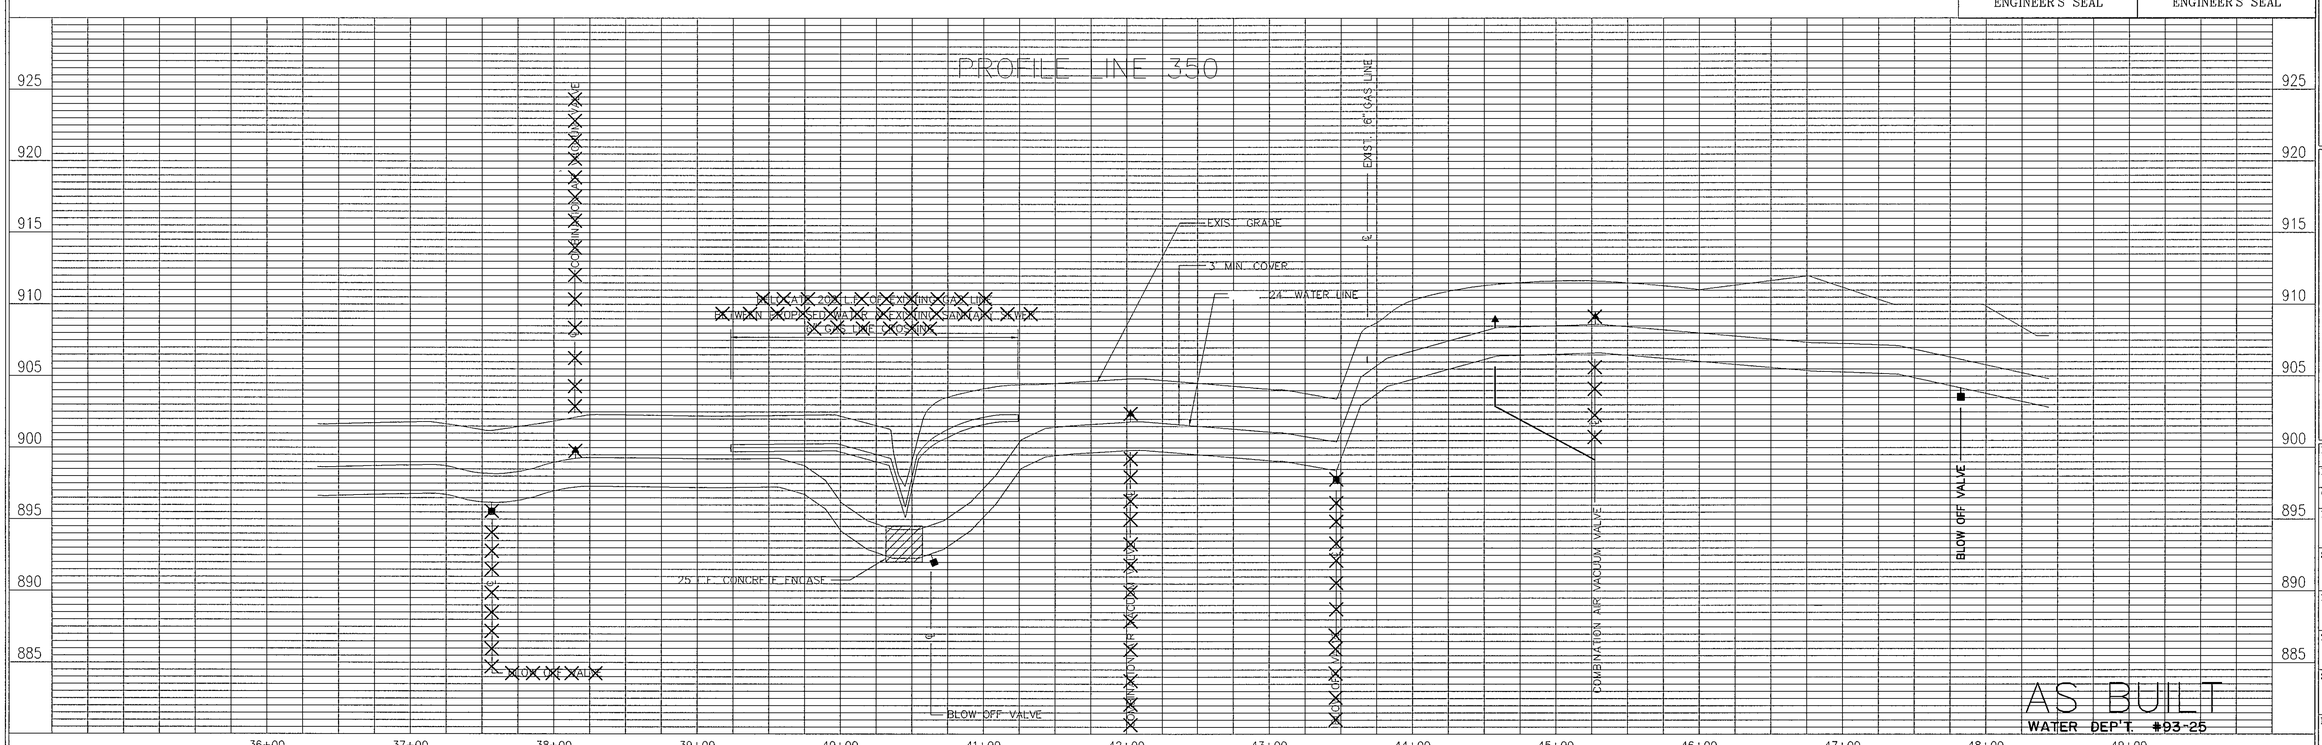


AS BUILT
WATER DEP'T. #93-25

COMMONWEALTH OF VIRGINIA
STEVE E. HIVELY
NO 9580
PROFESSIONAL ENGINEER
ENGINEER'S SEAL

COMMONWEALTH OF VIRGINIA
RONALD B. SMITH
16774
PROFESSIONAL ENGINEER
ENGINEER'S SEAL


Dewberry & Davis
Architects Engineers Planners Surveyors
5238 Valleypointe Parkway, Suite One-B
Roanoke, Virginia 24019
☎ 703 362-7725


# Carvins Cove, Phase II

City of Roanoke
Roanoke, Virginia

CONTRACT "C2"
LINE 350
STA 36+35.50 - 48+43.63

| | |
|---|---|
| Drawn By | ACF/REH |
| Designed By | RBS |
| Checked By | SEH |
| Date | MARCH 93 |
| Scale | V: 1" = 5' H: 1" = 50' |
| Plan Number | D7 |
| Zoned | NONE |
| Sheet | 4 of 25 |
| File Number | C1160 |