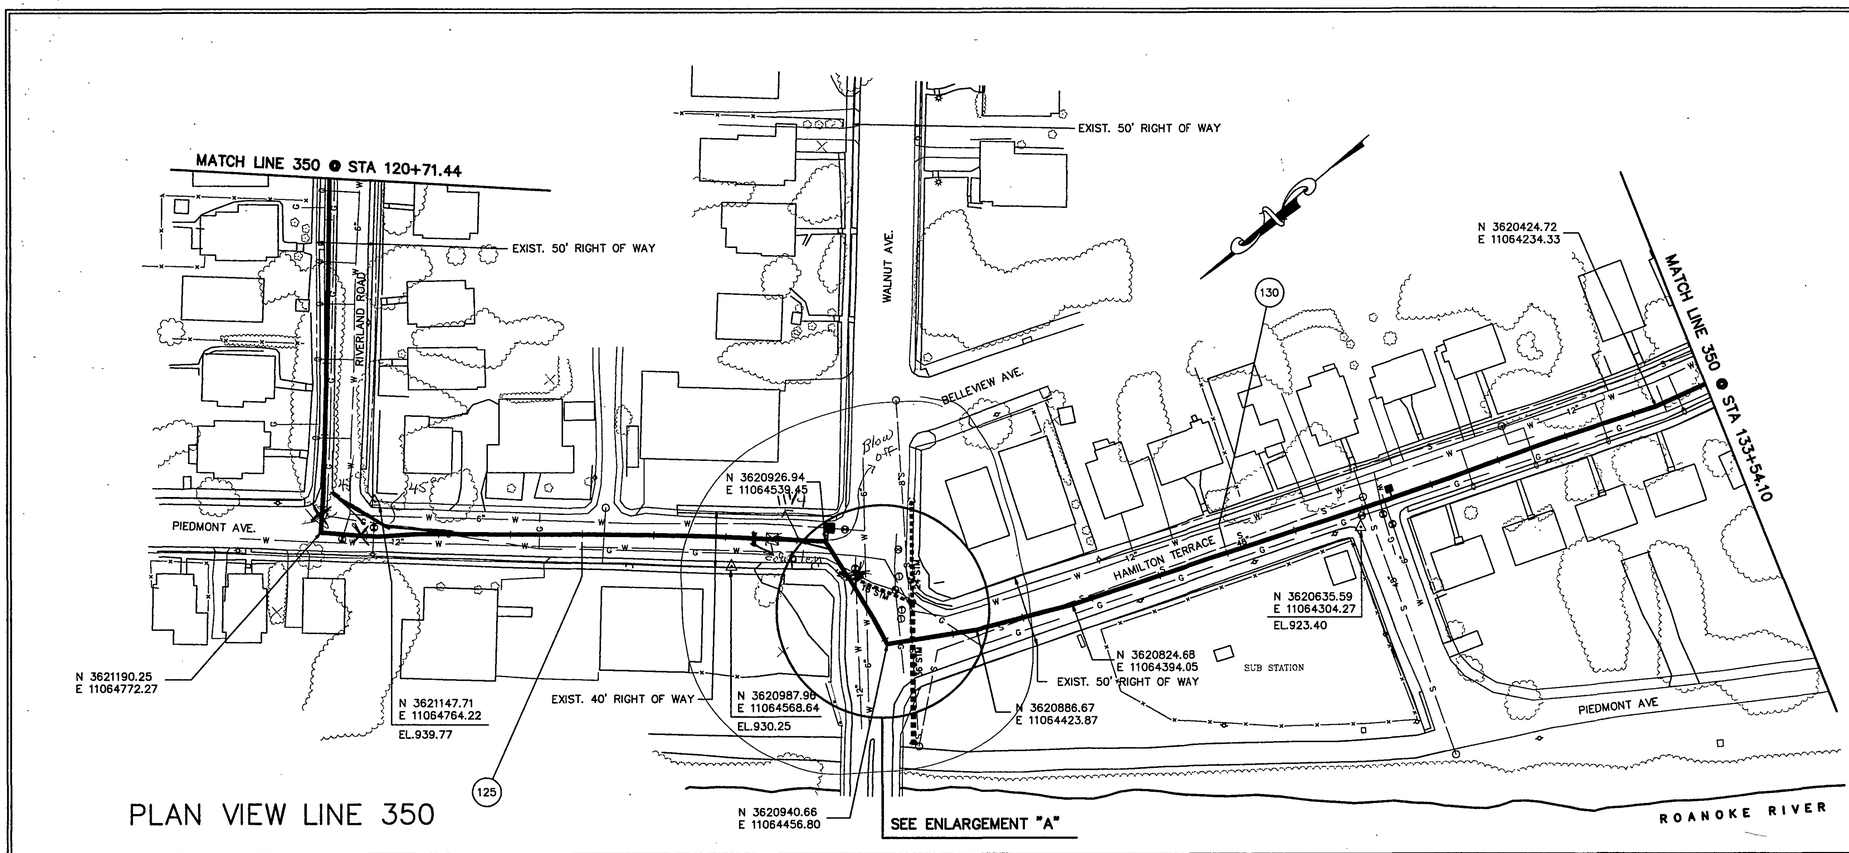

PLAN VIEW LINE 350

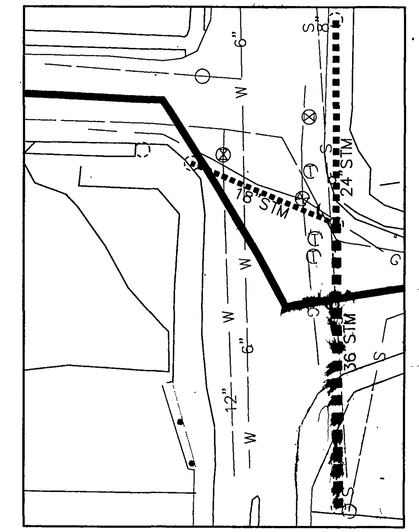

ENLARGEMENT "A"

NTS

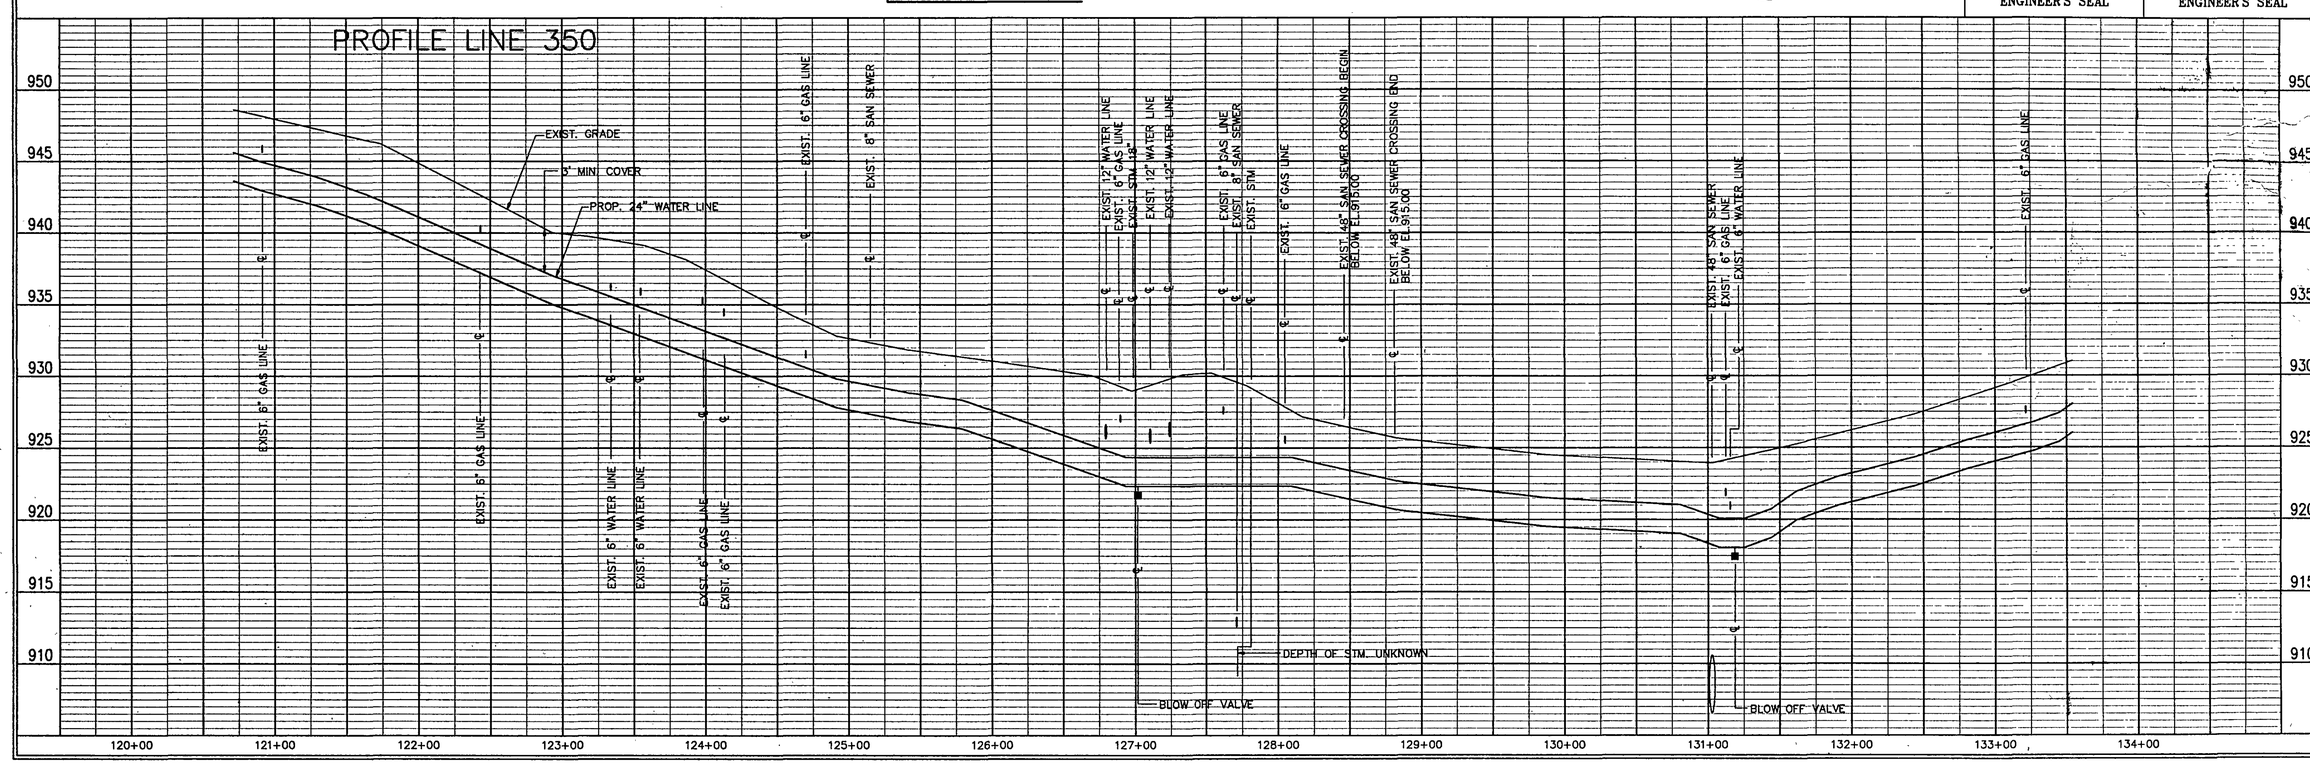

COMMONWEALTH OF VIRGINIA
STEVE E. HIVELY
NO. 9580
3-3-93
PROFESSIONAL ENGINEER

ENGINEER'S SEAL

COMMONWEALTH OF VIRGINIA
RONALD B. SMITH
16774
3/31/93
PROFESSIONAL ENGINEER

ENGINEER'S SEAL

Dewberry & Davis
Architects
Engineers
Planners
Surveyors
5238 Valleypointe Parkway, Suite One-B
Roanoke, Virginia 24019
(703) 362-7725

Carvins Cove, Phase II

City of Roanoke
Roanoke, Virginia

CONTRACT "C2"
LINE 350
STA 120+71.44 - 133+54.10

Drawn By	REH/ACF
Designed By	RBS
Checked By	SEH
Date	MARCH 93
Scale	V: 1" = 5' H: 1" = 50'
Plan Number	D14
Zoned	NONE
Sheet	11 of 25
File Number	C1160