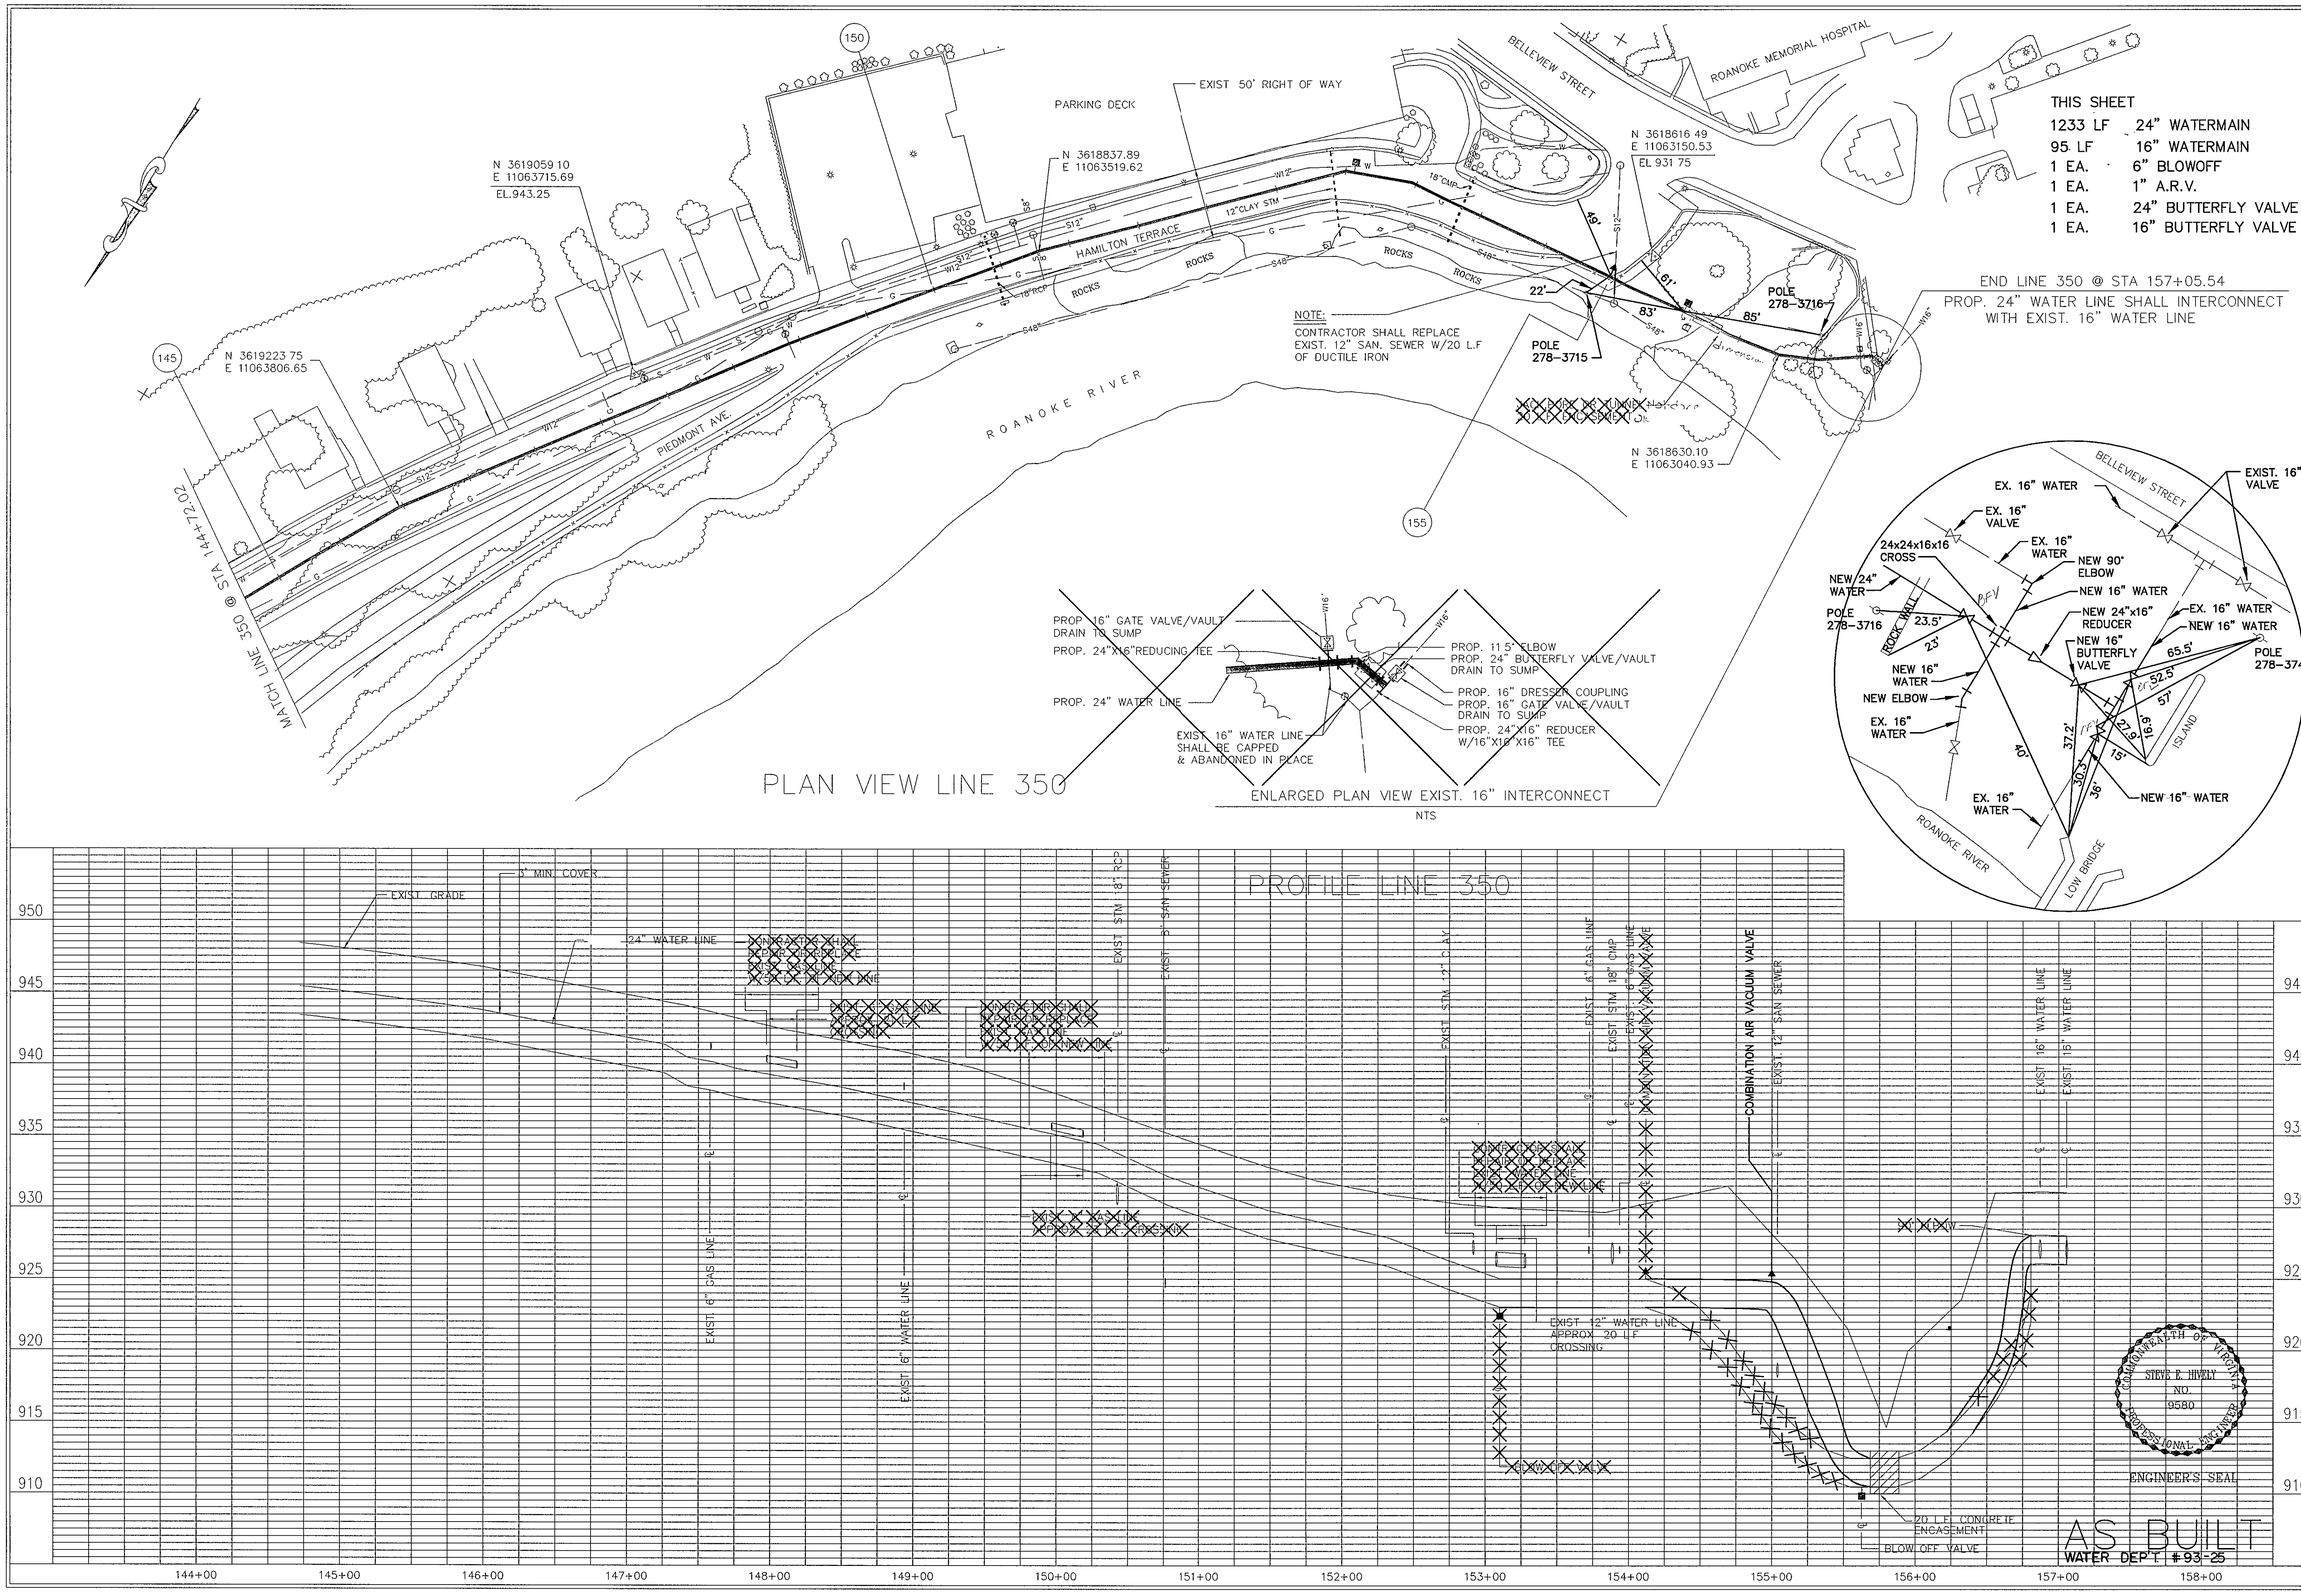

Dewberry & Davis
Architects Engineers Planners Surveyors
5238 Valleypointe Parkway, Suite One-B
Roanoke, Virginia 24019
☎ 703 362-7725

Carvins Cove, Phase II
City of Roanoke
Roanoke, Virginia

CONTRACT "C2"
END LINE 350
STA 144+72.02 - 157+05.54

Drawn By	ACF/REH
Designed By	RBS
Checked By	SEH
Date	MARCH 93
Scale	V: 1" = 5' H: 1" = 50'
Plan Number	D16
Zoned	NONE
Sheet	13 of 25
File Number	C1160