


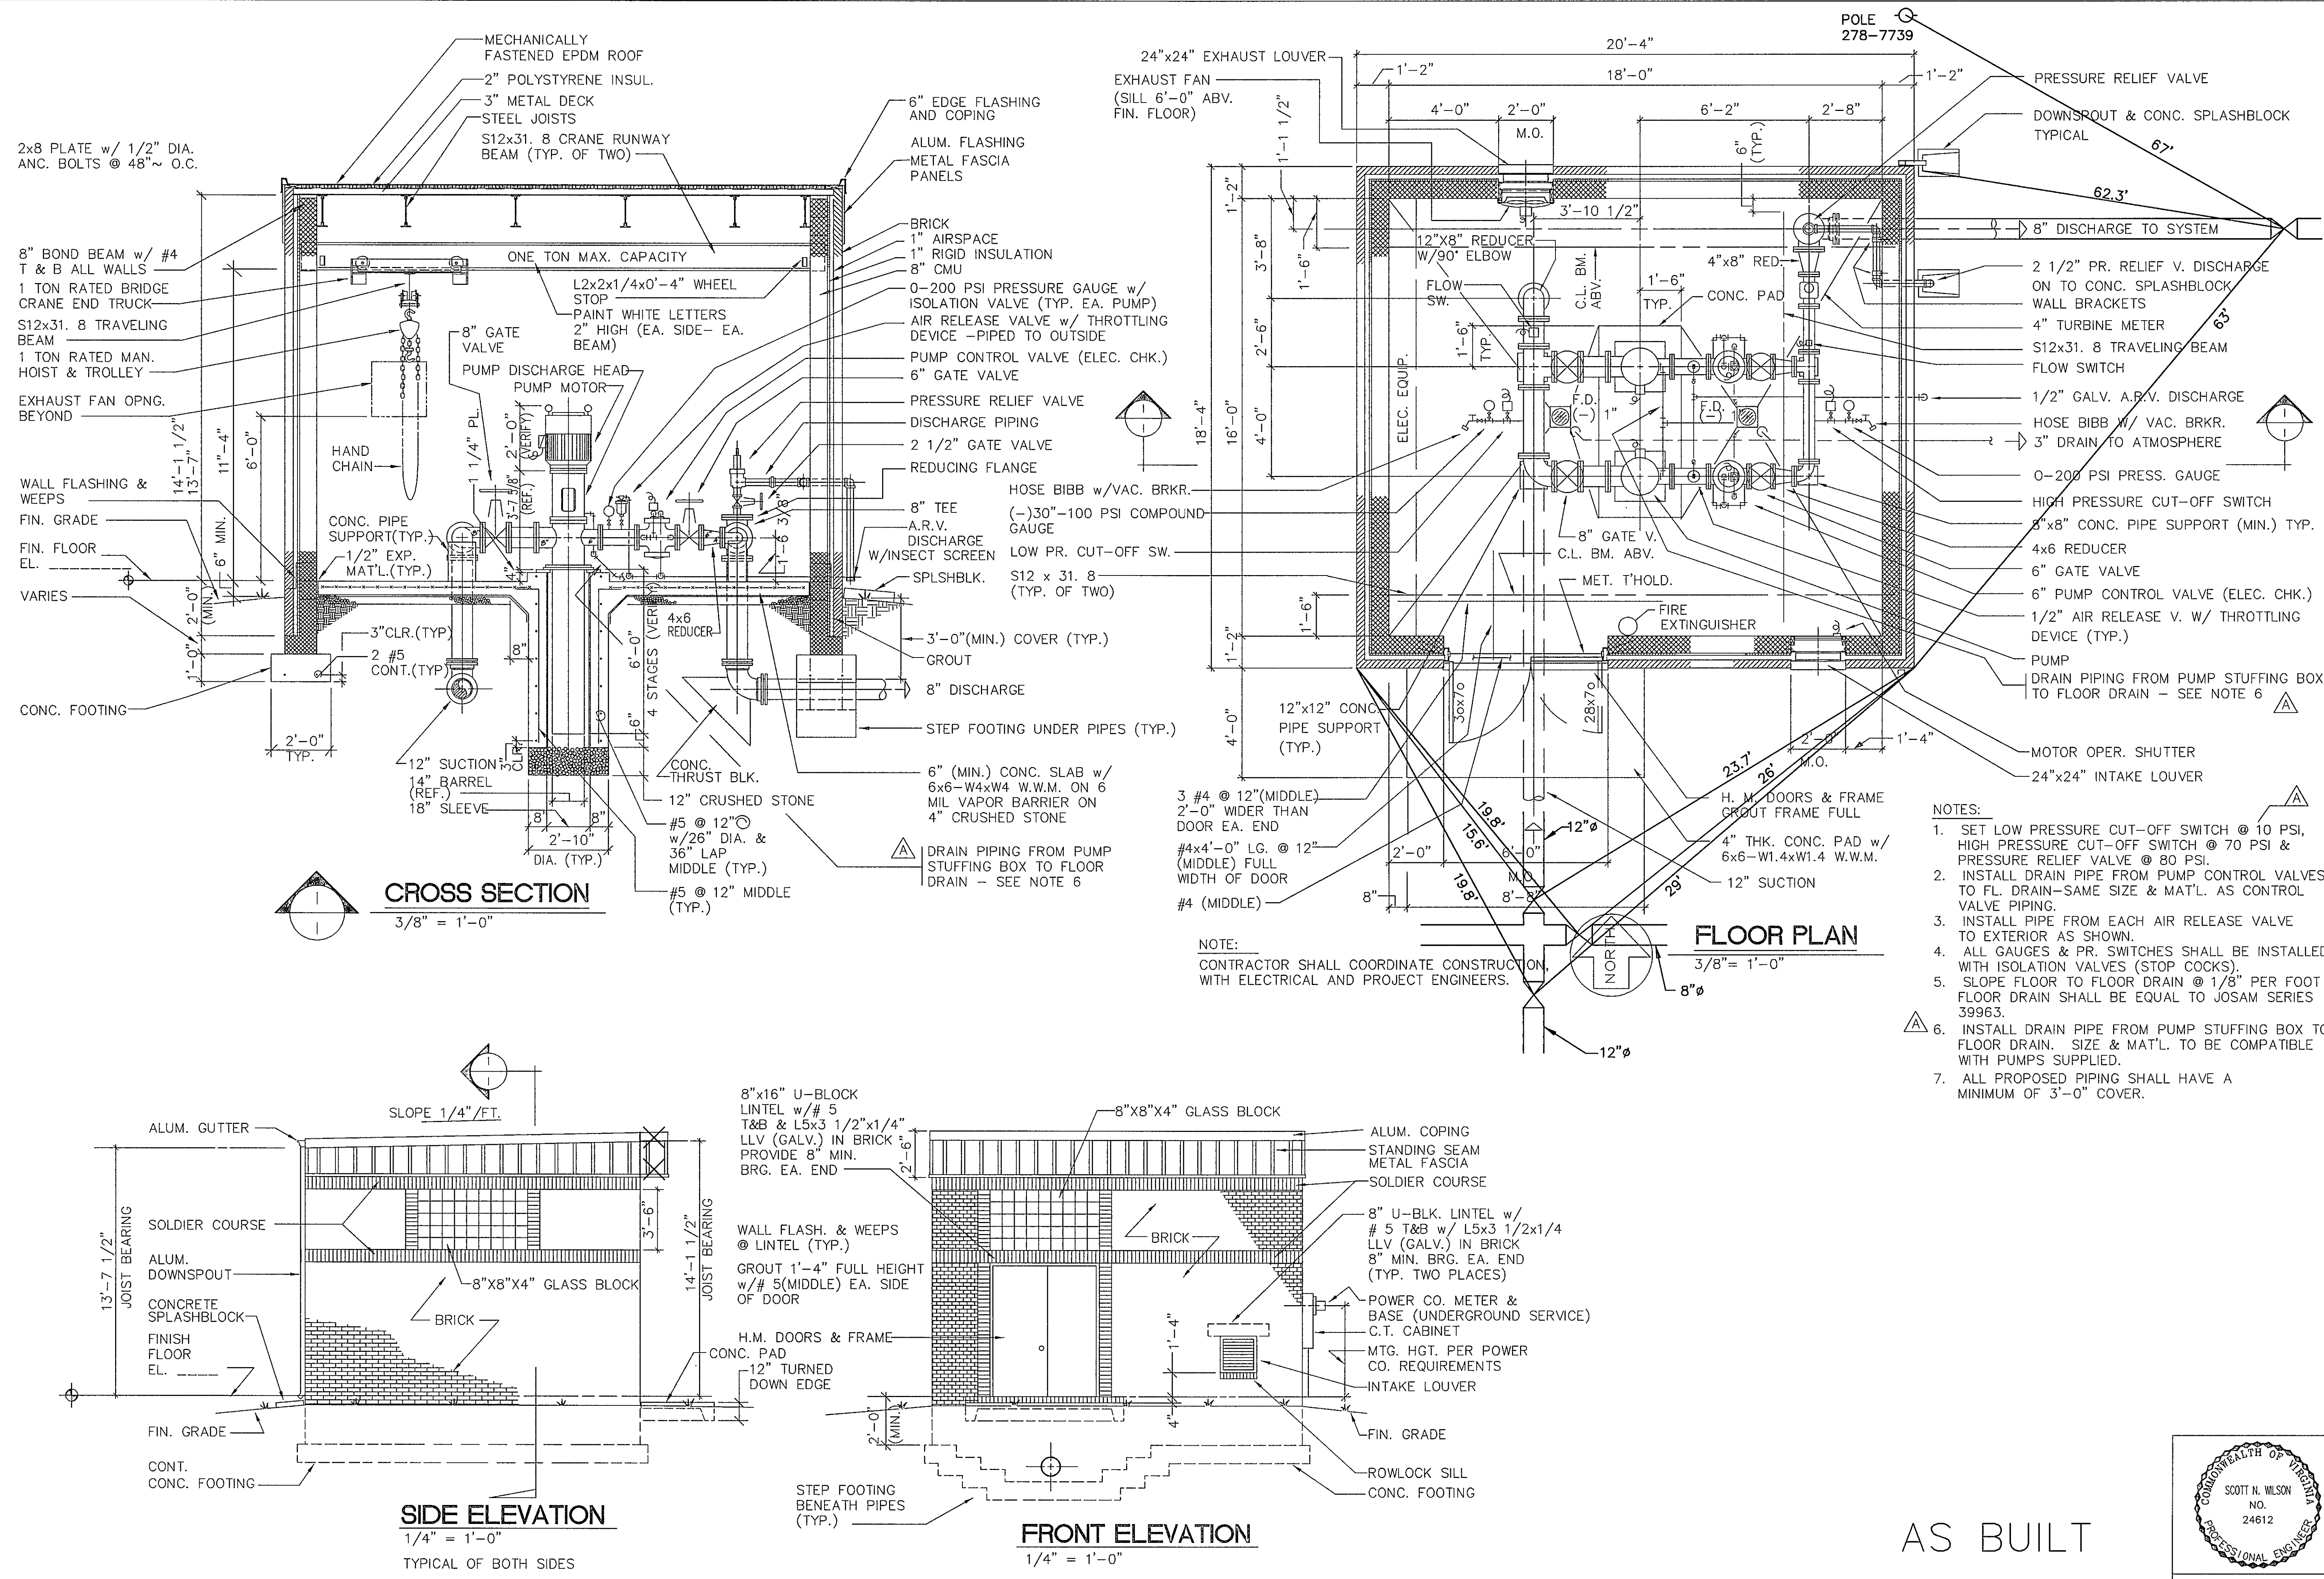

WATER DEP'T. # 93-25

Architects
Engineers
Planners
Surveyors

Dewberry & Davis

5238 Valleypointe Parkway, Suite One-B
Roanoke, Virginia 24019
703 362-7726

Carvins Cove, Phase II

City of Roanoke
Roanoke, Virginia

CONTRACT "C2"

PROP. MOUNT PLEASANT
PUMPING STATION DETAIL

Drawn By
ADL/ACF/REH

Designed By
RBS

Checked By
SEH

Date
MARCH 93

Scale
AS SHOWN

Plan Number
MTPPUMP

Zoned
NONE

Sheet
22 of 25

File Number
C1160

SCOTT N. WILSON
NO. 24612
PROFESSIONAL ENGINEER

ENGINEER'S SEAL