


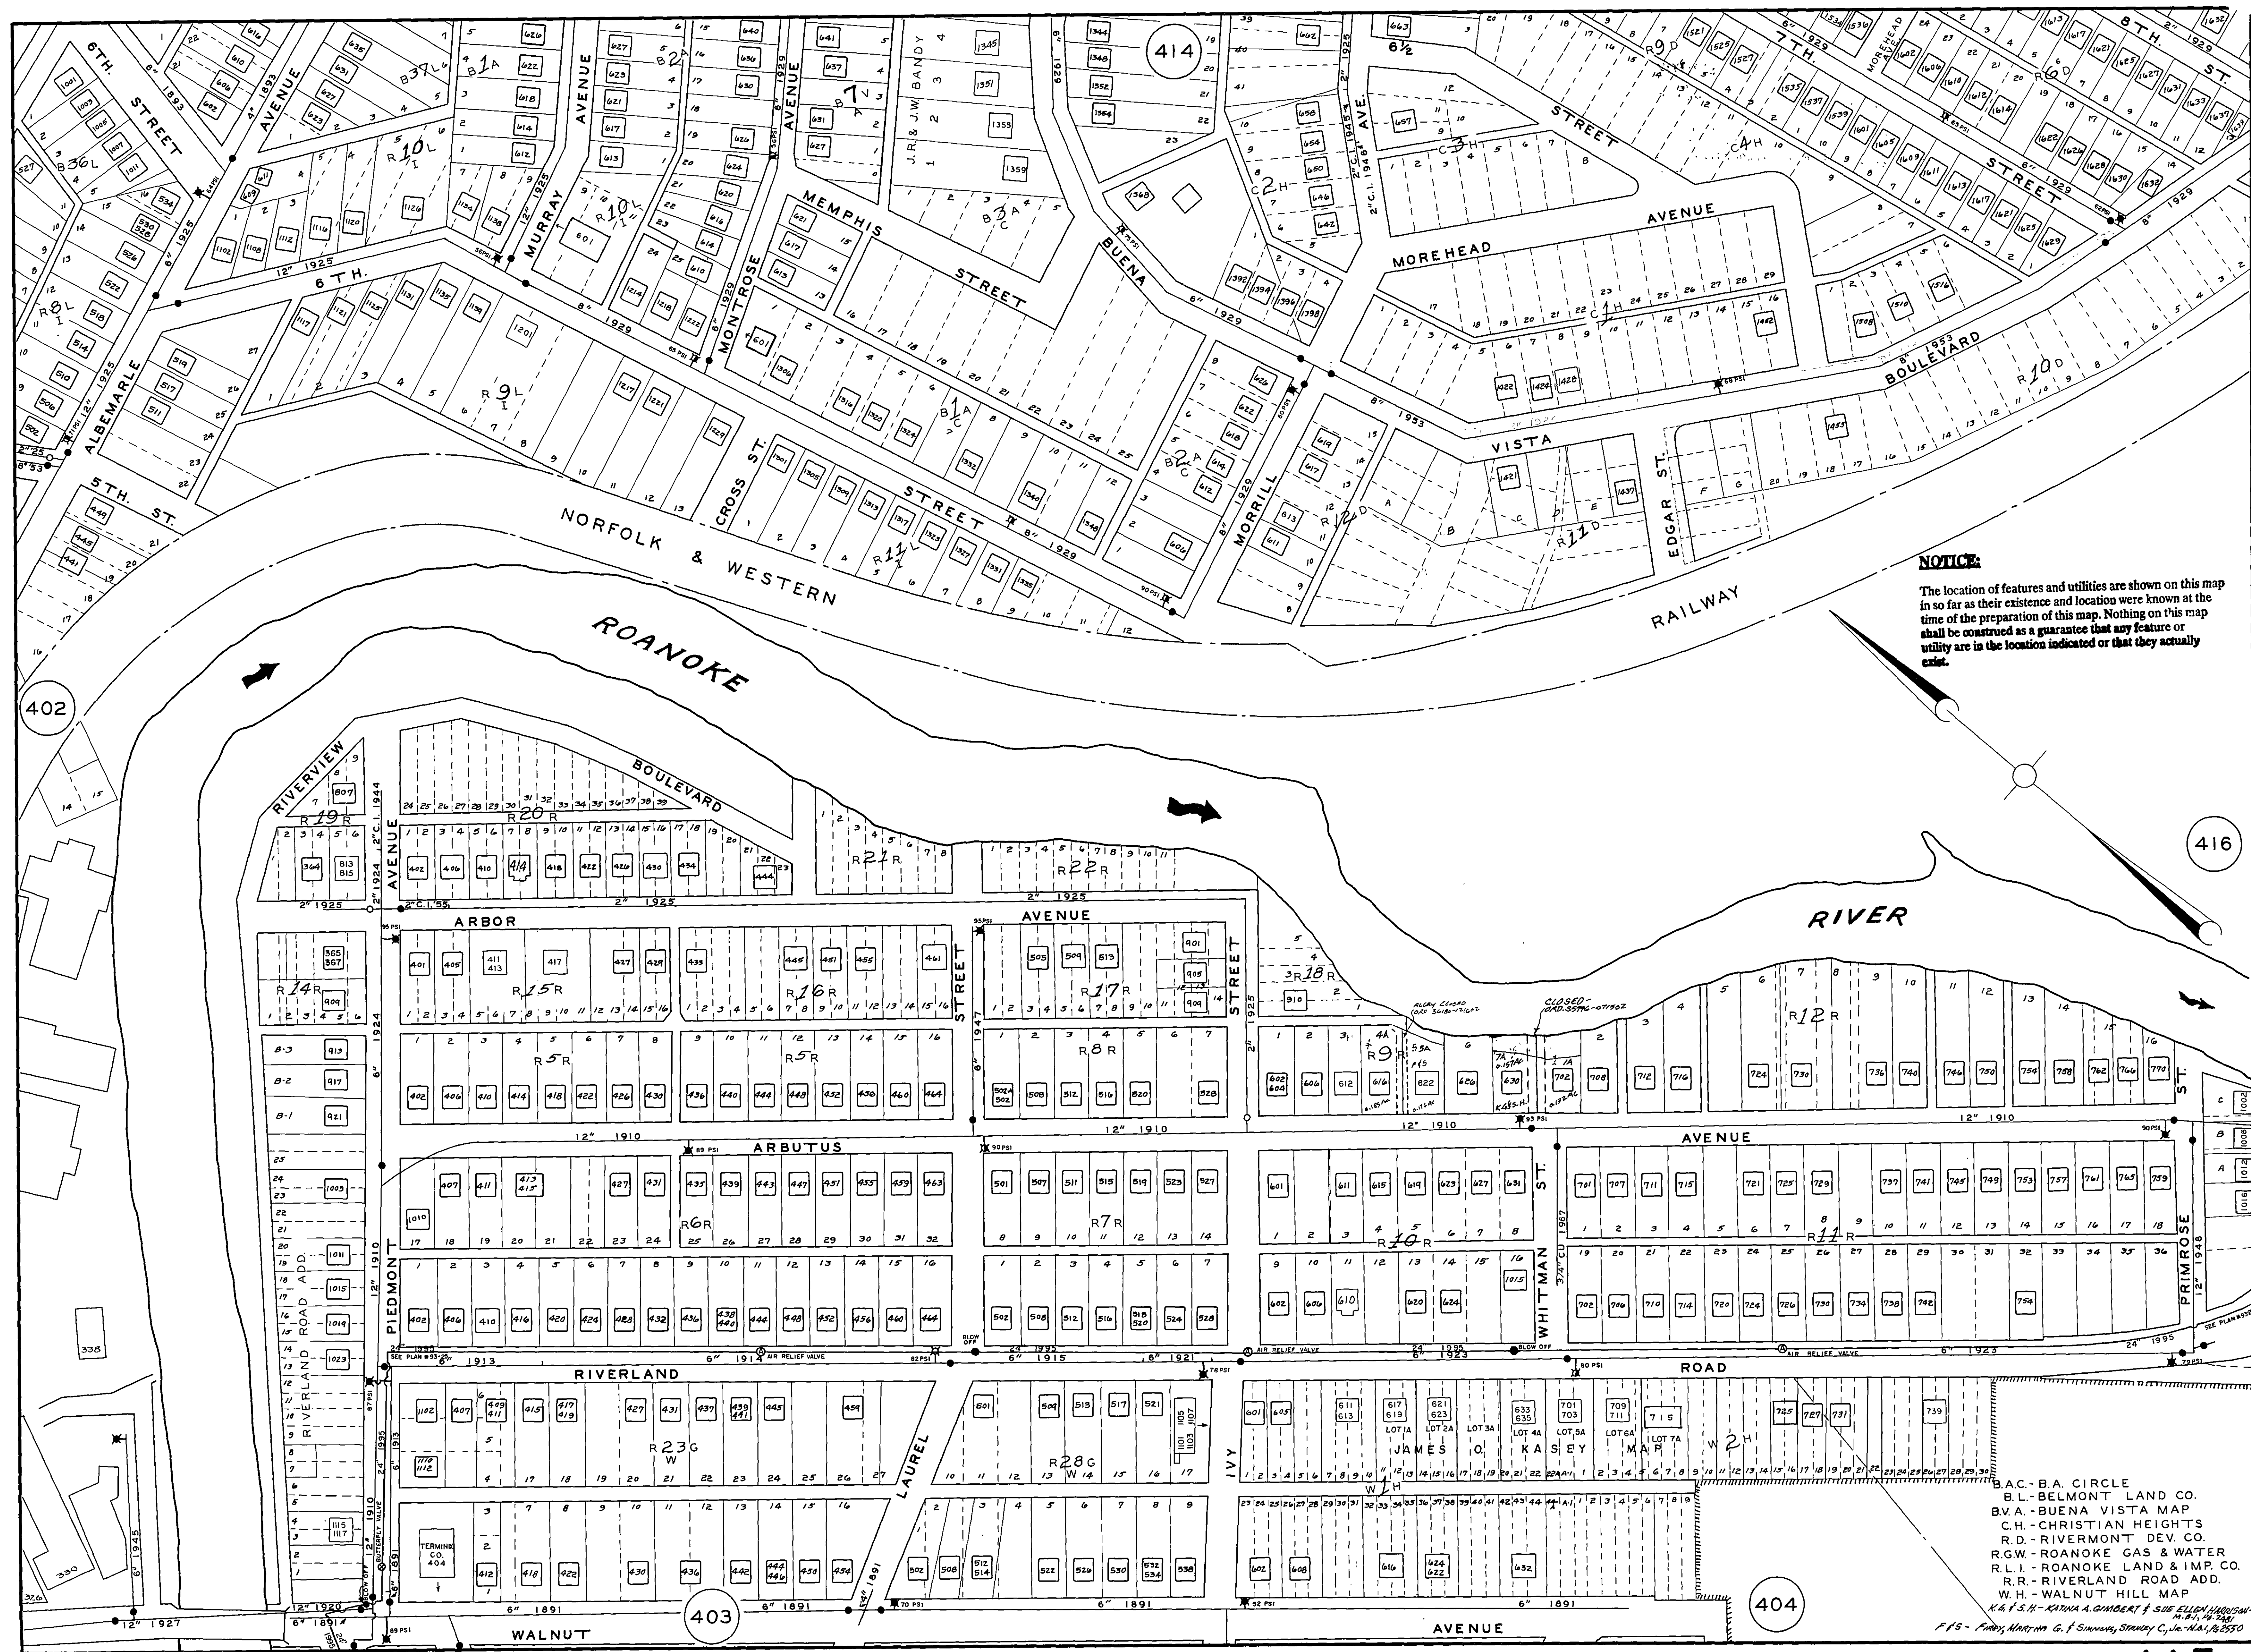

NOTICE:
The location of features and utilities are shown on this map in so far as their existence and location were known at the time of the preparation of this map. Nothing on this map shall be construed as a guarantee that any feature or utility are in the location indicated or that they actually exist.

B.A.C. - B.A. CIRCLE
B.L. - BELMONT LAND CO.
B.V.A. - BUENA VISTA MAP
C.H. - CHRISTIAN HEIGHTS
R.D. - RIVERMONT DEV. CO.
R.G.W. - ROANOKE GAS & WATER
R.L.I. - ROANOKE LAND & IMP. CO.
R.R. - RIVERLAND ROAD ADD.
W.H. - WALNUT HILL MAP
K.A. F.S.H. - KATHA A. GIMBERT & SUE ELLEN HARRISON
P.F.S. - PERRY, MARTHA G. F. SHUMWAY, STANLEY C. JR. - 11/1/1950