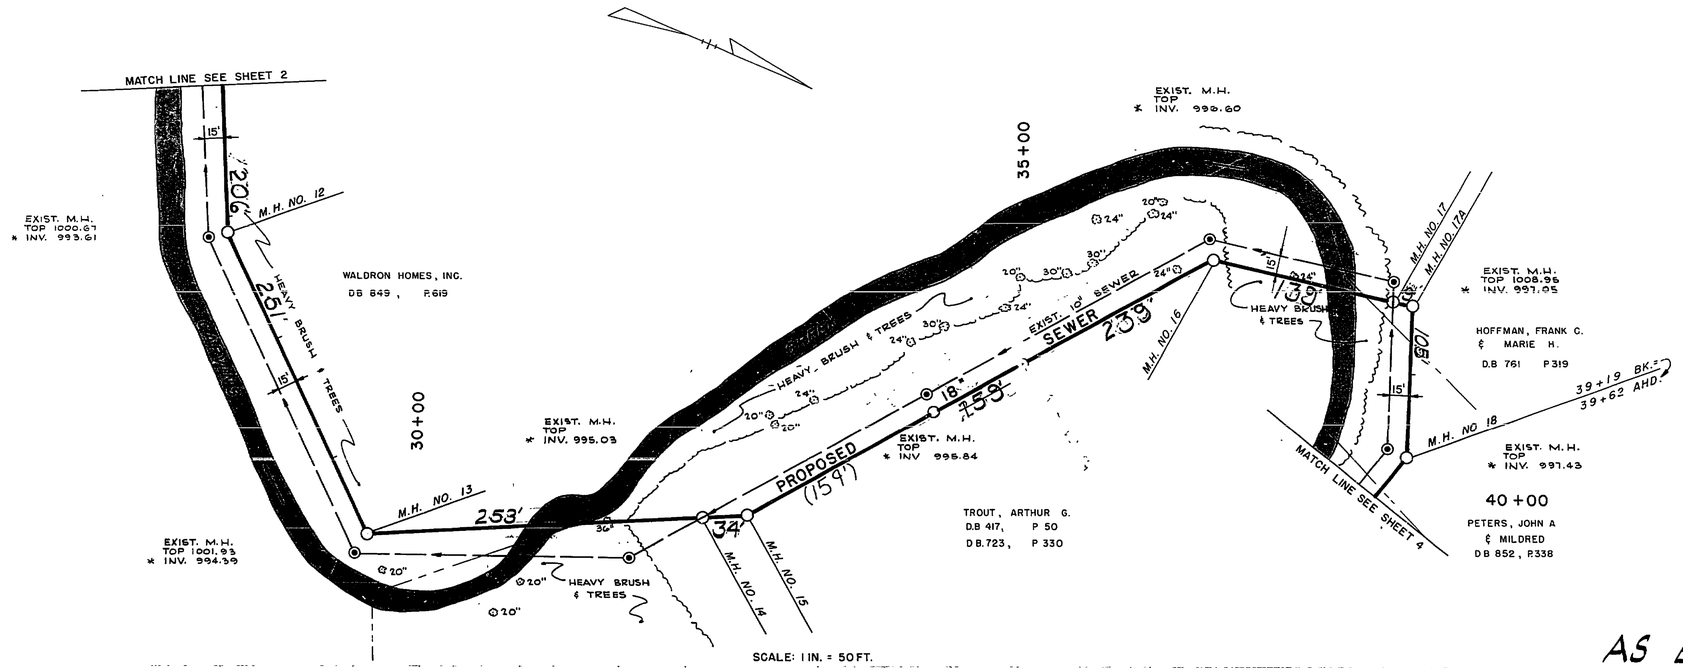

AS BUILT VOID

SCALE: 1 IN. = 50 FT.

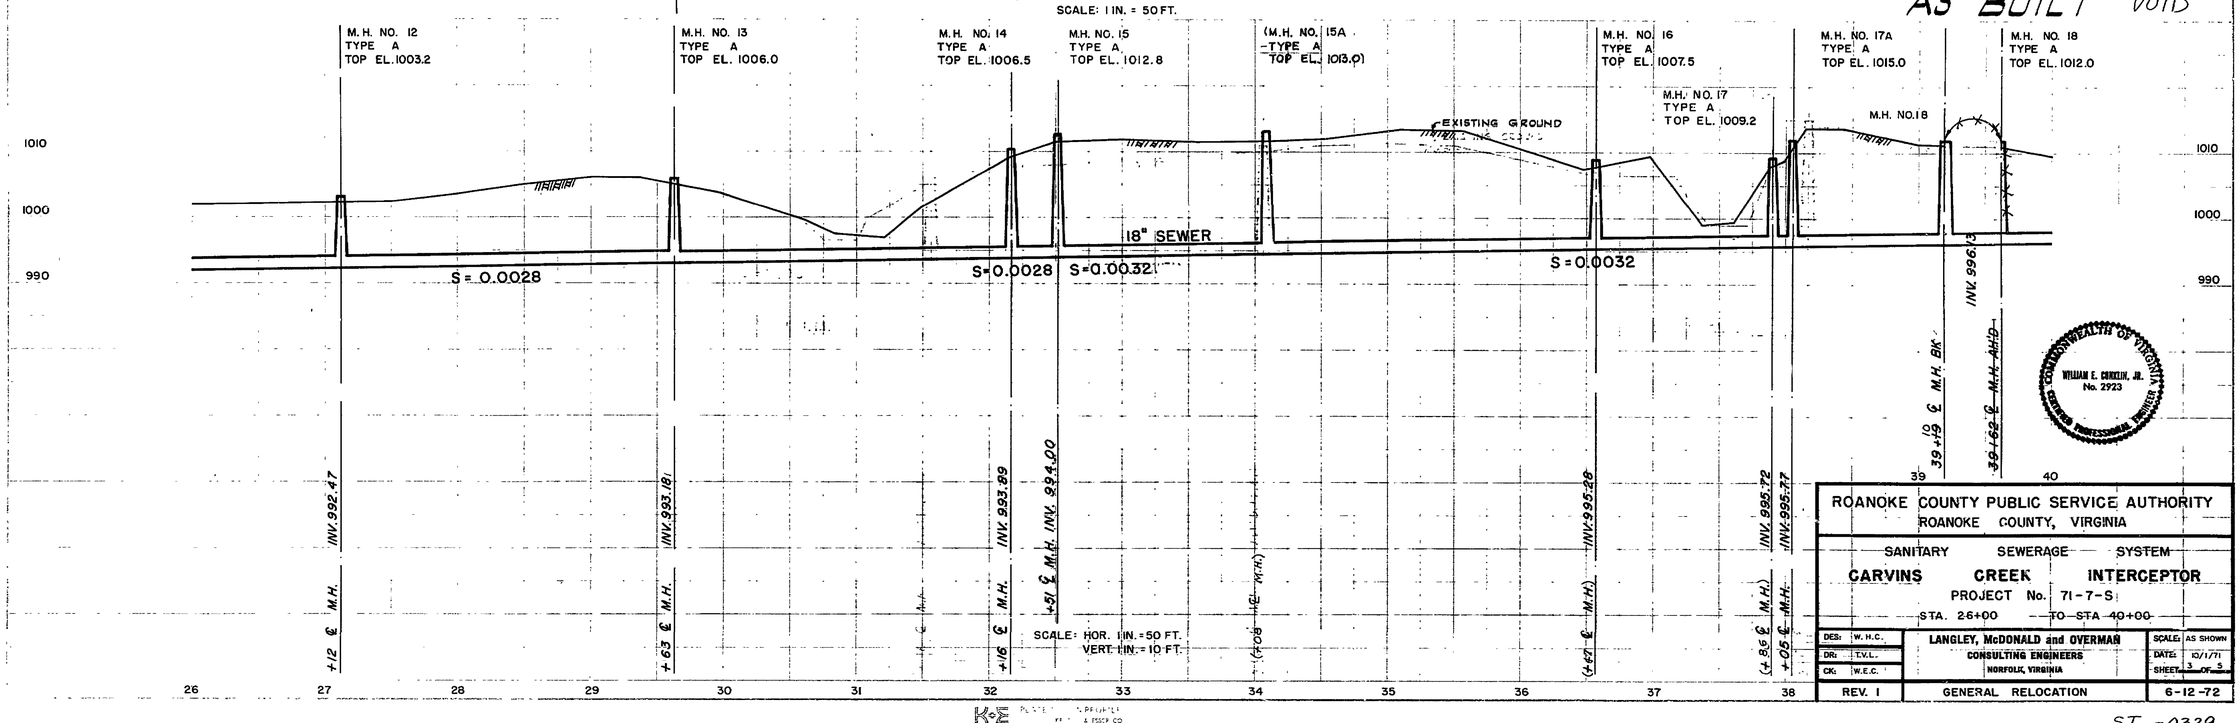

COMMONWEALTH OF VIRGINIA
WILLIAM E. CONKLIN, JR.
No. 2923
CERTIFIED PROFESSIONAL ENGINEER

ROANOKE COUNTY PUBLIC SERVICE AUTHORITY ROANOKE COUNTY, VIRGINIA			
SANITARY SEWERAGE SYSTEM CARVINS CREEK INTERCEPTOR PROJECT No. 71-7-S STA. 26+00 TO STA 40+00			
DES: W.H.C. DR: T.V.L. CK: W.E.C.	LANGLEY, McDONALD and OVERMAN CONSULTING ENGINEERS NORFOLK, VIRGINIA	SCALE: AS SHOWN DATE: 10/1/71 SHEET 3 OF 5	
REV. 1	GENERAL RELOCATION	6-12-72	

SI -0329
3429