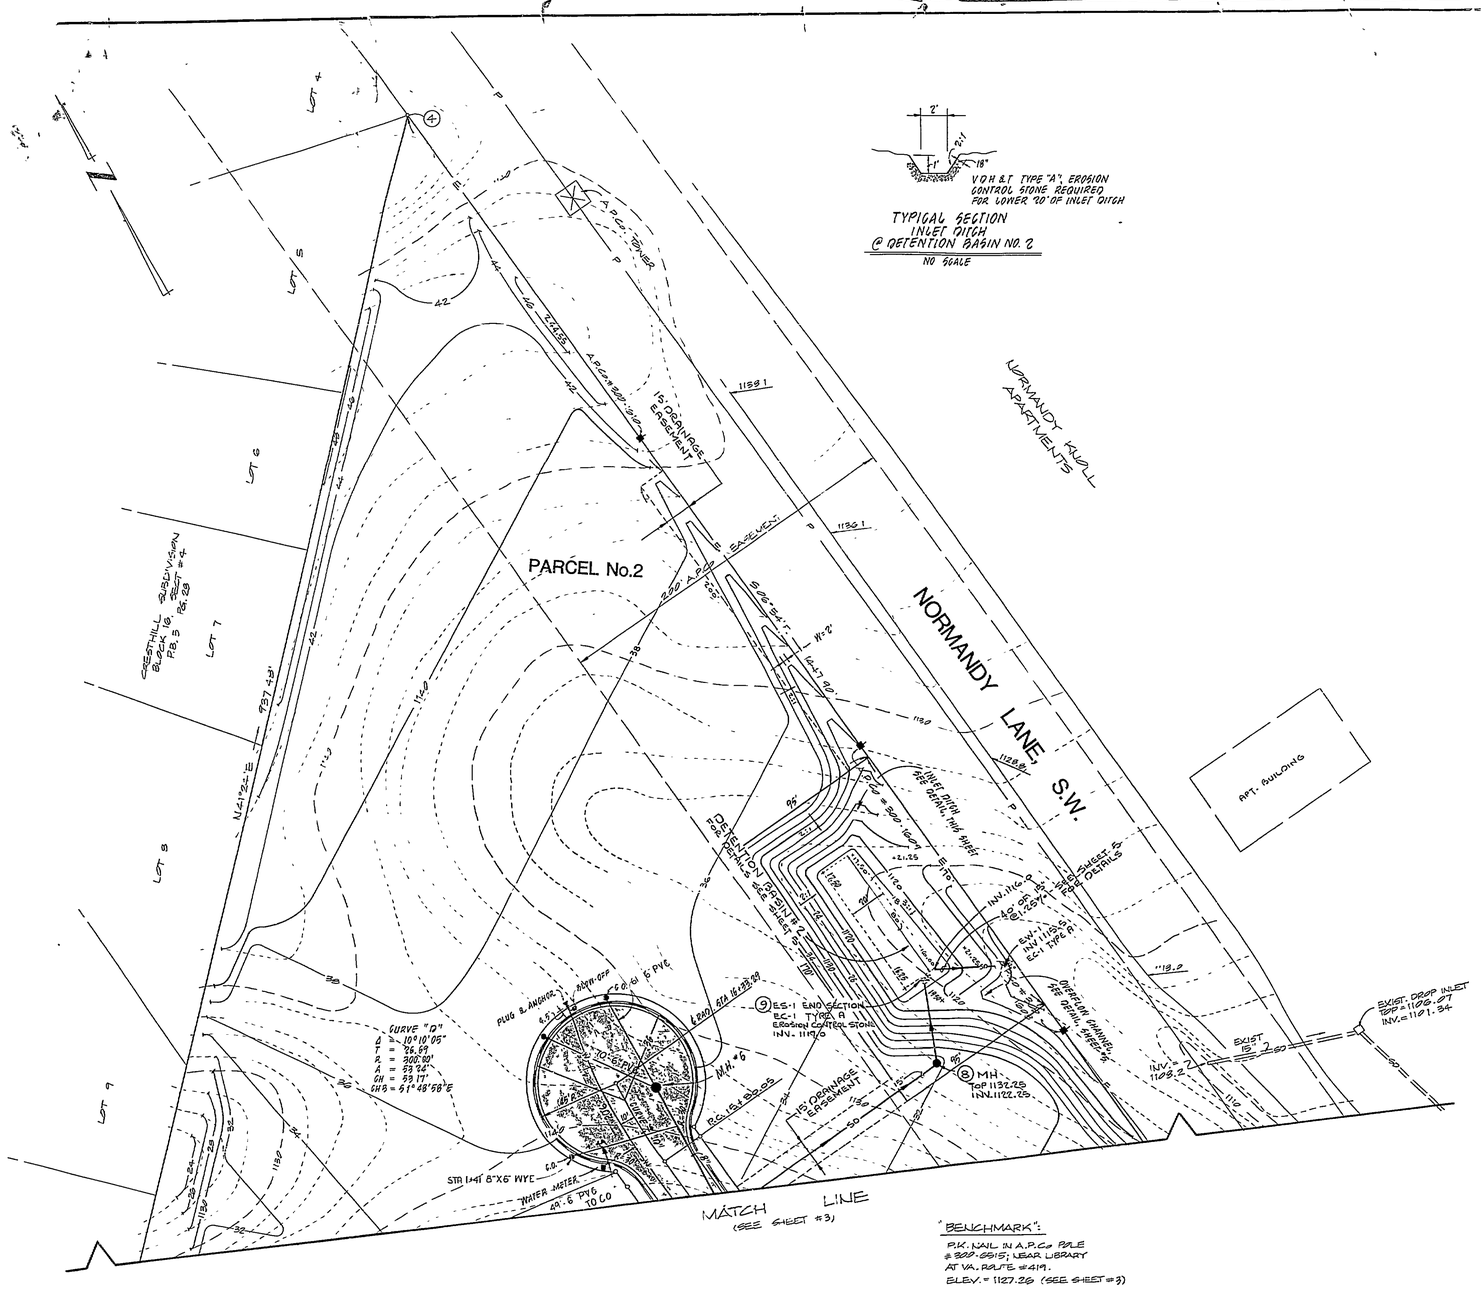

V.D.H. & T. TYPE "A", EROSION CONTROL STONE REQUIRED FOR LOWER 20' OF INLET DITCH

TYPICAL SECTION
INLET DITCH
@ DETENTION BASIN NO. 2
NO SCALE

NOTES:
1. SEE SHEET #5 FOR PROFILES.
2. SEE SHEET #3 FOR LEGEND.

"BENCHMARK":
P.K. NAIL IN A.P.Co. POLE #309-5915; NEAR LIBRARY AT VA. ROUTE #419.
ELEV. = 1127.26 (SEE SHEET #3)

NOTE: "AS-BUILT" INFORMATION FURNISHED BY THE CONTRACTOR, J.P. TURNER & BROS PIPELINE CONTRACTORS DATED 8 SEPT 1986

AS - BUILT

SITE PLAN (NORTH)

FOR

CAVE SPRING OFFICE PARK

RC-3284

ROANOKE COUNTY VIRGINIA

SCALE: 1" = 30' DATE: 1 MARCH 1984
11 OCT. 1985
REVISED: 27 JANUARY 1986
SHORTENED CUL-DE-SAC FROM STA. 17+49.50 TO STA. 16+93.09 AND ADJUSTED UTILITIES ACCORDINGLY.
AS BUILT SAN SEWER & WATER 8 SEPT. 1986
FINAL AS-BUILT - 2 MAR 1987

OWNERS:
CAVE SPRING OFFICE PARK
& VIRGINIA GENERAL PARTNERSHIP

BUFORD T. LUNSDEN & ASSOCIATES P.C.
ENGINEERS - SURVEYORS
ROANOKE VIRGINIA

RC-3284

73-150

SHEET #4