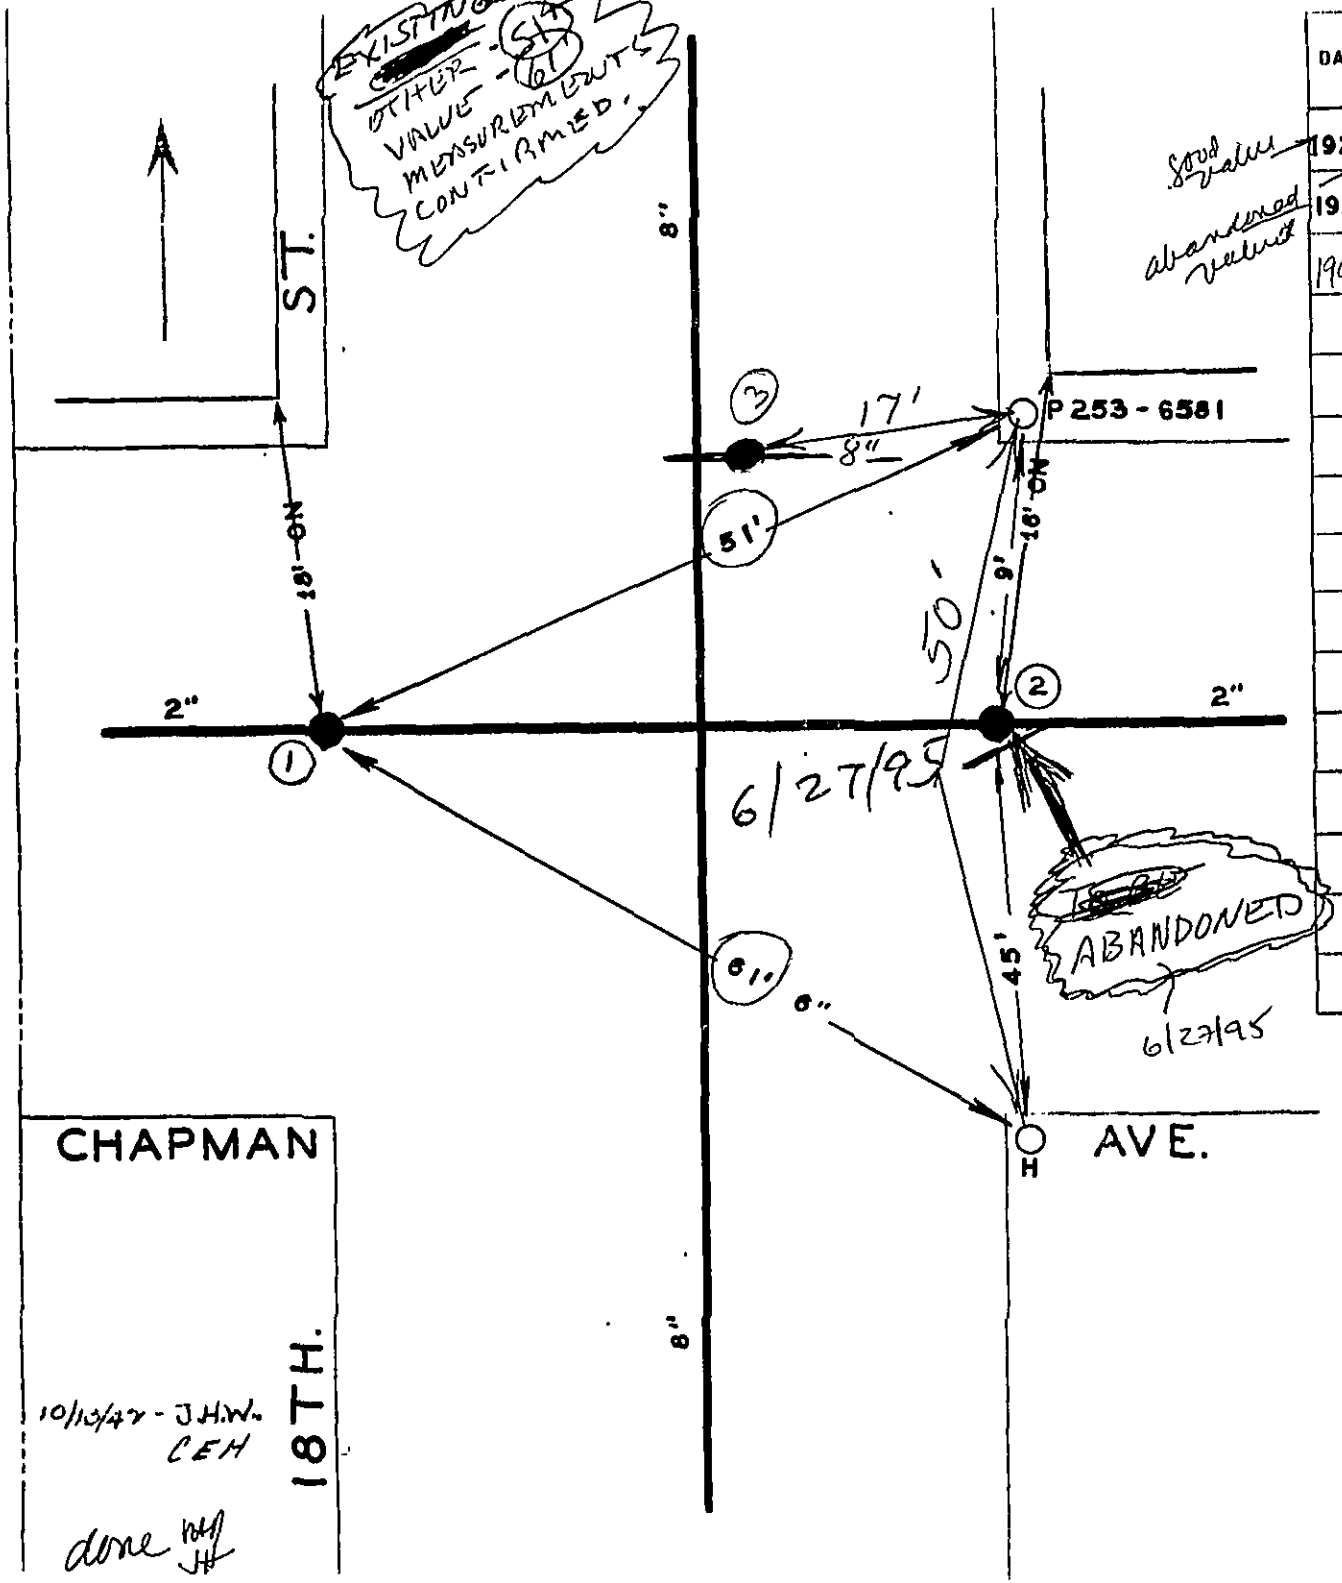

DATE	NO	SIZE	MAKE	OPEN	TURNS
1922	1	2"	~~Bitsfl Clow~~	R	7
1922	2	2"	~~abandoned GOOD~~	R	7
1995	3	8"	MUELLER	R	27
	1	0	WPL		
	2	0	EPL		

Good valve
abandoned valve

CITY OF ROANOKE—WATER DEP'T
VALVE DIAGRAM
CHAPMAN AVE. & 18TH. ST. S.W.

SEC. MAP 121

DATE PAGE NO S.W. 189