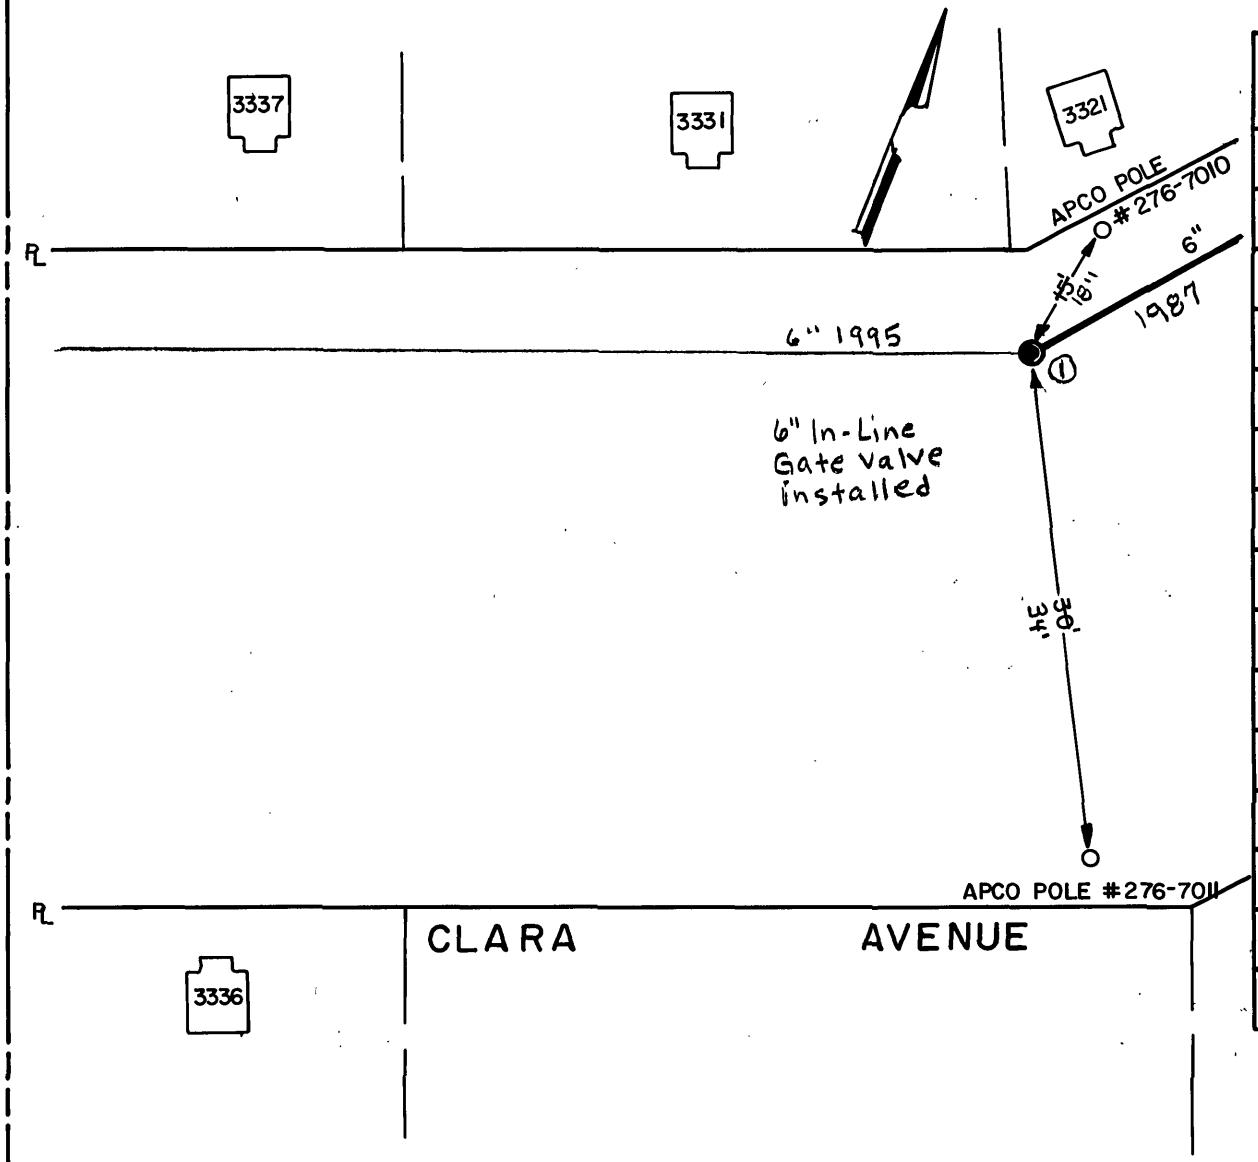

DATE	NO.	SIZE	MAKE	OPEN	TURNS
~~1987~~	~~1~~	~~2"~~	~~BLOW OFF~~	~~R~~	
1995	1	6"		R	27

CITY OF ROANOKE - WATER DEP'T.

VALVE DIAGRAM

CLARA AVENUE

SEC. MAP 505 S.W.

DATE: PAGE NO.

6/94 NP