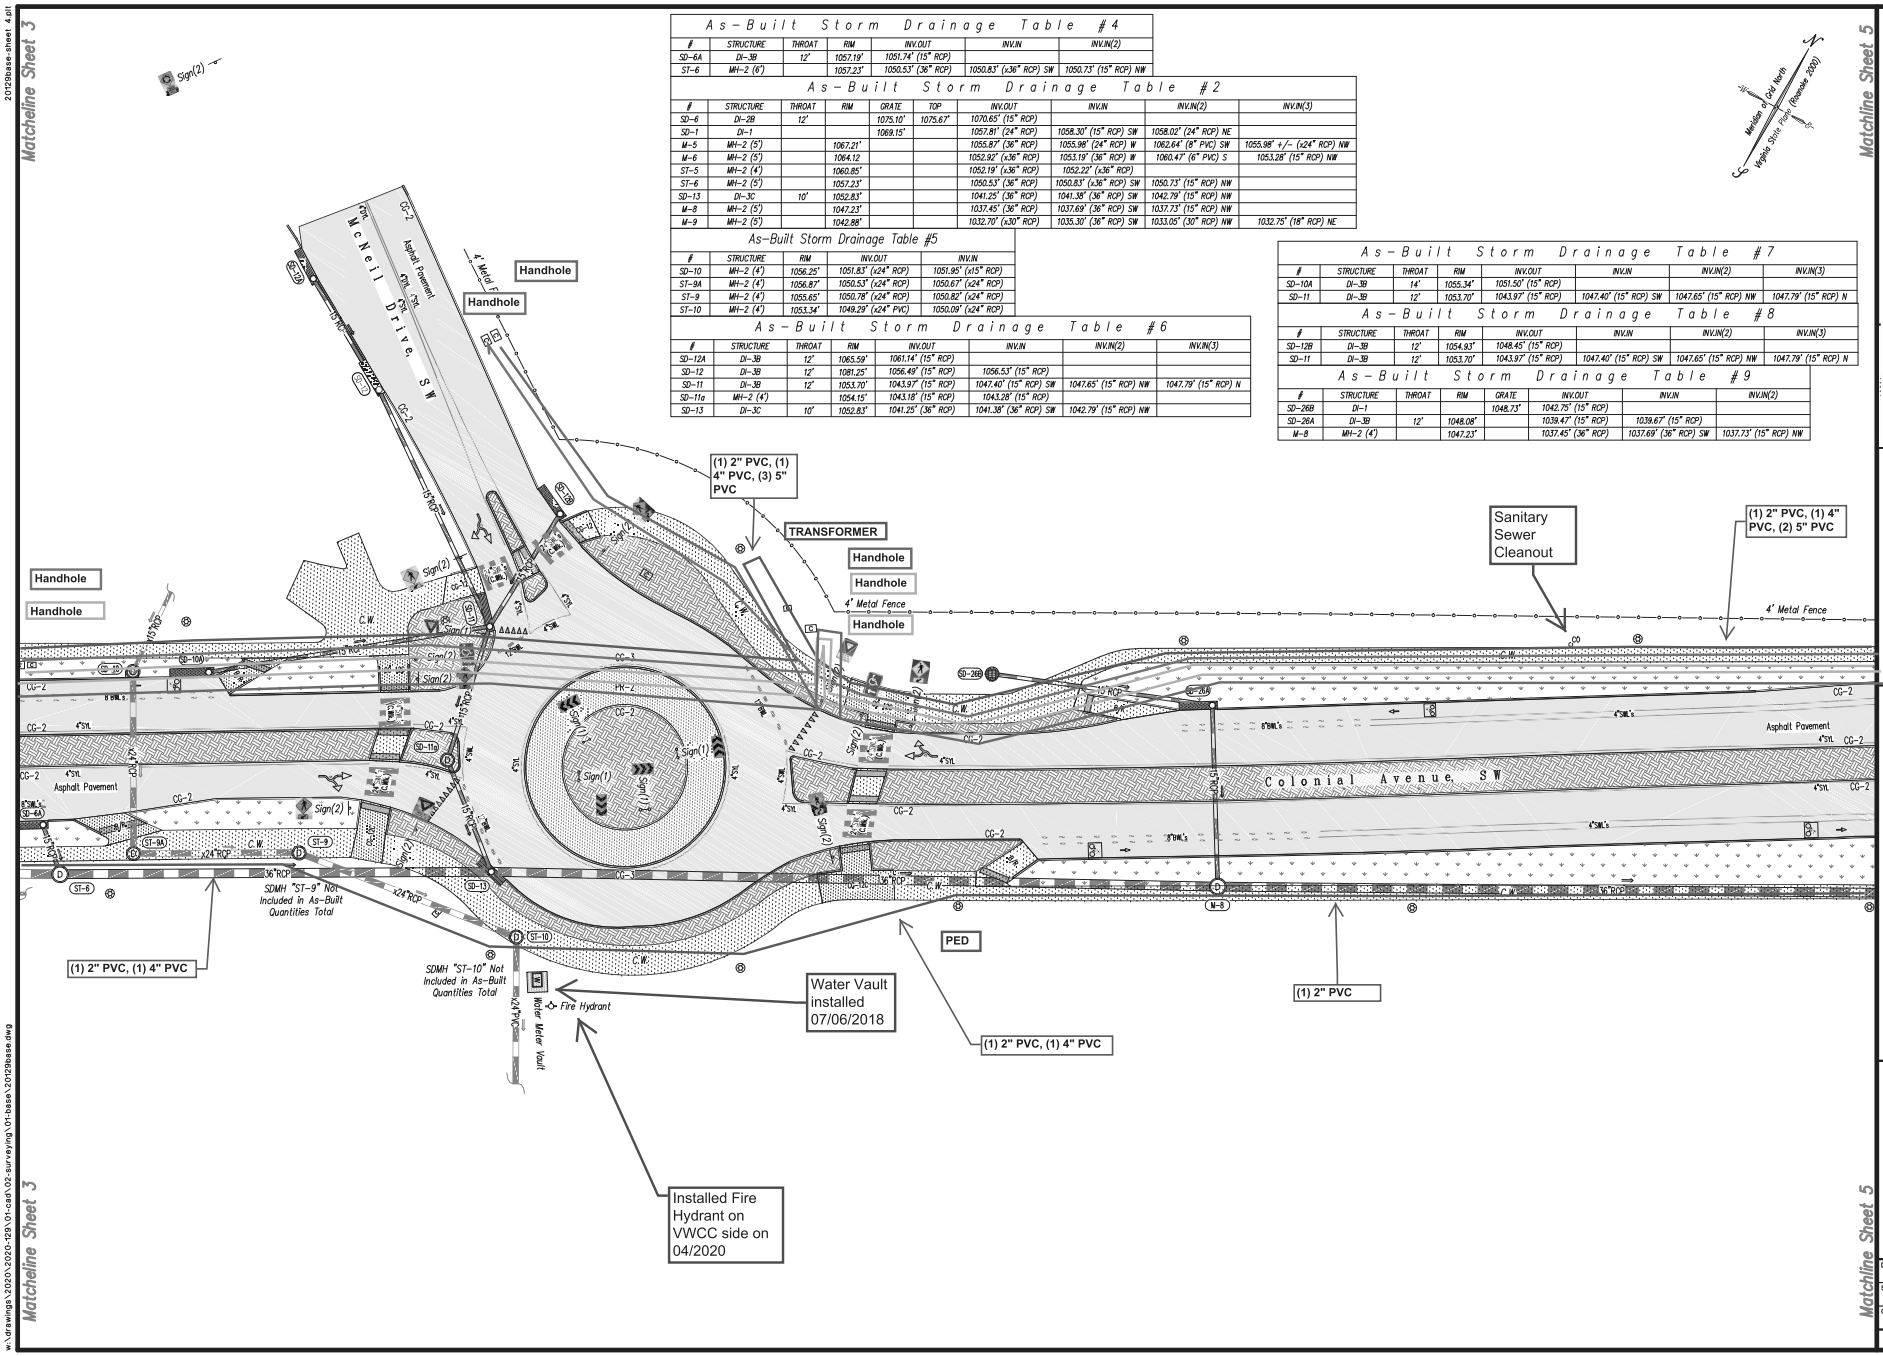

As-Built Storm Drainage Table #4

#	STRUCTURE	THROAT	RIM	INV.OUT	INV.IN	INV.IN(2)
SD-6A	DI-3B	12'	1057.19'	1051.74' (15" RCP)		
ST-6	MH-2 (6')		1057.23'	1050.53' (36" RCP)	1050.83' (x36" RCP) SW	1050.73' (15" RCP) NW

As-Built Storm Drainage Table #2

#	STRUCTURE	THROAT	RIM	GRATE	TOP	INV.OUT	INV.IN	INV.IN(2)	INV.IN(3)
SD-6	DI-2B	12'		1075.10'	1075.67'	1070.65' (15" RCP)			
SD-1	DI-1			1069.15'		1057.81' (24" RCP)	1058.30" (15" RCP) SW	1058.02' (24" RCP) NE	
M-5	MH-2 (5')		1067.21'			1055.87' (36" RCP)	1055.98' (24" RCP) W	1062.64' (6" PVC) SW	1055.98' +/- (x24" RCP) NW
M-6	MH-2 (5')		1064.12			1052.92' (x36" RCP)	1053.19' (36" RCP) W	1060.47' (6" PVC) S	1053.28' (15" RCP) NW
ST-5	MH-2 (4')		1060.85'			1052.19' (x36" RCP)	1052.22' (x36" RCP)		
ST-6	MH-2 (6')		1057.23'			1050.53' (36" RCP)	1050.83' (x36" RCP) SW	1050.73' (15" RCP) NW	
SD-13	DI-3C	10'	1052.83'			1041.25' (36" RCP)	1041.38' (36" RCP) SW	1042.79' (15" RCP) NW	
M-8	MH-2 (5')		1047.23'			1037.45' (36" RCP)	1037.69' (36" RCP) SW	1037.73' (15" RCP) NW	
M-9	MH-2 (5')		1042.88'			1032.70' (x30" RCP)	1035.30' (36" RCP) SW	1033.05' (30" RCP) NW	1032.75' (18" RCP) NE

As-Built Storm Drainage Table #5

#	STRUCTURE	RIM	INV.OUT	INV.IN
SD-10	MH-2 (4')	1056.25'	1051.83' (x24" RCP)	1051.95' (x15" RCP)
ST-9A	MH-2 (4')	1056.87'	1050.53' (x24" RCP)	1050.67' (x24" RCP)
ST-9	MH-2 (4')	1055.65'	1050.78" (x24" RCP)	1050.82' (x24" RCP)
ST-10	MH-2 (4')	1053.34'	1049.29" (x24" PVC)	1050.09' (x24" RCP)

As-Built Storm Drainage Table #6

#	STRUCTURE	THROAT	RIM	INV.OUT	INV.IN	INV.IN(2)	INV.IN(3)
SD-12A	DI-3B	12'	1065.59'	1061.14' (15" RCP)			
SD-12	DI-3B	12'	1081.25'	1056.49' (15" RCP)	1056.53" (15" RCP)		
SD-11	DI-3B	12'	1053.70'	1043.97' (15" RCP)	1047.40' (15" RCP) SW	1047.65' (15" RCP) NW	1047.79' (15" RCP) N
SD-11a	MH-2 (4')		1054.15'	1043.18' (15" RCP)	1043.28" (15" RCP)		
SD-13	DI-3C	10'	1052.83'	1041.25' (36" RCP)	1041.38" (36" RCP) SW	1042.79' (15" RCP) NW	

As-Built Storm Drainage Table #7

#	STRUCTURE	THROAT	RIM	INV.OUT	INV.IN	INV.IN(2)	INV.IN(3)
SD-10A	DI-3B	14'	1055.34'	1051.50" (15" RCP)			
SD-11	DI-3B	12'	1053.70'	1043.97" (15" RCP)	1047.40" (15" RCP) SW	1047.65" (15" RCP) NW	1047.79' (15" RCP) N

As-Built Storm Drainage Table #8

#	STRUCTURE	THROAT	RIM	INV.OUT	INV.IN	INV.IN(2)	INV.IN(3)
SD-12B	DI-3B	12'	1054.93'	1048.45" (15" RCP)			
SD-11	DI-3B	12'	1053.70'	1043.97" (15" RCP)	1047.40" (15" RCP) SW	1047.65" (15" RCP) NW	1047.79" (15" RCP) N

As-Built Storm Drainage Table #9

#	STRUCTURE	THROAT	RIM	GRATE	INV.OUT	INV.IN	INV.IN(2)
SD-26B	DI-1			1048.73'	1043.75' (15" RCP)		
SD-26A	DI-3B	12'	1048.08'		1039.47' (15" RCP)	1039.67' (15" RCP)	
M-8	MH-2 (4')		1047.23'		1037.45' (36" RCP)	1037.69' (36" RCP) SW	1037.73' (15" RCP) NW

Construction As-Built Survey of a portion of Colonial Avenue S W situated along Colonial Avenue, SW from the intersection of Winding Way Road, SW running easterly to the intersection with Clearfield Road, SW Roanoke, Virginia prepared for The City of Roanoke, Virginia

REVISIONS NO.	DATE	DESCRIPTION
1		
2		
3		
4		
5		

DATE: September 29, 2020
SCALE: None
COMMISSION NO.: 2020-129
SHEET 4 OF 7

w:\drawings\2020\2020-129\01-cad\02-survey\01-base\20129base.dwg
20129base-sheet 4.plt