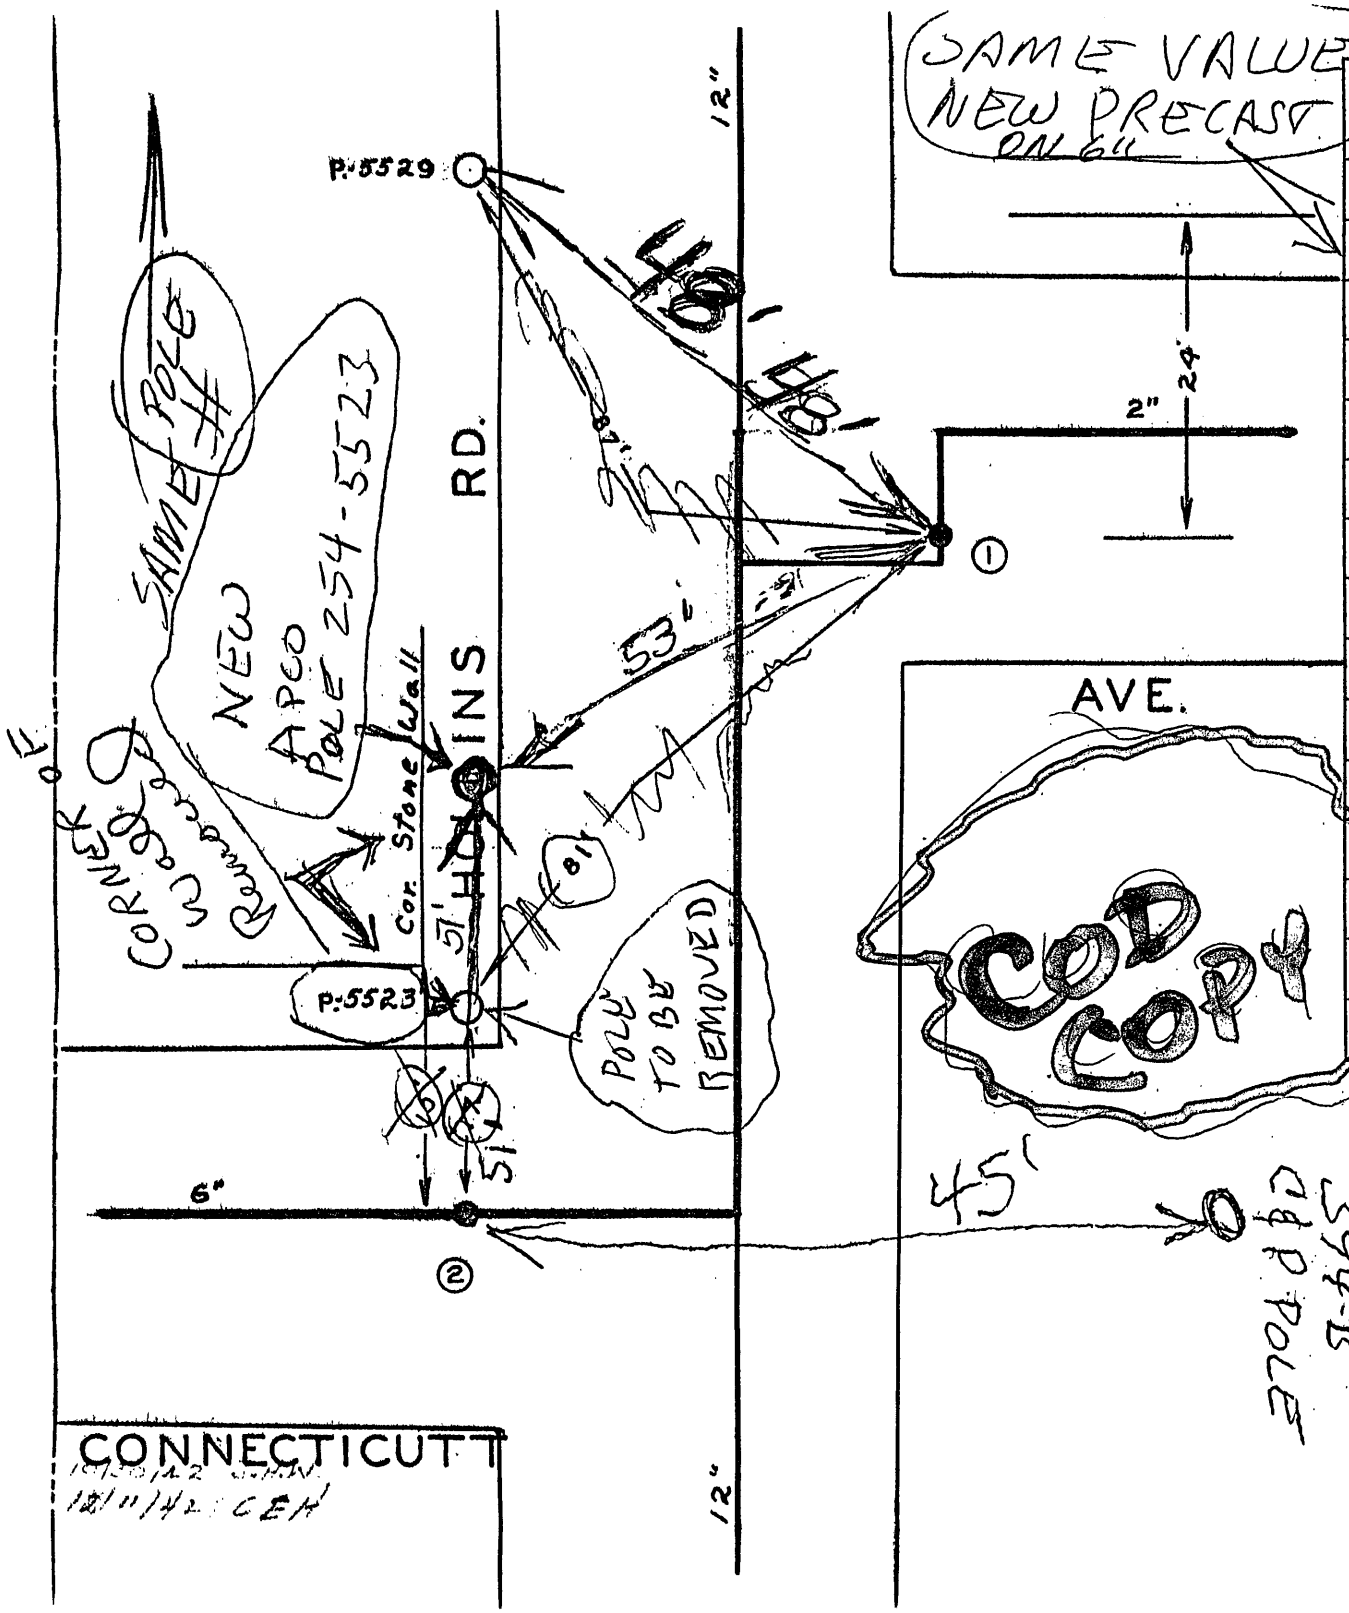

DATE	NO.	SIZE	MAKE	OPEN	TURNS
1929	1	2"		L	7
	2	6"	MUELLER	R	20
	1	0	E PL		
	2	0	WPL		

CITY OF ROANOKE—WATER DEP'T
VALVE DIAGRAM
CONNECTICUT AVE. & HOLLINS RD. N. E.

SEC. MAP 304

DATE PAGE NO. NE 71