DATE	NO.	SIZE	MAKE	OPEN	TURNS
74	1	6"	MUELLER	R	

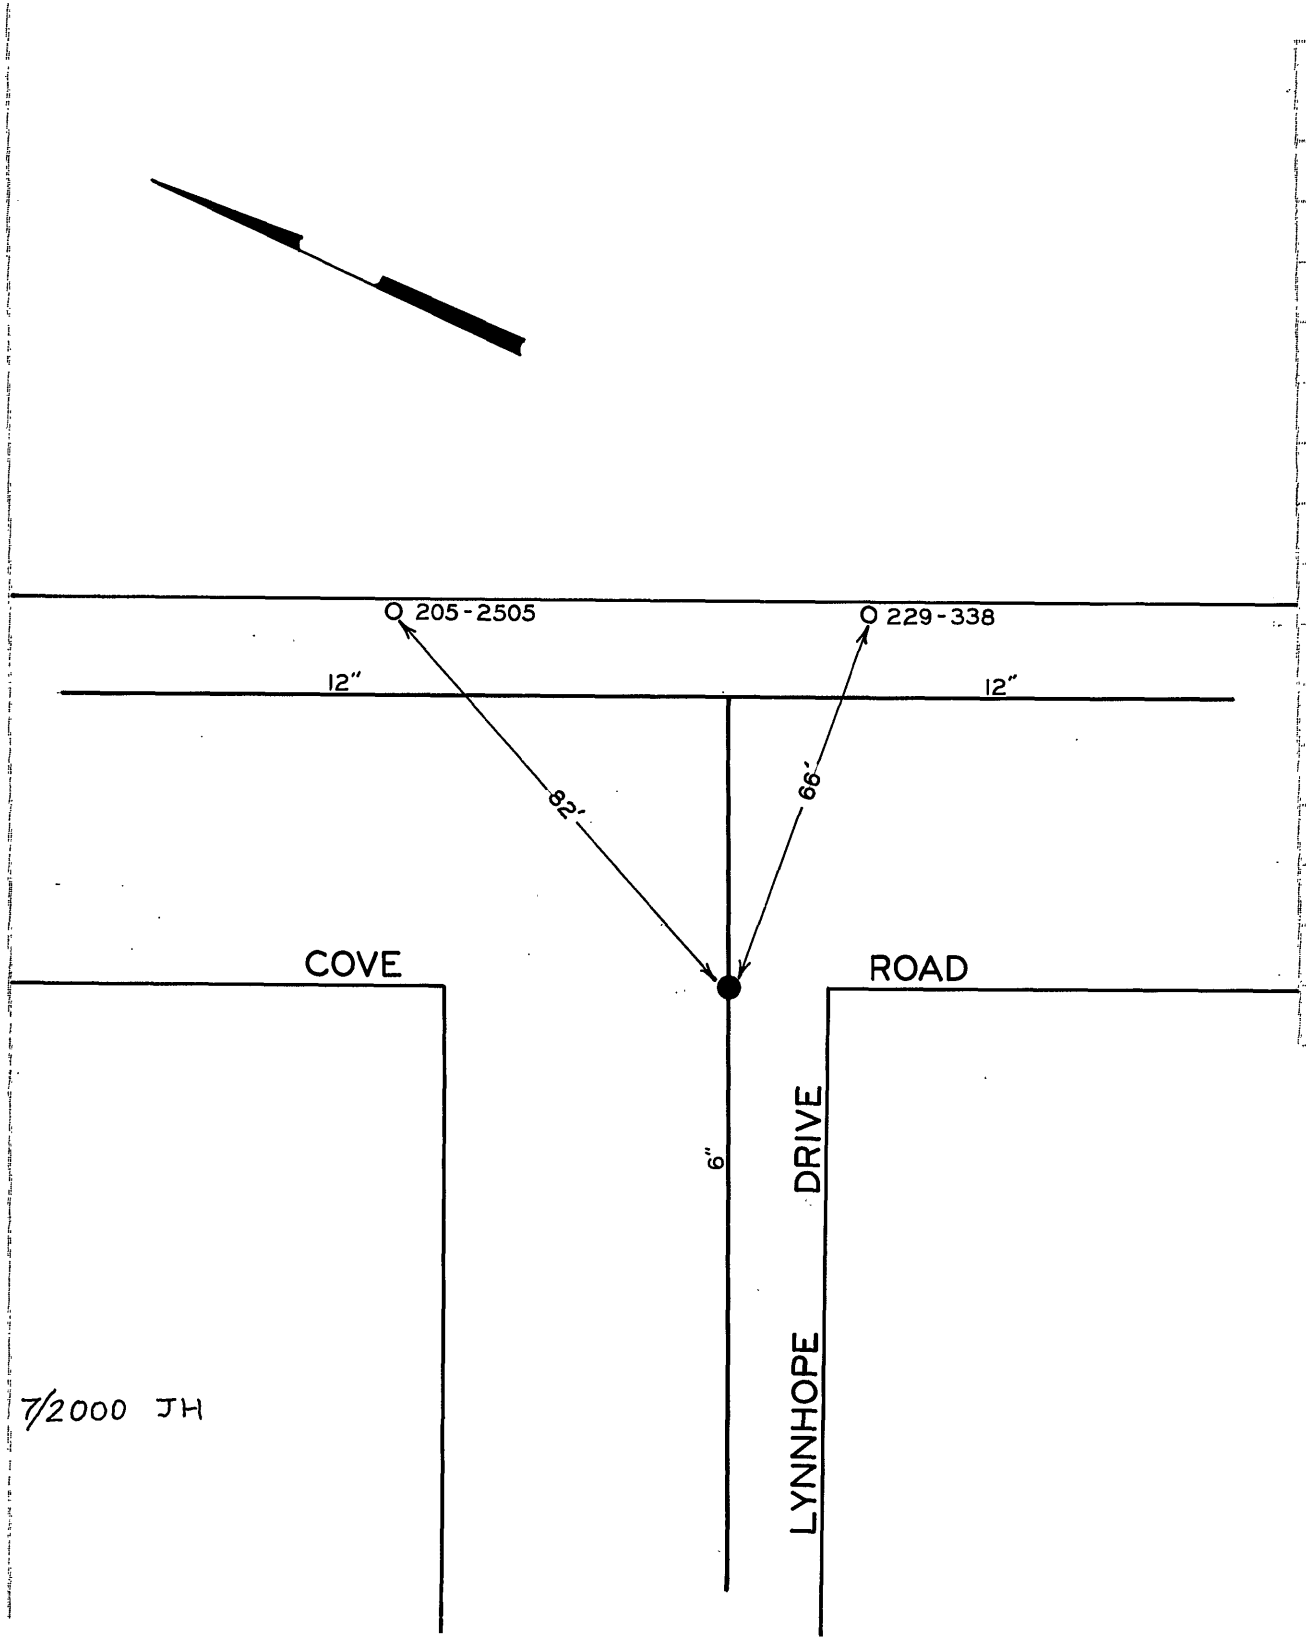

VALVE DIAGRAM

COVE ROAD &
LYNNHOPE DRIVE N.W.

SQ. FT. 640

DATE PAGE NO.