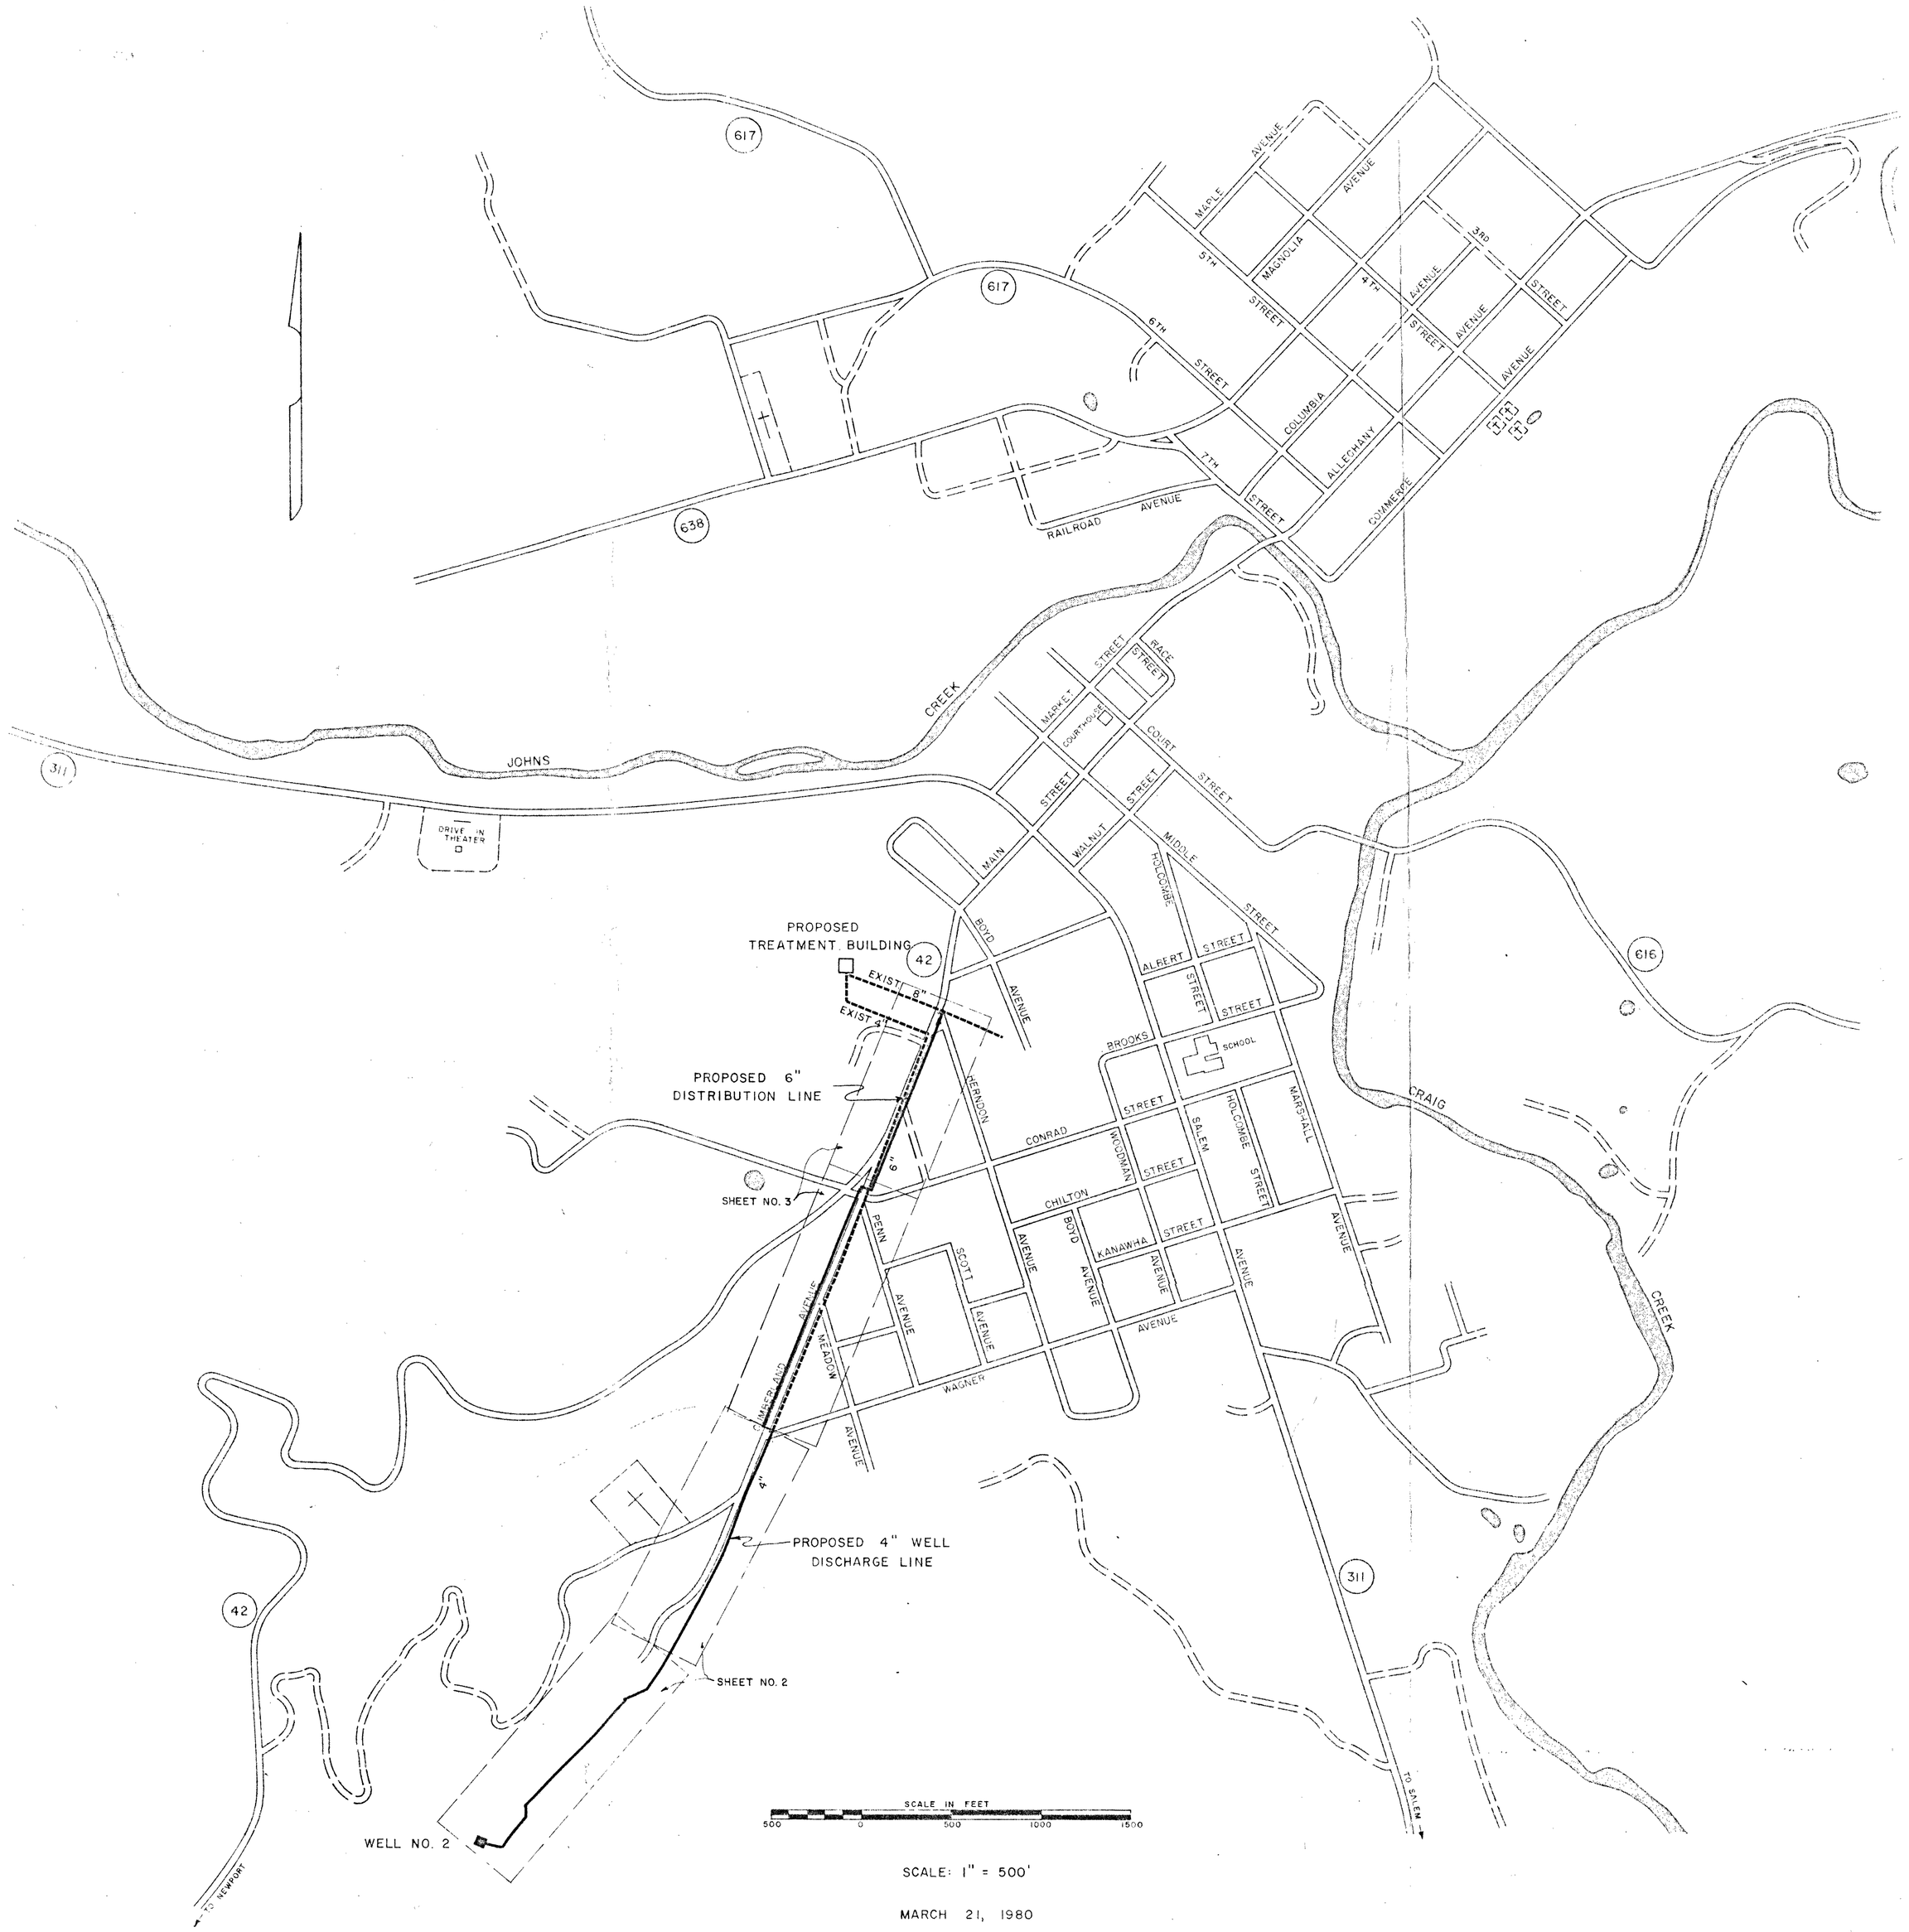

SCALE: 1" = 500'

MARCH 21, 1980

WATER SYSTEM IMPROVEMENTS

CRAIG - NEW CASTLE

PUBLIC SERVICE AUTHORITY

CRAIG COUNTY, VIRGINIA

PHASE I

SOURCE IMPROVEMENTS

LIST OF DRAWINGS

1. TITLE SHEET
2. 4" WELL DISCHARGE LINE
3. 6" DISTRIBUTION MAIN
4. SITE PLAN RESERVOIR
5. TREATMENT BUILDING
6. PIPING AND ELECTRICAL PLAN
7. RESERVOIR DETAILS
8. SANITARY SEWER OUTFALL

APPROVED FOR CONSTRUCTION

DATE	C.R. BOITNOTT, CHAIRMAN CRAIG - NEW CASTLE PSA

RECORD DRAWINGS

ANDERSON & ASSOCIATES
CONSULTING ENGINEERS
100 ARDMORE STREET
BLACKSBURG, VA. 24060

ANDERSON & ASSOCIATES, INC.
CONSULTING ENGINEERS
BLACKSBURG, VIRGINIA